


NE 1/4 SEC. 22, T. 33 S, R. 6 W., W.M.
SE 1/4 SEC. 22, T. 33 S, R. 6 W., W.M.

COUNTY SURVEYORS FILE DATA
DO NOT REMOVE FROM OFFICE

FILED
Date: 10-19-2010 By: JC
This survey consists of:
Map: ST HWY
Narrative: 15-024
Corner Rpt: A-GG
DOUGLAS COUNTY
SURVEYOR

LEGEND	
-----	PROTRACTED LOT LINE
-----	EDGE OF PAVEMENT
-----	RIGHT-OF-WAY
-----	PROPERTY LINE
(1234)	COMPUTED R/W POINT
★	SET GPS POINT
▲	SET NETWORK POINT
○	FOUND MONUMENT
()	RECORD DATA (8B-30-1)
[]	RECORD DATA (8B-29-21)

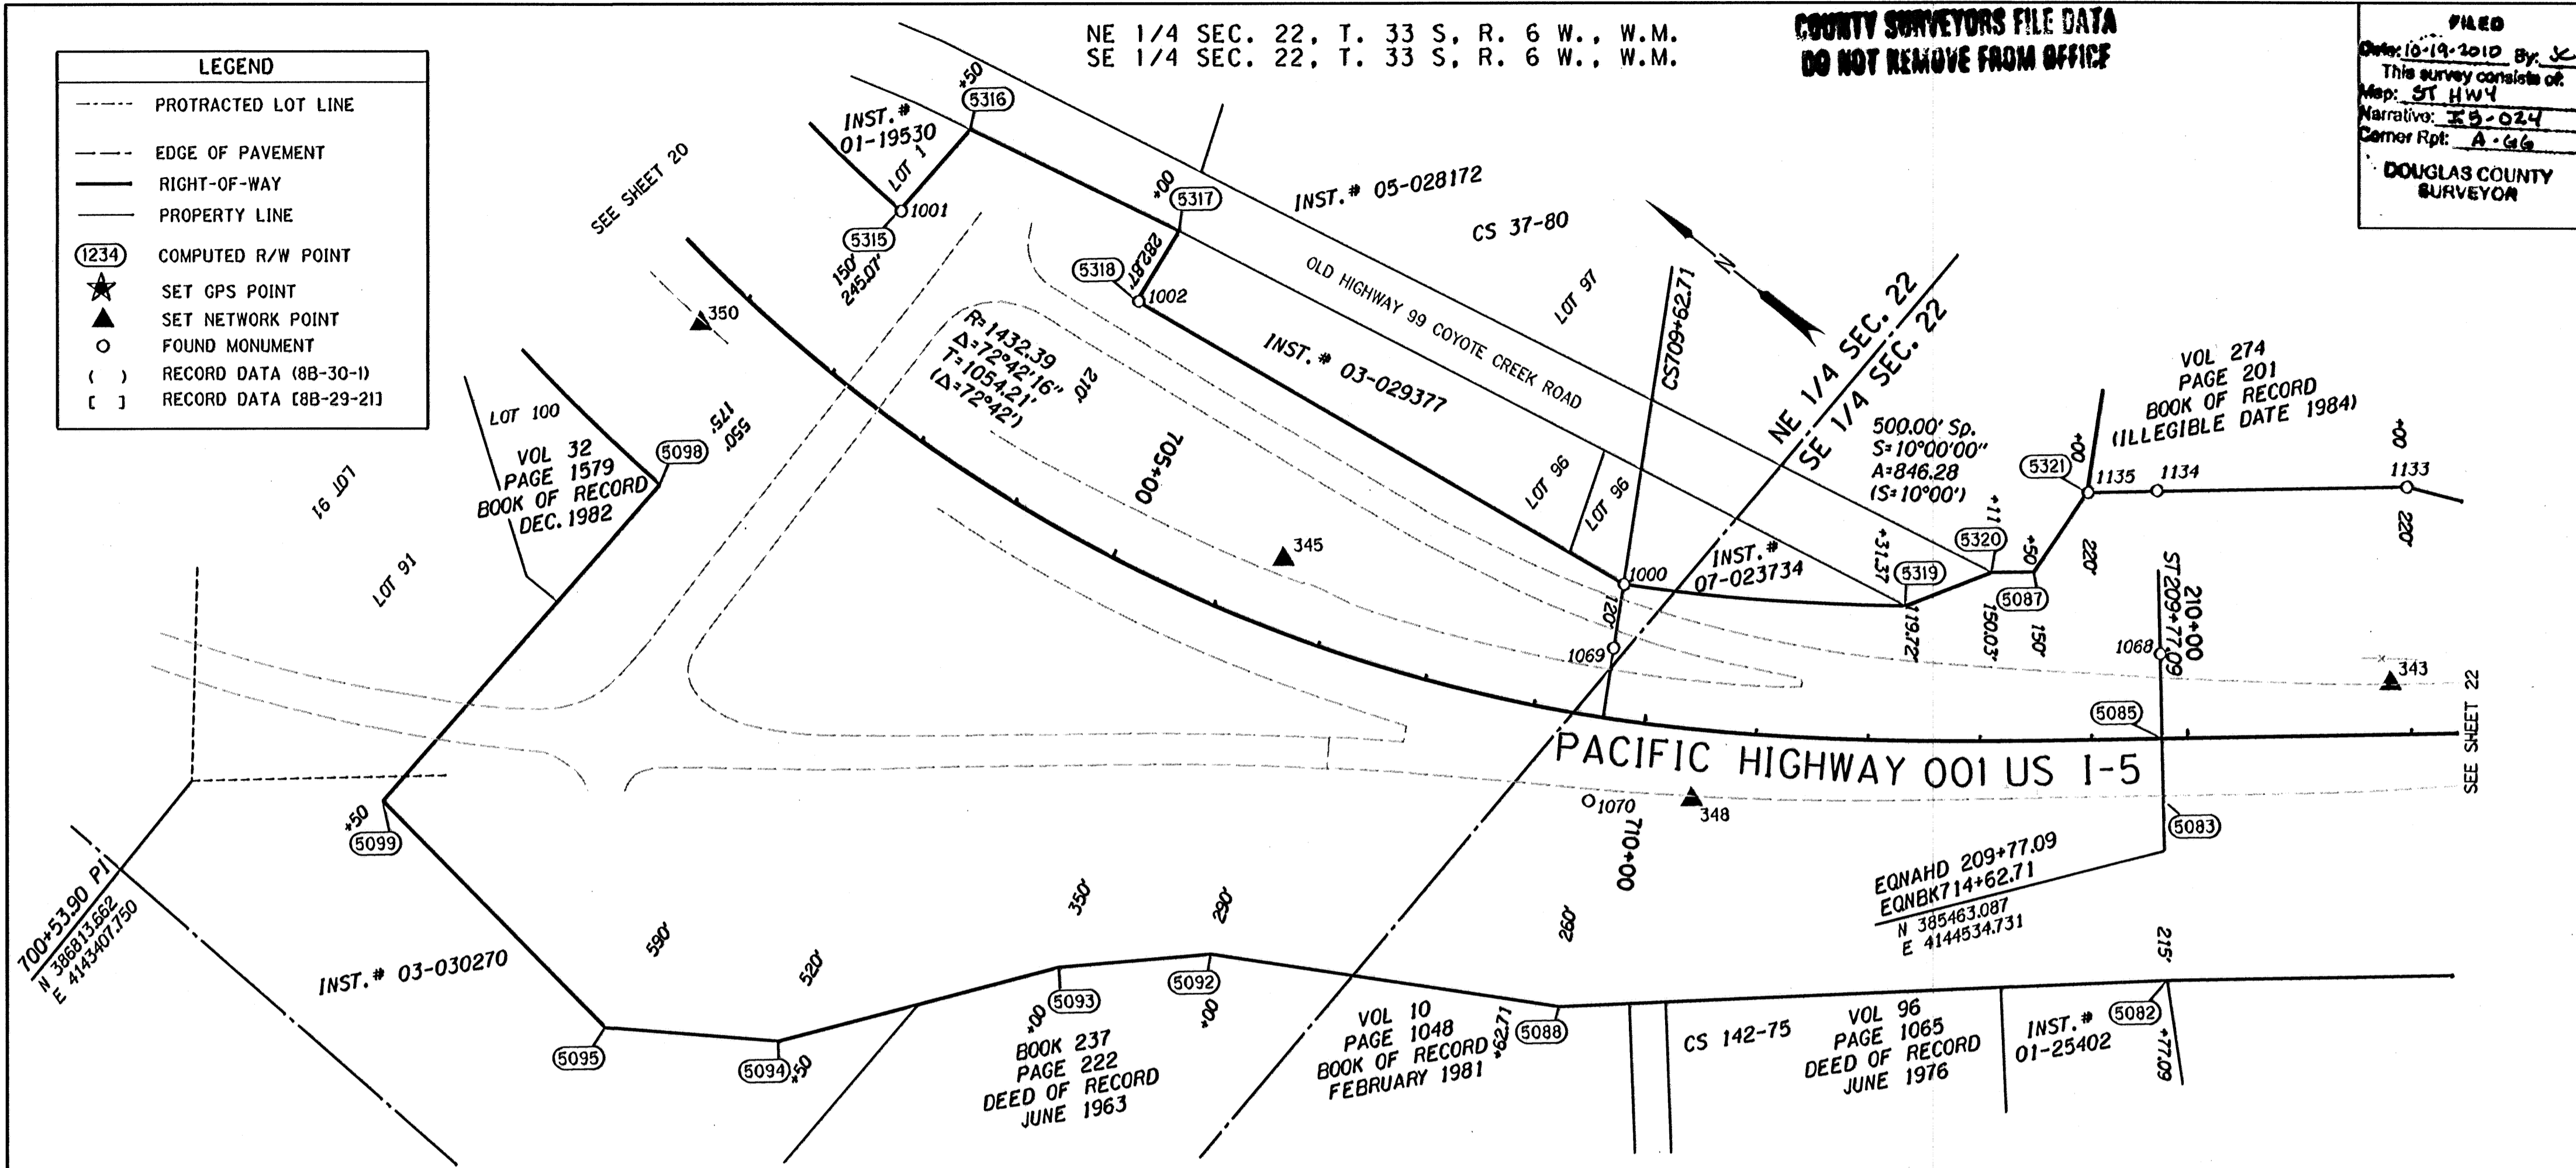


W/=WITH, IP=IRON PIPE, IR=IRON ROD, YPC=YELLOW PLASTIC CAP, DRG=ODOT DRAWING B=BOOK P=PAGE
AC=ALUMINUM CAP, CSNI= COUNTY SURVEY NOT IDENTIFIED

RECOVERED MONUMENTS AND COMPUTED POINTS LIST

PT. NO.	LDP NORTHING	LDP EASTING	STATION	OFFSET	DATE	DESCRIPTION & REFERENCE DOCUMENTS
1000	385923.82	4144342.02	709+63.16	120.09 LT	11/10/2009	FOUND 5/8" IR W/ 1 1/2" AC, "OREGON STATE HWY DEPT", DOWN 0.4', ODOT 8B-30-1, CS 37-80
1001	386635.39	4144199.42	701+51.60	150.40 LT	11/10/2009	FOUND 5/8" IR W/ 1 1/2" AC, "OREGON STATE HWY DEPT", FLUSH, ODOT 8B-30-1, PP 2003-021, CS 37-80
1002	386419.71	4144268.81	704+01.85	210.91 LT	11/10/2009	FOUND 5/8" IR W/ 1 1/2" AC, "OREGON STATE HWY DEPT", UP 0.45', ODOT 8B-30-1, CS 37-80
1068	385511.12	4144592.70	209+77.35	75.28 LT	01/27/2010	FOUND RR SPIKE W/ PUNCH IN CONCRETE, DOWN 0.2', ORIGIN UNKNOWN
1069	385895.74	4144291.85	709+62.51	62.61 LT	01/27/2010	FOUND 5/8" IR W/ 1 1/2" AC, "OREG STA DIV", REMAINDER OF CAP ILLEGIBLE, DOWN 0.1', ORIGIN UNKNOWN
1070	385828.46	4144171.61	709+61.12	75.17 LT	01/27/2010	FOUND 5/8" IR W/ 1 1/2" AC, "OREGON STATE HIGHWAY DIV", DOWN 0.1', ORIGIN UNKNOWN
1133	385432.55	4144846.56	212+00.32	219.86 LT	02/11/2010	FOUND 1 1/2" AC, "OREGON STATE HWY DEPT", UP 0.5', ODOT 8B-30-1
1134	385604.20	4144704.29	209+77.38	220.60 LT	02/11/2010	FOUND 5/8" IR W/NO CAP, UP 0.7', ODOT 8B-30-1
1135	385651.03	4144664.55	714+01.00	220.03 LT	02/11/2010	FOUND 1 1/2" AC, "OREGON STATE HWY DEPT", ODOT 8B-30-1
5082	385325.34	4144369.65	209+77.09	215.00 RT		CALCULATED MONUMENT
5083	385421.93	4144492.12	209+81.39	59.08 RT		CALCULATED MONUMENT
5085	385463.09	4144534.73	209+77.09	0.00		CALCULATED MONUMENT
5087	385644.91	4144578.79	713+50.00	150.00 LT		CALCULATED MONUMENT
5088	385735.03	4144012.13	709+62.71	260.00 RT		CALCULATED MONUMENT
5092	386006.95	4143854.84	707+00.00	290.00 RT		CALCULATED MONUMENT
5093	386105.84	4143761.16	706+00.00	350.00 RT		CALCULATED MONUMENT
5094	386260.53	4143553.55	704+50.00	520.00 RT		CALCULATED MONUMENT
5095	386389.18	4143466.46	703+50.00	590.00 RT		CALCULATED MONUMENT
5098	386651.96	4143874.44	701+50.00	175.00 RT		CALCULATED MONUMENT
5099	386669.39	4143499.84	701+50.00	550.00 RT		CALCULATED MONUMENT
5315	386636.84	4144199.09	701+50.00	150.00 LT		CALCULATED MONUMENT
5316	386632.40	4144294.05	701+50.03	245.07 LT		CALCULATED MONUMENT
5317	386430.46	4144339.98	704+00.00	282.87 LT		CALCULATED MONUMENT
5318	386421.15	4144267.70	704+00.00	210.00 LT		CALCULATED MONUMENT
5319	385715.75	4144483.47	712+31.37	119.72 LT		CALCULATED MONUMENT
5320	385674.35	4144554.89	713+11.00	150.03 LT		CALCULATED MONUMENT
5321	385651.76	4144663.90	714+00.00	220.00 LT		CALCULATED MONUMENT

THIS IS TO CERTIFY THAT THIS MAP WAS PREPARED USING HP DESIGNJET 1055CM, BLACK C4820a INK ON HP MATTE FILM #51642B.

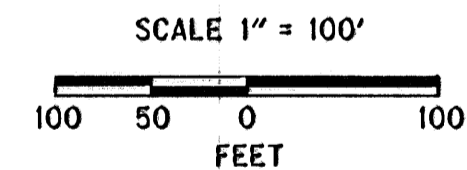

FILE NAME: 16763RET.DGN

REGISTERED PROFESSIONAL LAND SURVEYOR

David Evans

OREGON
JULY 11, 2006
JON KENNETH BROADWATER
61360LS
EXPIRES: 12/31/2011

DAVID EVANS AND ASSOCIATES INC.
530 CENTER STREET NE, SUITE 605
SALEM OREGON 97301
PHONE: 503.361.8635

OREGON DEPARTMENT OF TRANSPORTATION

HORIZONTAL CONTROL, RECOVERY, AND RETRACEMENT SURVEY
I-5: JUMPOFF JOE-GLENDALE PAVING AND CLIMBING LANES
GLENDALE TO SUNNY VALLEY
JOSEPHINE AND DOUGLAS COUNTIES

ODOT REGION 3 WHITE CITY
100 ANTELOPE ROAD
WHITE CITY, OREGON 97503

SEPTEMBER 28, 2010
SCALE: 1" = 100'
SHEET 21 OF 33

ST. HWY. I5 -024 U