



OREGON DEPARTMENT OF TRANSPORTATION
 RIGHT-OF-WAY BOUNDARY MONUMENTATION MAP
 15: DEL RIO ROAD / WINCHESTER INTERCHANGE
 PACIFIC HIGHWAY NO. 1, I-5, M.P. 128.26 - 130.53
 & OAKLAND - SHADY HIGHWAY, OR99
 DOUGLAS COUNTY

FOR ODOT REGION 3
 3500 NW. STEWART PKWY.
 ROSEBURG, OR. 97470

MAR. 30, 2015
 SCALE: 1" = 100'
 SHEET 4 OF 8

REGISTERED
 PROFESSIONAL
 LAND SURVEYOR

Marshall R. Wagstaff

OREGON
 JANUARY 9, 2001
 MARSHALL R. WAGSTAFF
 49476LS

RENEWS: JUNE 30, 2016

SE1/4 SEC. 24, T26S, R6W, W.M.

RECORD DATA	
()	COUNTY RD. PLANS (UMPOUA COLLEGE RD. NO. 284)
[]	ODOT R/W DRG. 7B-7-10 & 8B-26-7
NO	MEASURED/RESOLVED
BRACKET	SUPERCEDES RECORD

POINT LEGEND	
●	SET MONUMENT
○	FOUND MONUMENT
⊗	DESTROYED MONUMENT
□	CALCULATED POINT
⊗	DESTROYED NETWORK POINT
◇	FOUND STRATEGIC POINT
⊗	DESTROYED STRATEGIC POINT
FOR BOUNDARY LINE LEGEND SEE SHEET 2	

FILED

Date: 4-1-2015 By: JC


This survey consist of:
 Map: I5-028 A-H

Narrative: _____

Corner Rpt:
 DOUGLAS COUNTY
 SURVEYOR

SCALE 1" = 100'

100 50 0 100
 FEET

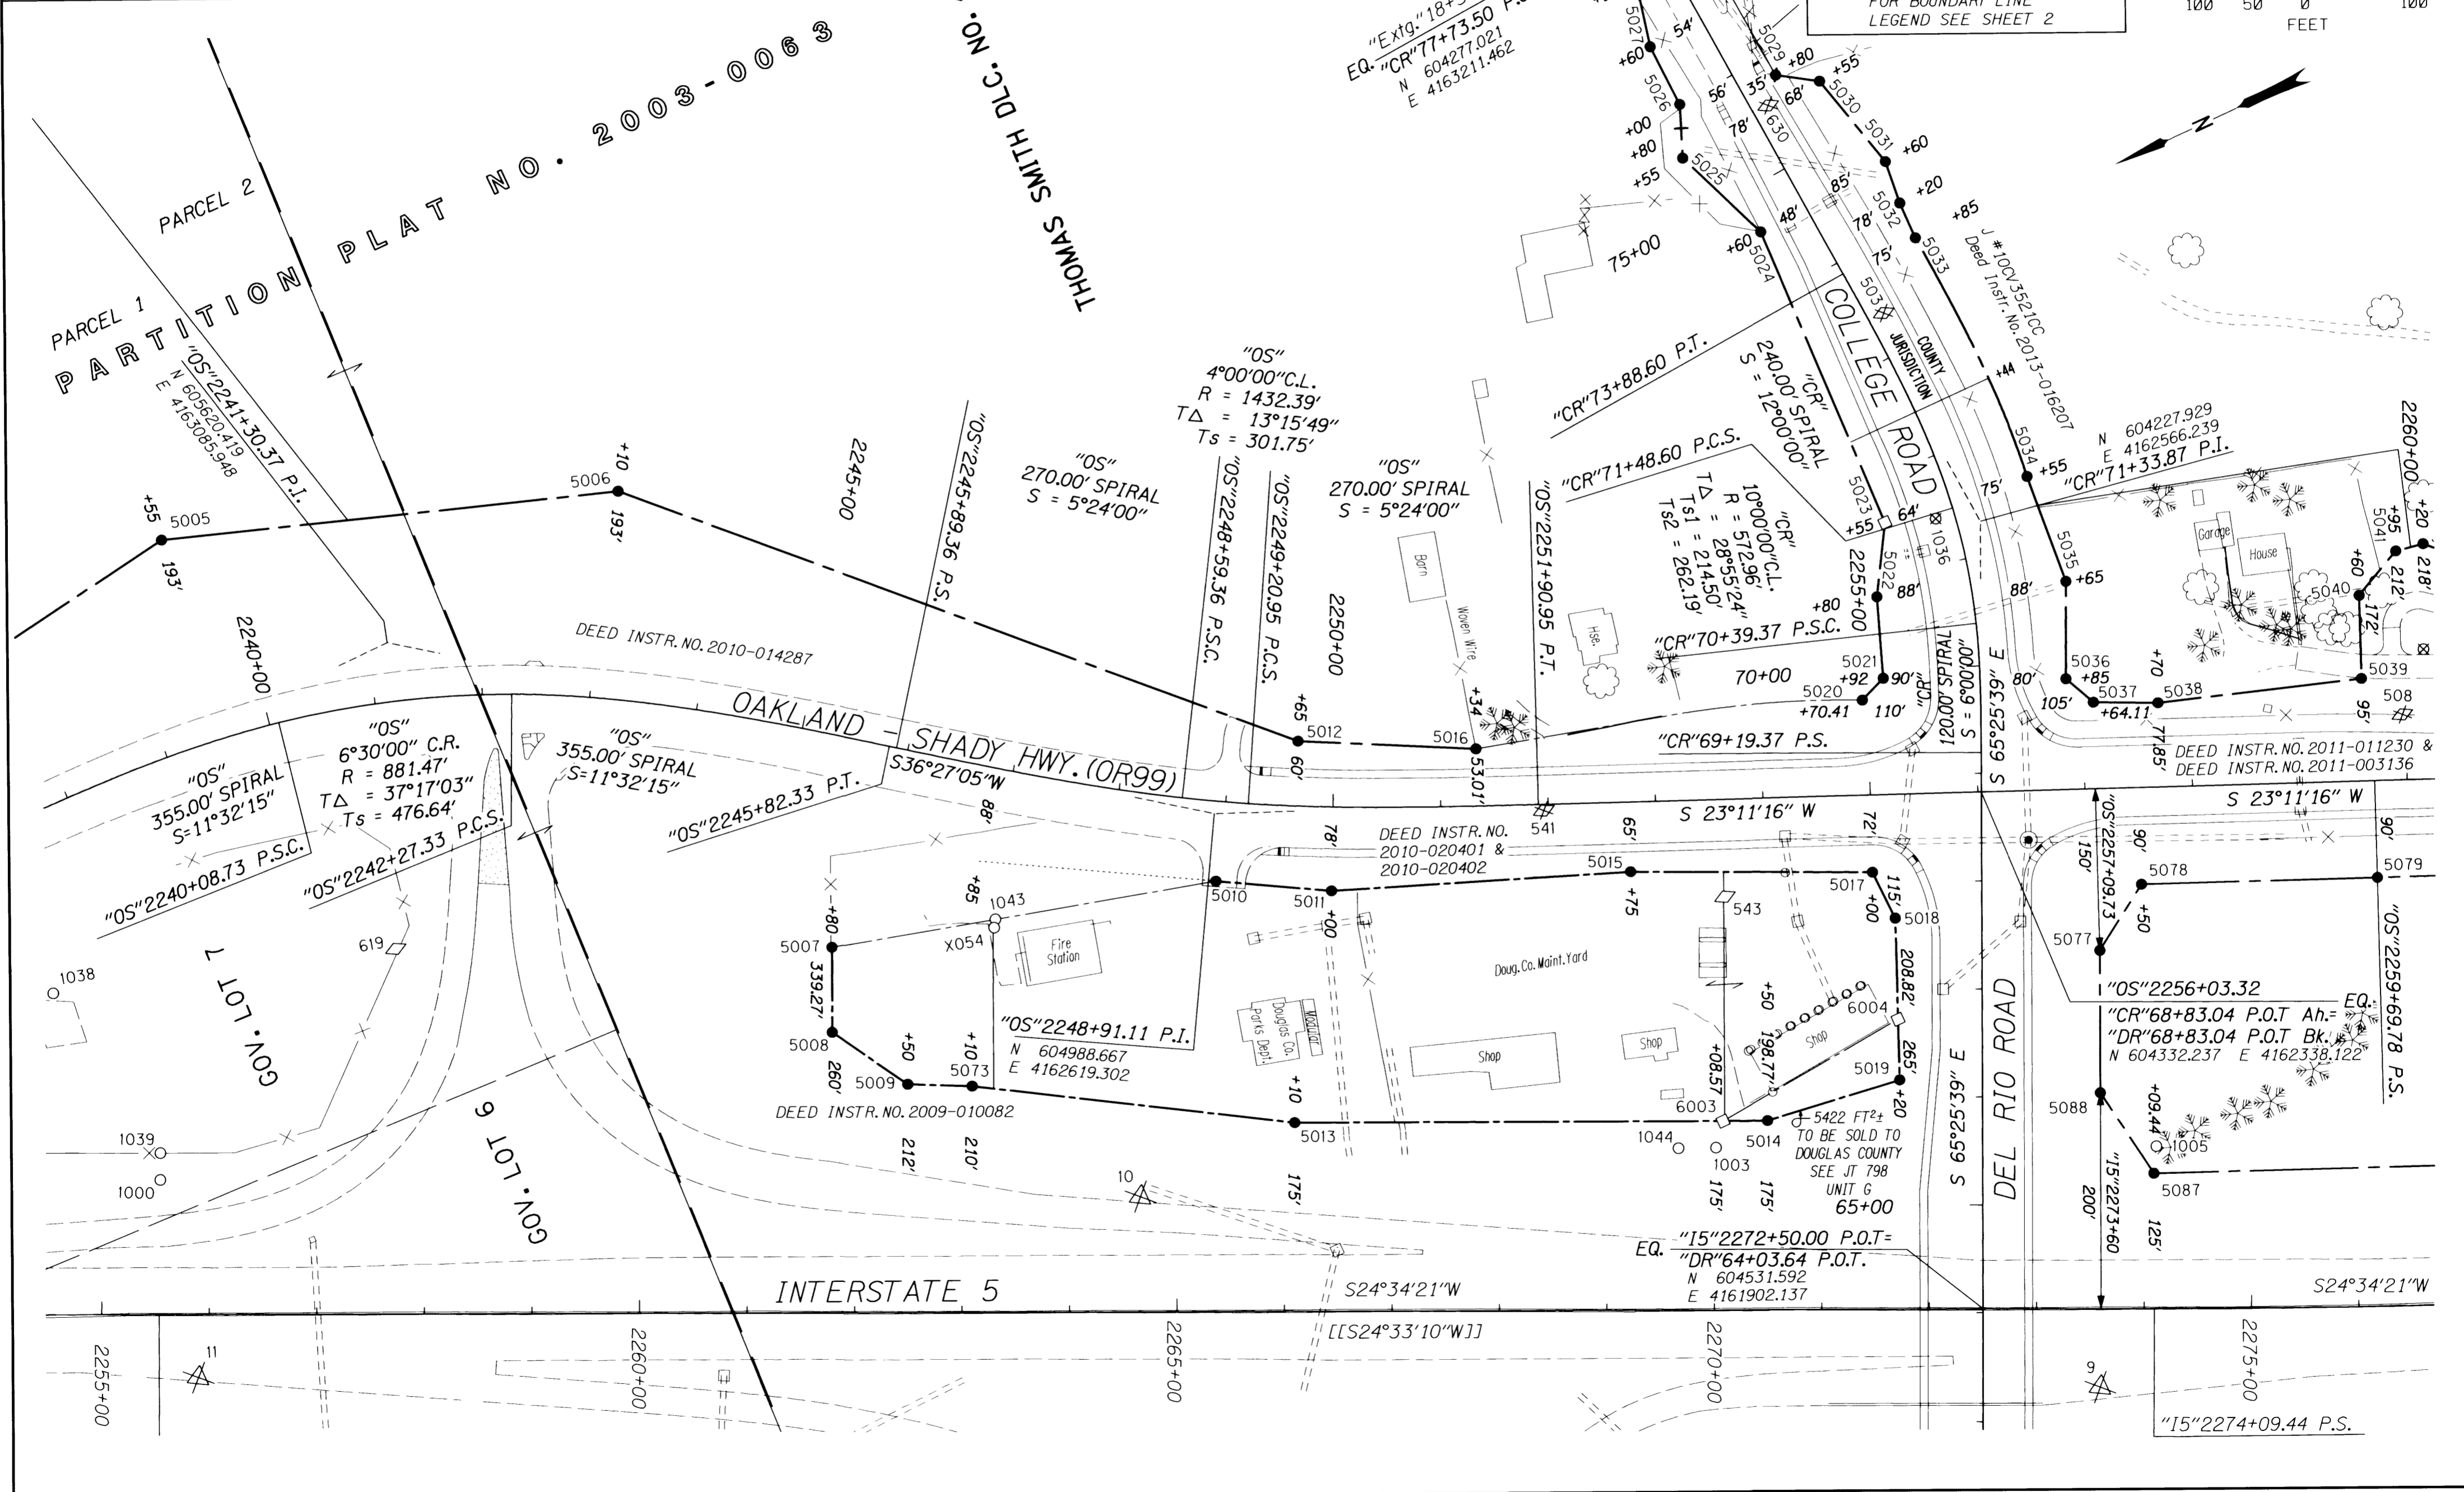

ST. HWY I5-028 D