


W1/2 SEC. 25, T. 28 S., R. 6 W., W.M.

FILED  
 Date: 9-12-2022 By: [Signature]  
 This survey consist of:  
 Map: ST. HWY 15-036 A-M  
 Narrative:  
 Corner Rpt: DOUGLAS COUNTY SURVEYOR

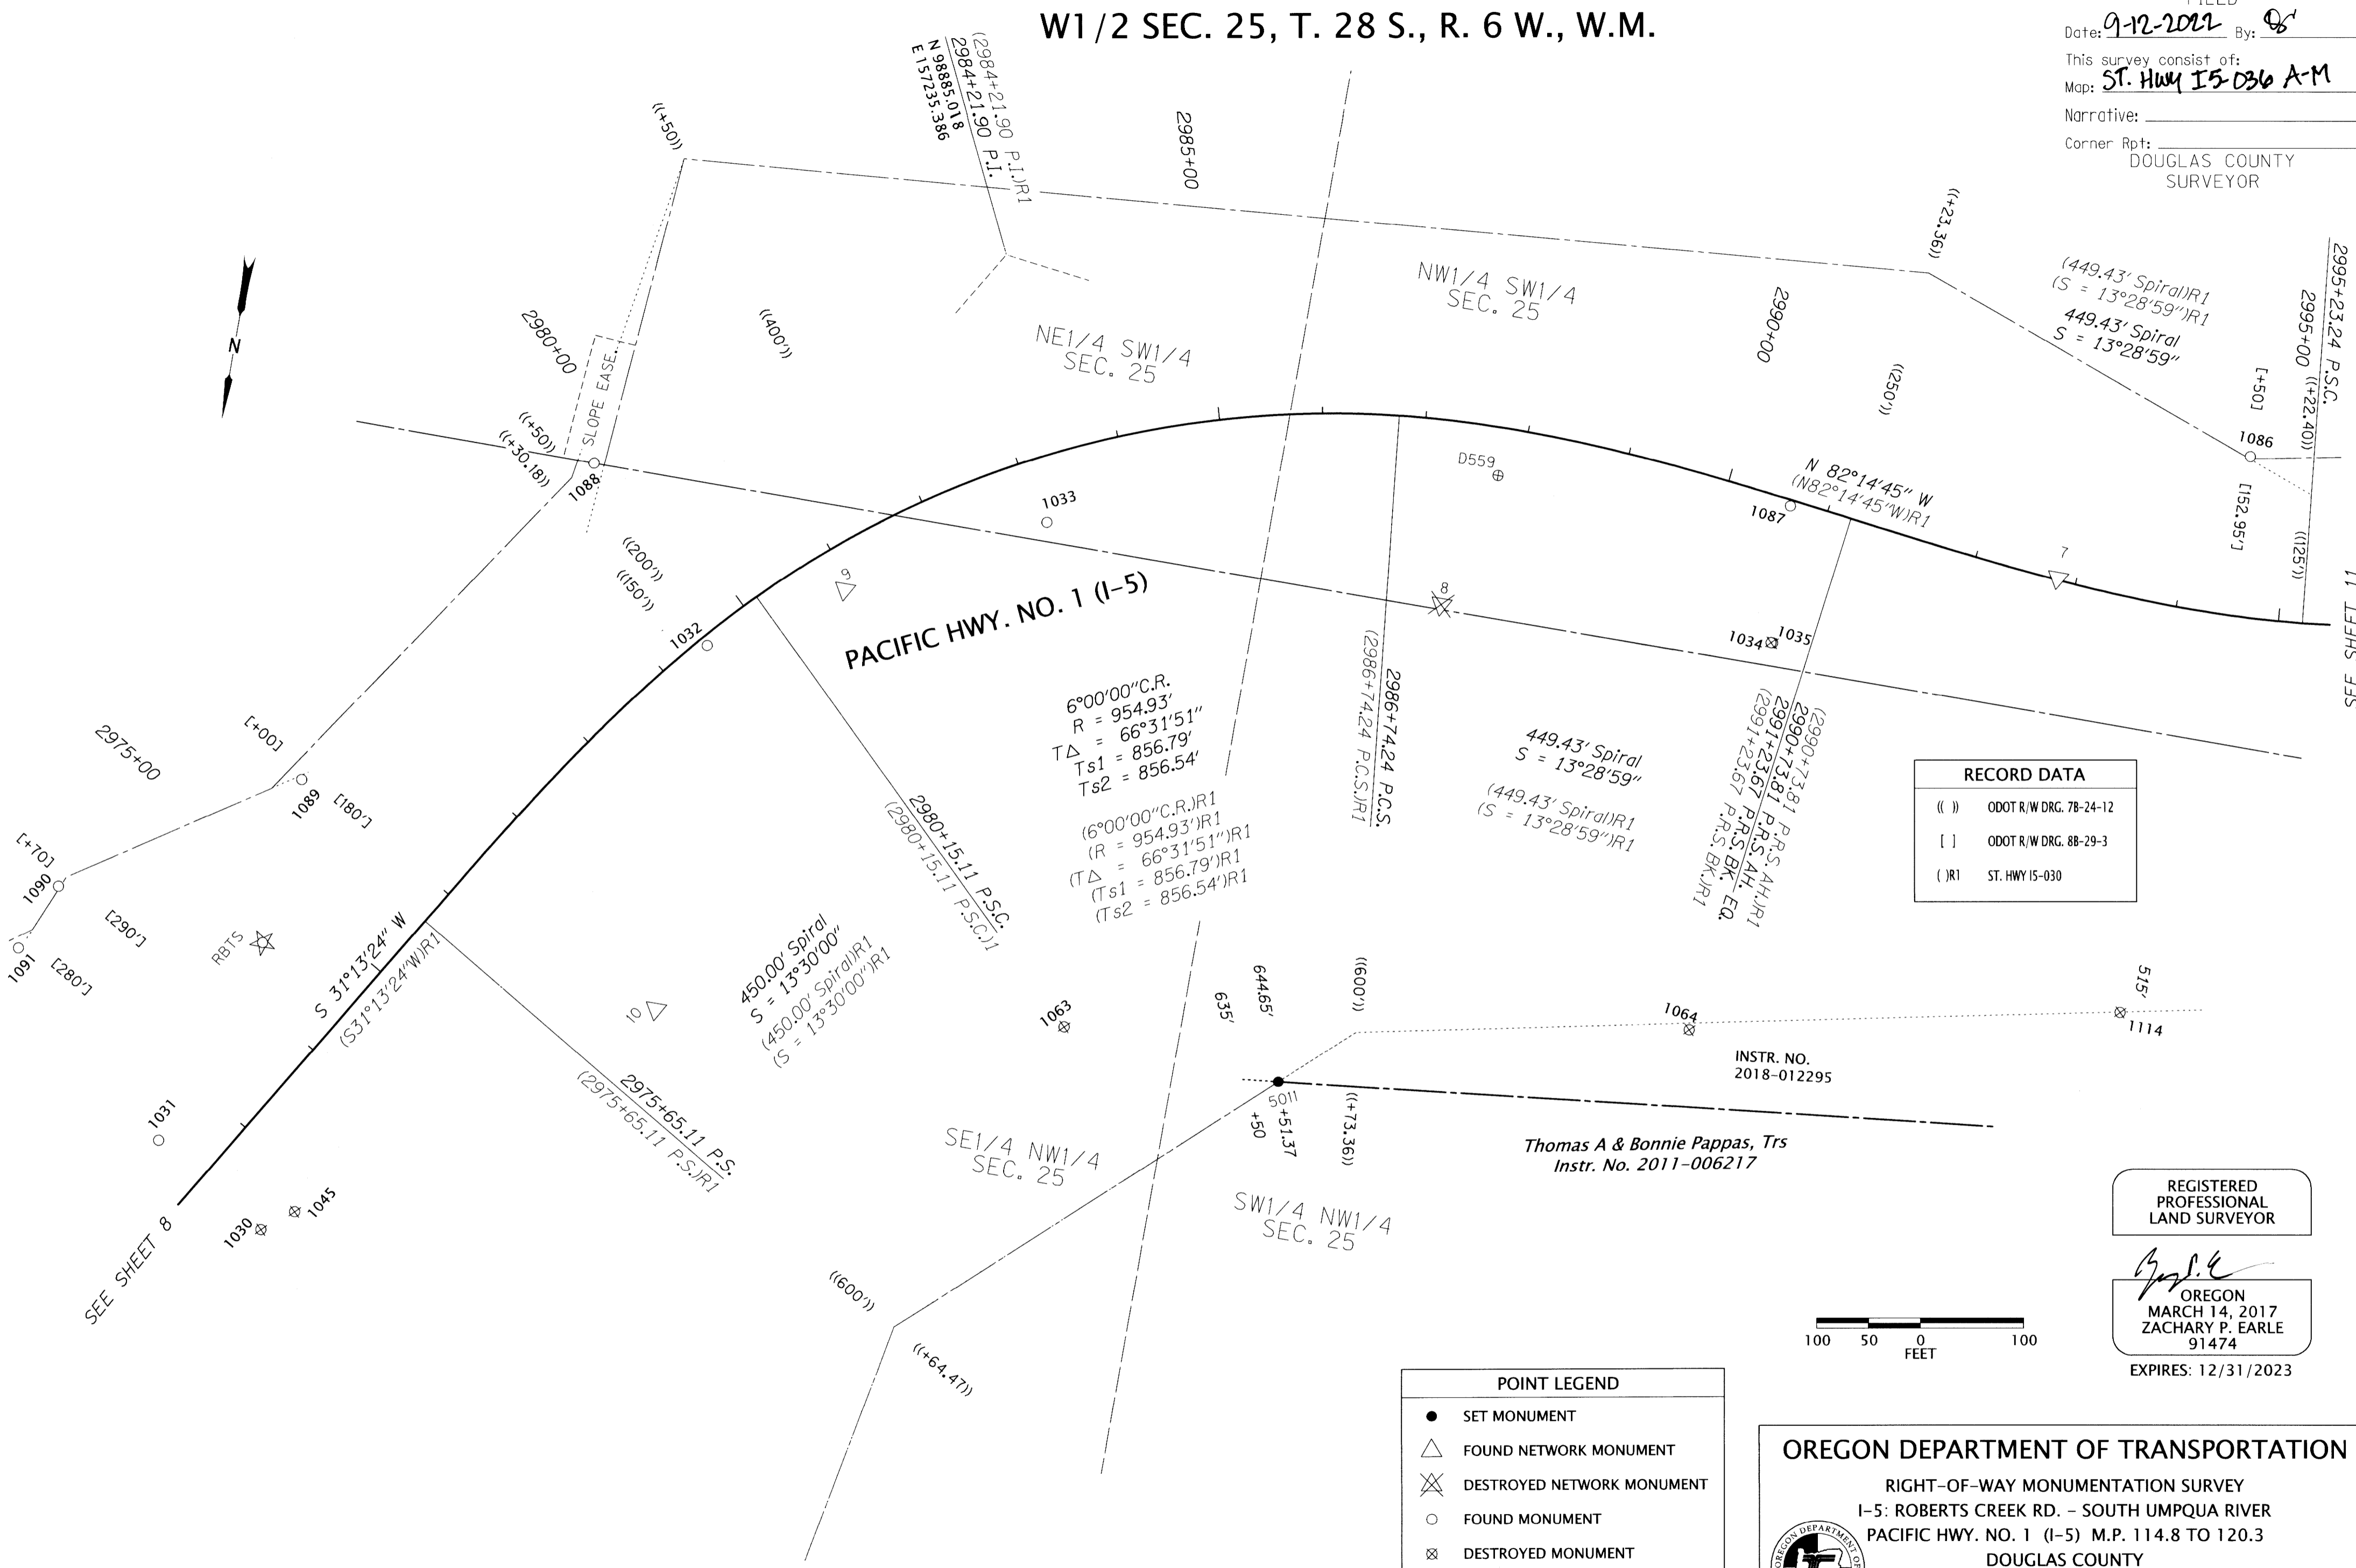

RECORD DATA	
(( ))	ODOT R/W DRG. 78-24-12
[ ]	ODOT R/W DRG. 88-29-3
( )R1	ST. HWY 15-030

6°00'00" C.R.  
 R = 954.93'  
 TΔ = 66°31'51"  
 Ts1 = 856.79'  
 Ts2 = 856.54'

(6°00'00" C.R.)R1  
 (R = 954.93')R1  
 (TΔ = 66°31'51")R1  
 (Ts1 = 856.79')R1  
 (Ts2 = 856.54')R1


449.43' Spiral  
 S = 13°28'59"

450.00' Spiral  
 S = 13°30'00"

(2990+73.81 P.R.S. AH)R1  
 (2990+73.81 P.R.S. AH)R1  
 (2991+23.67 P.R.S. BK) EQ  
 (2991+23.67 P.R.S. BK)R1

REGISTERED PROFESSIONAL LAND SURVEYOR

[Signature]  
 OREGON  
 MARCH 14, 2017  
 ZACHARY P. EARLE  
 91474  
 EXPIRES: 12/31/2023

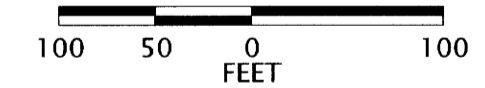

POINT LEGEND	
●	SET MONUMENT
△	FOUND NETWORK MONUMENT
⊗	DESTROYED NETWORK MONUMENT
○	FOUND MONUMENT
⊗	DESTROYED MONUMENT
☆	FOUND GPS STATION

SEE SHEET 2 FOR LINE LEGEND  
 SEE SHEET 10 FOR FOUND MONUMENT TABLE

SET MONUMENT TABLE

PT. NO.	OCRS NORTHING	OCRS EASTING	STATION	OFFSET (- IS LEFT)	DATE	DESCRIPTION
5011	99632.04	156840.49	2984+51.37	644.65	7/25/2022	SET 5/8" X 30" IRON REBAR w/ 1-1/2" ALUMINUM CAP "ODOT RIGHT OF WAY"

**OREGON DEPARTMENT OF TRANSPORTATION**

RIGHT-OF-WAY MONUMENTATION SURVEY  
 I-5: ROBERTS CREEK RD. - SOUTH UMPQUA RIVER  
 PACIFIC HWY. NO. 1 (I-5) M.P. 114.8 TO 120.3  
 DOUGLAS COUNTY

ODOT REGION 3 TECH CENTER  
 3500 NW STEWART PARKWAY  
 ROSEBURG, OR 97470 KEY NO. 18967

AUGUST 22, 2022  
 1" = 100'  
 SHEET 9 OF 13

ST. HWY. 15-036 I