


T. 26 S. R. 2 W. W.M.

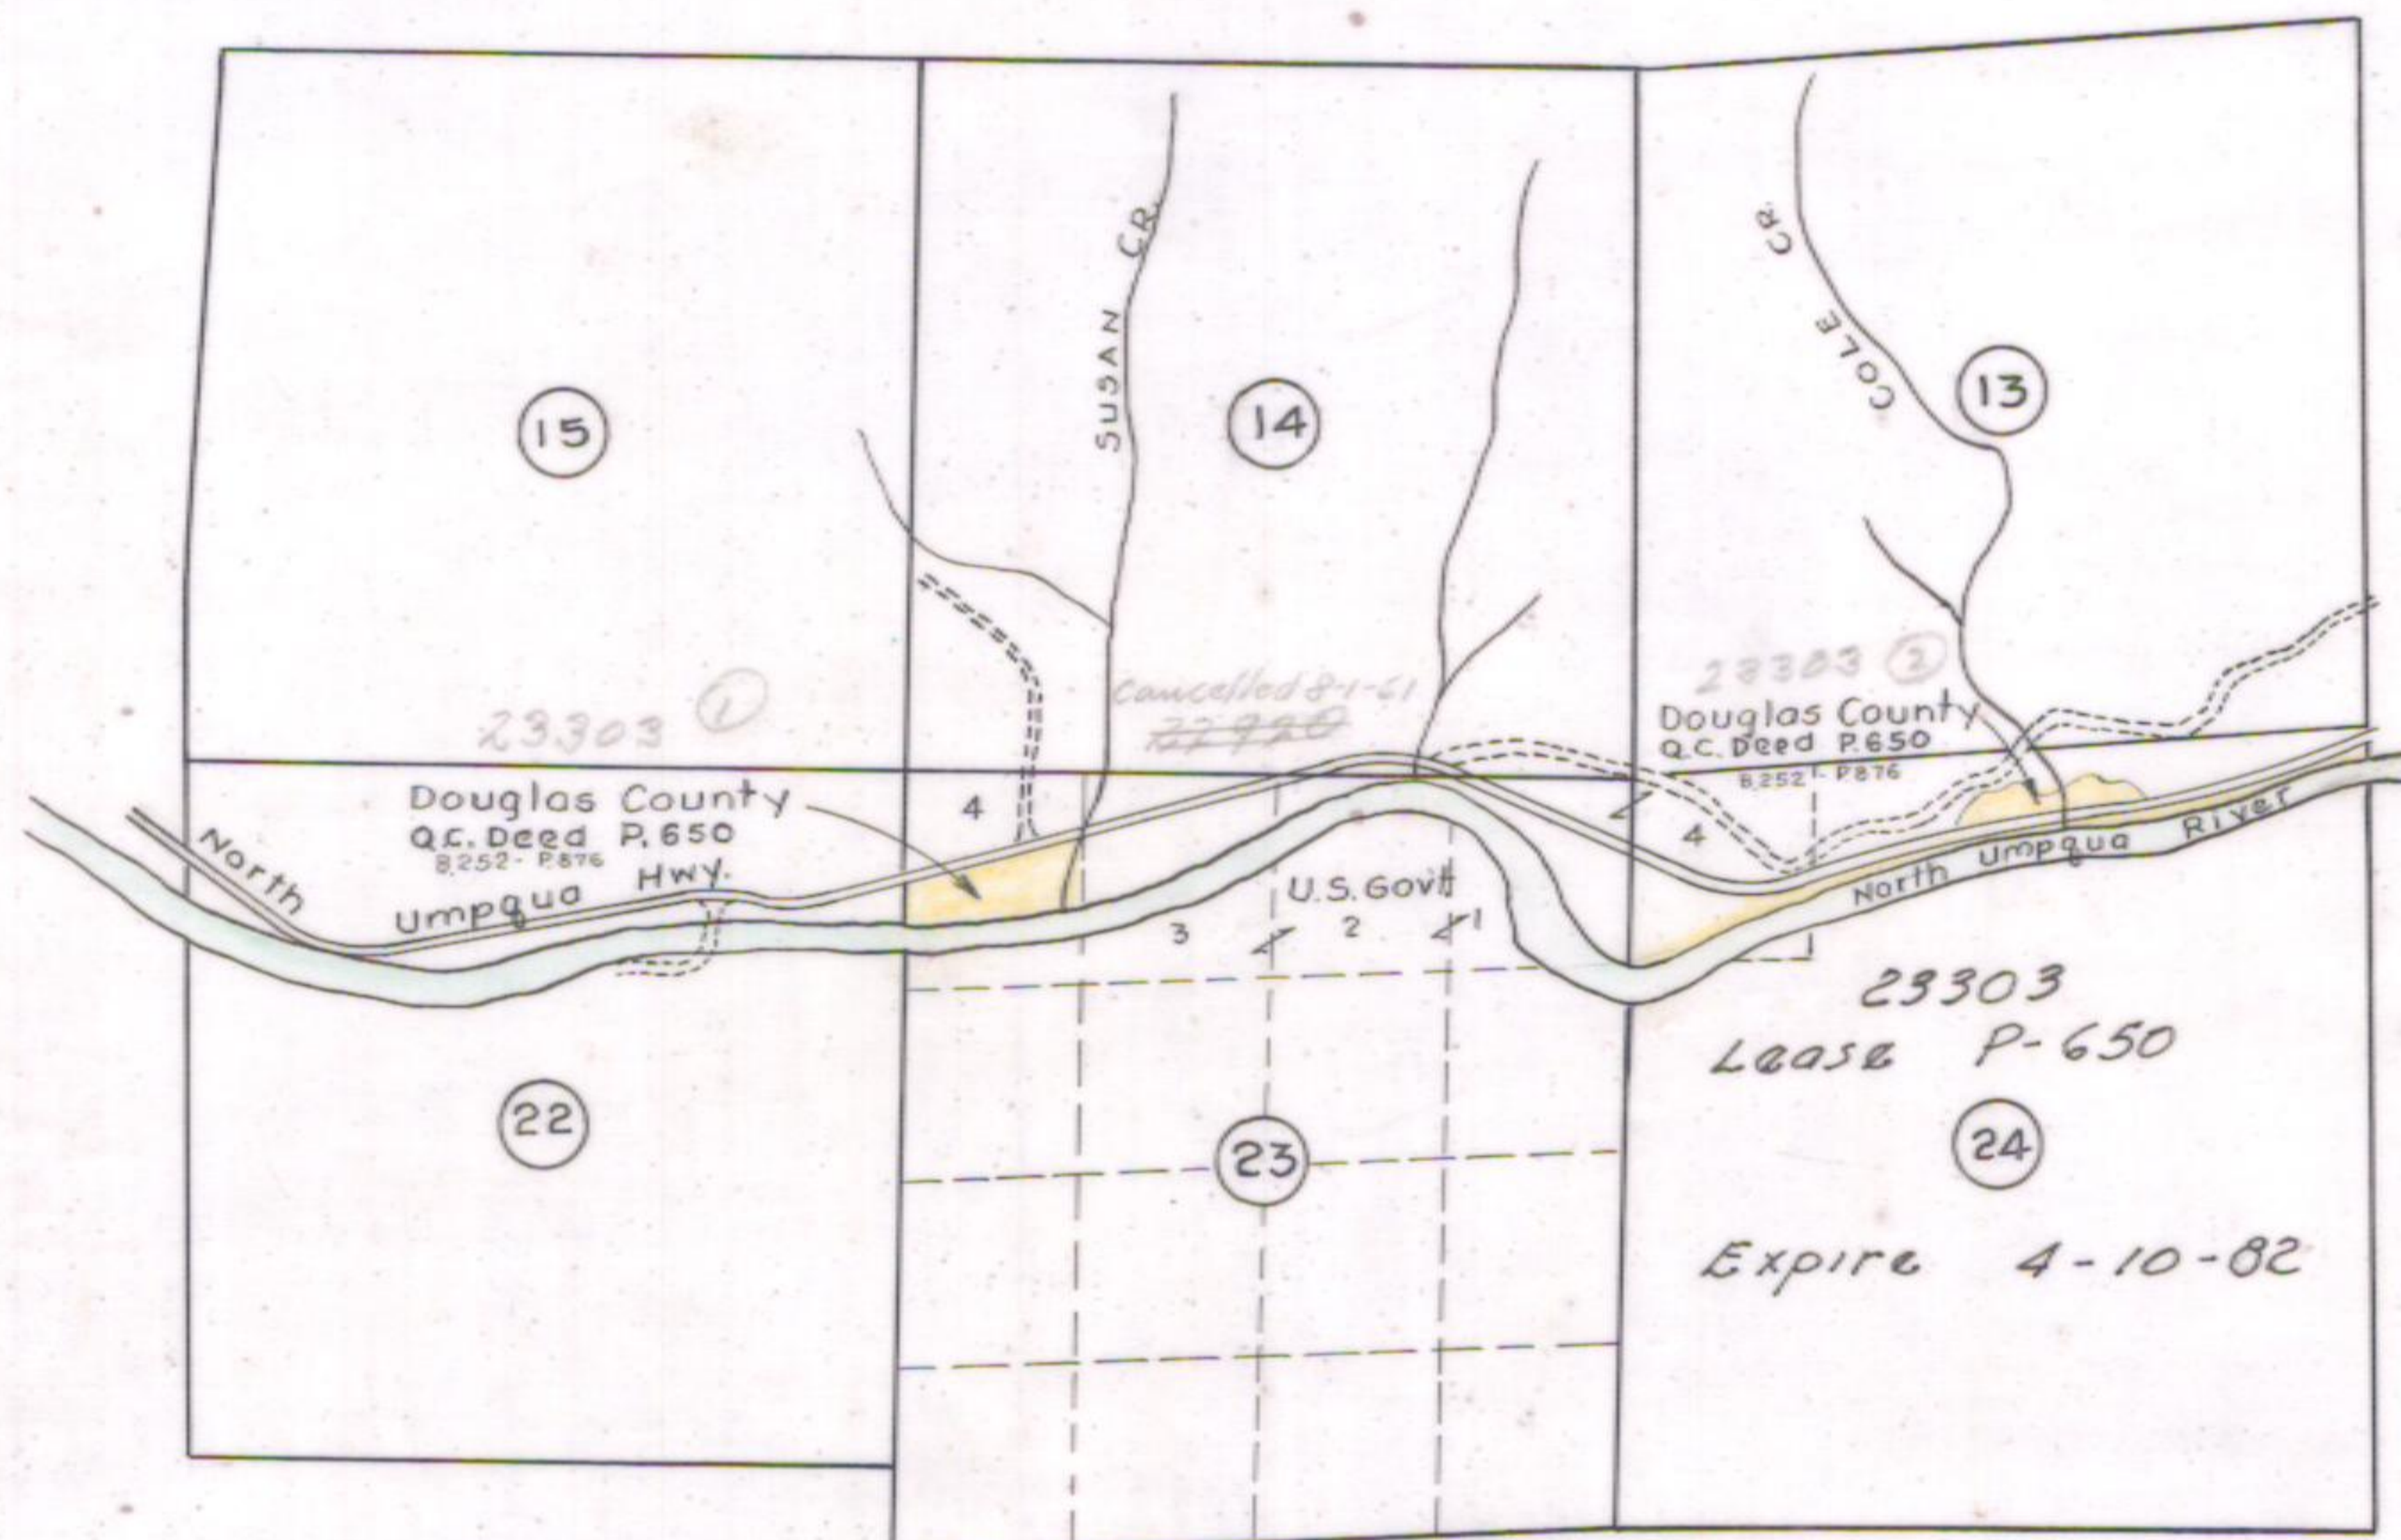

OREGON STATE HIGHWAY DEPARTMENT	
Acquire From	Douglas County
For	Susan Creek State Park
Highway	No. Umpqua Co. Road
County	Douglas
Scale 2In. = 1 Mile	Date July 1955