
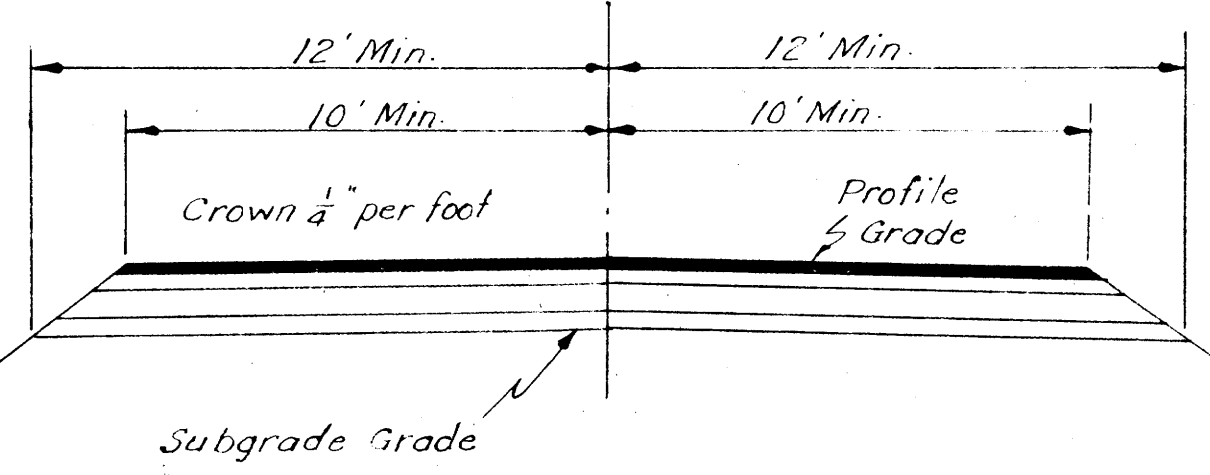


UMPQUA


NATIONAL

FOREST

16-C2-EI-F1
1
24
1932 Std.

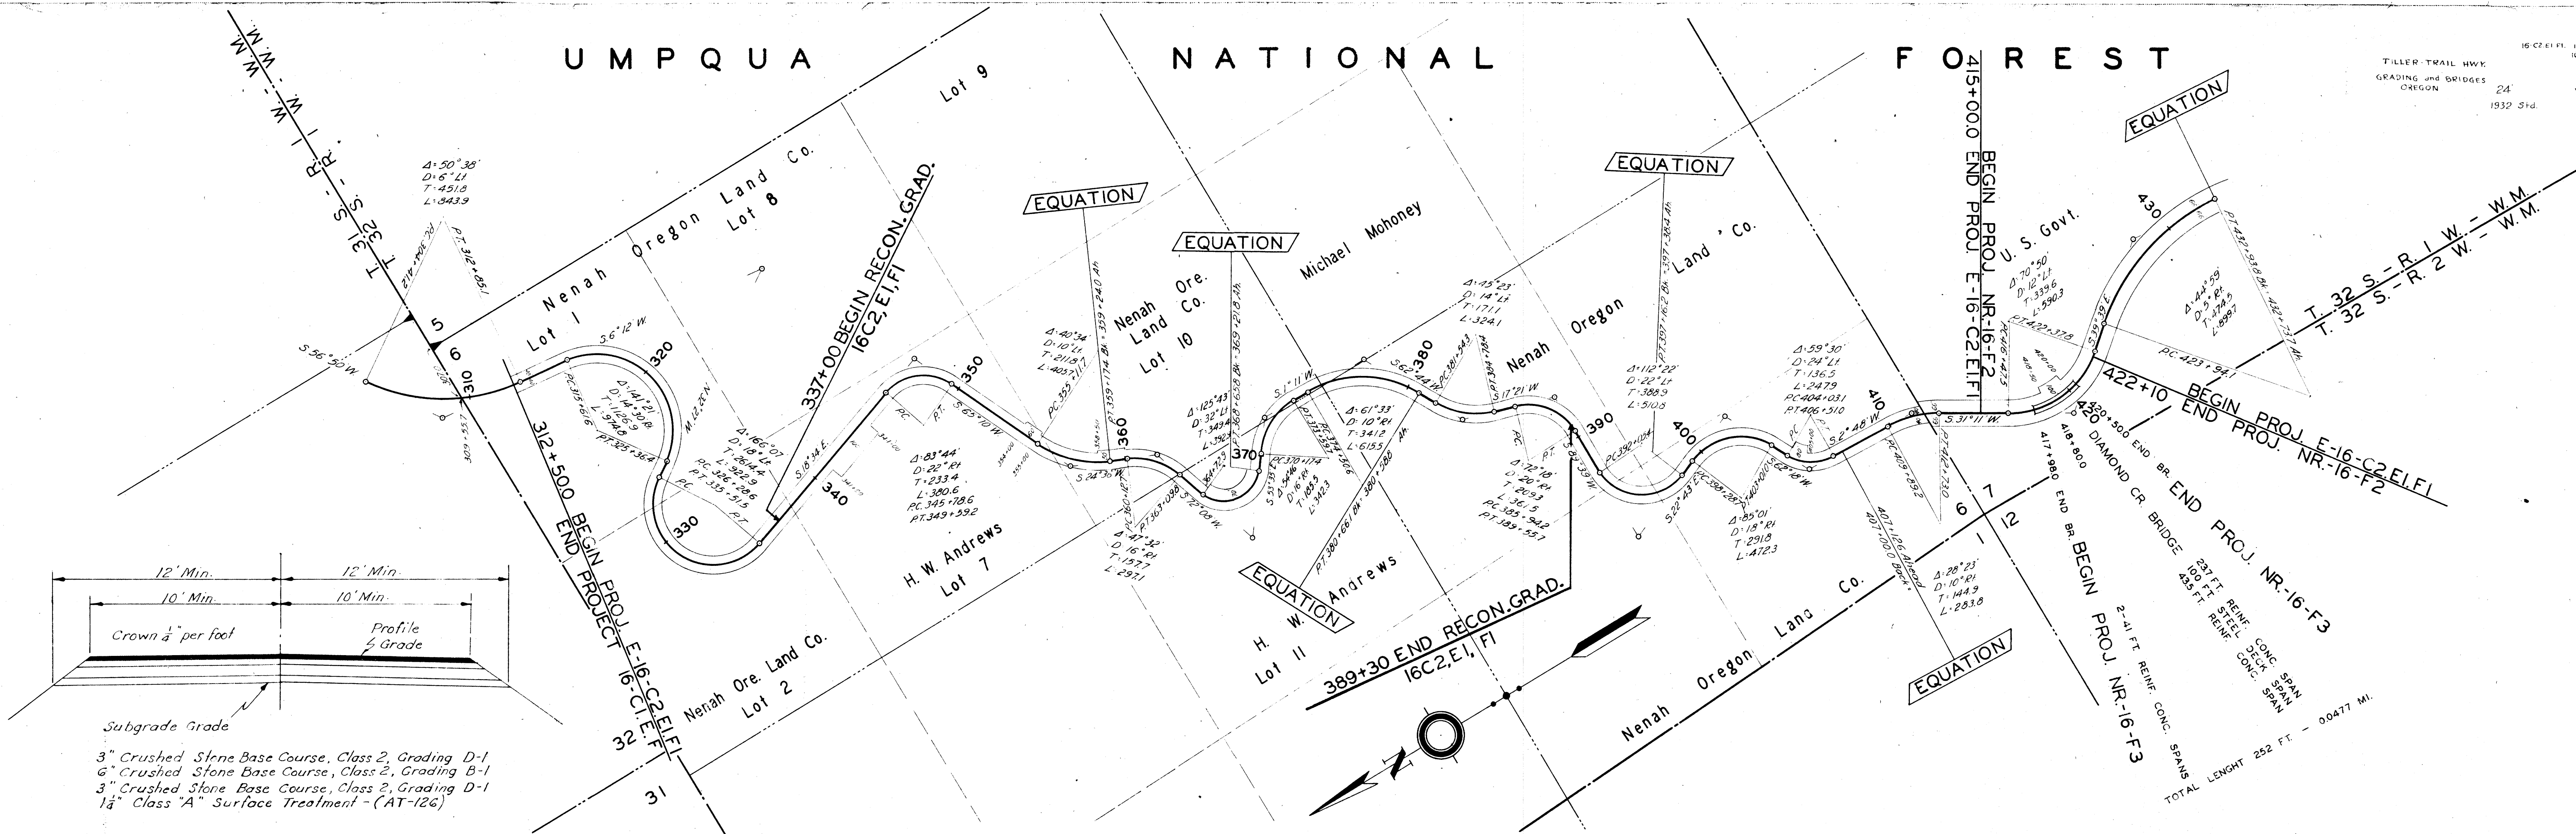

3" Crushed Stone Base Course, Class 2, Grading D-1
 6" Crushed Stone Base Course, Class 2, Grading B-1
 3" Crushed Stone Base Course, Class 2, Grading D-1
 1 1/2" Class "A" Surface Treatment - (AT-12c)

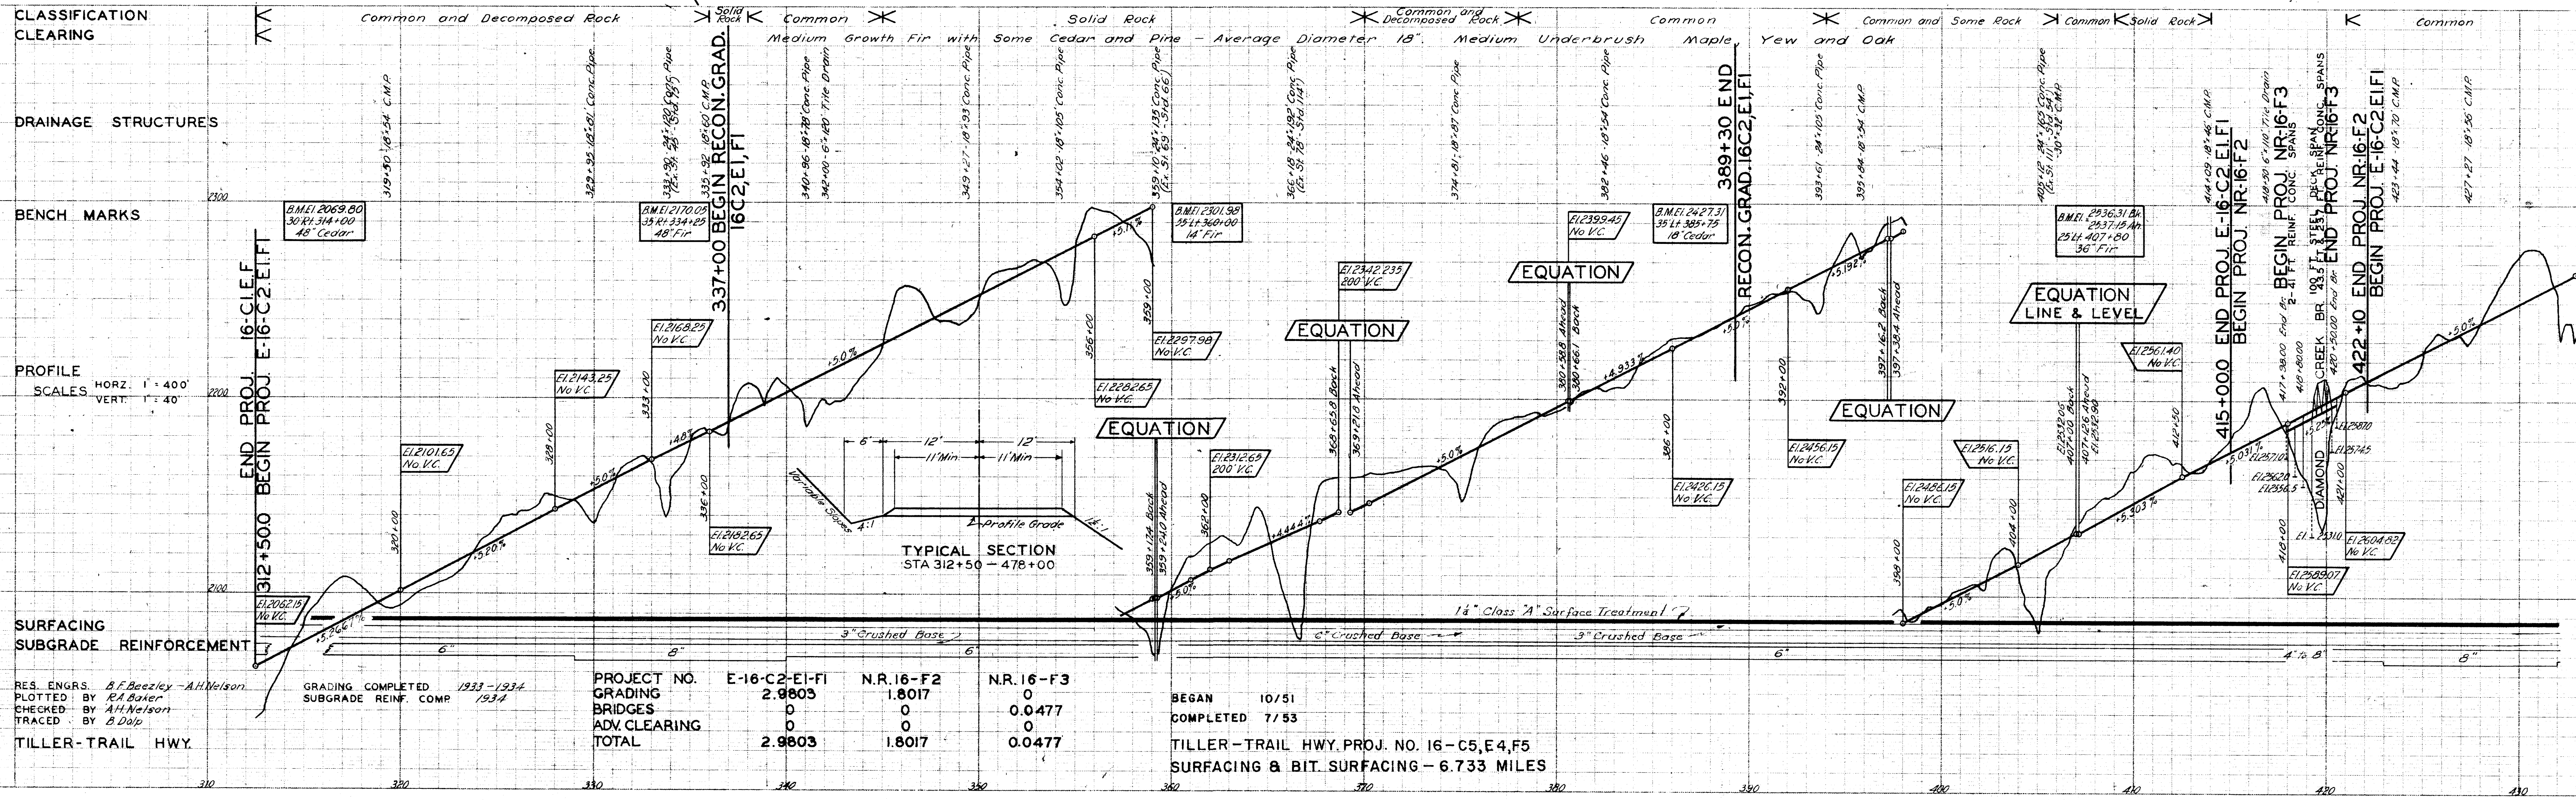

RES. ENGRS. B.F. Beezley - A.H. Nelson	GRADING COMPLETED 1933-1934	PROJECT NO. E-16-C2-EI-F1	N.R. 16-F2	N.R. 16-F3	BEGAN 10/51
PLOTTED BY E.A. Baker	SUBGRADE REINF. COMP 1934	GRADING 2.9803	1.8017	0	COMPLETED 7/53
CHECKED BY A.H. Nelson		BRIDGES 0	0	0.0477	
TRACED BY B. Dole		ADV. CLEARING 0	0	0	
TILLER-TRAIL HWY.		TOTAL 2.9803	1.8017	0.0477	TILLER-TRAIL HWY. PROJ. NO. 16-C5, E4, F5
					SURFACING & BIT SURFACING - 6.733 MILES