


3" Crushed Stone Base Course, Class 2, Grading D-1  
 6" Crushed Stone Base Course, Class 2, Grading B-1  
 3" Crushed Stone Base Course, Class 2, Grading D-1  
 1 $\frac{1}{2}$ " Class "A" Surface Treatment - (AT-126)

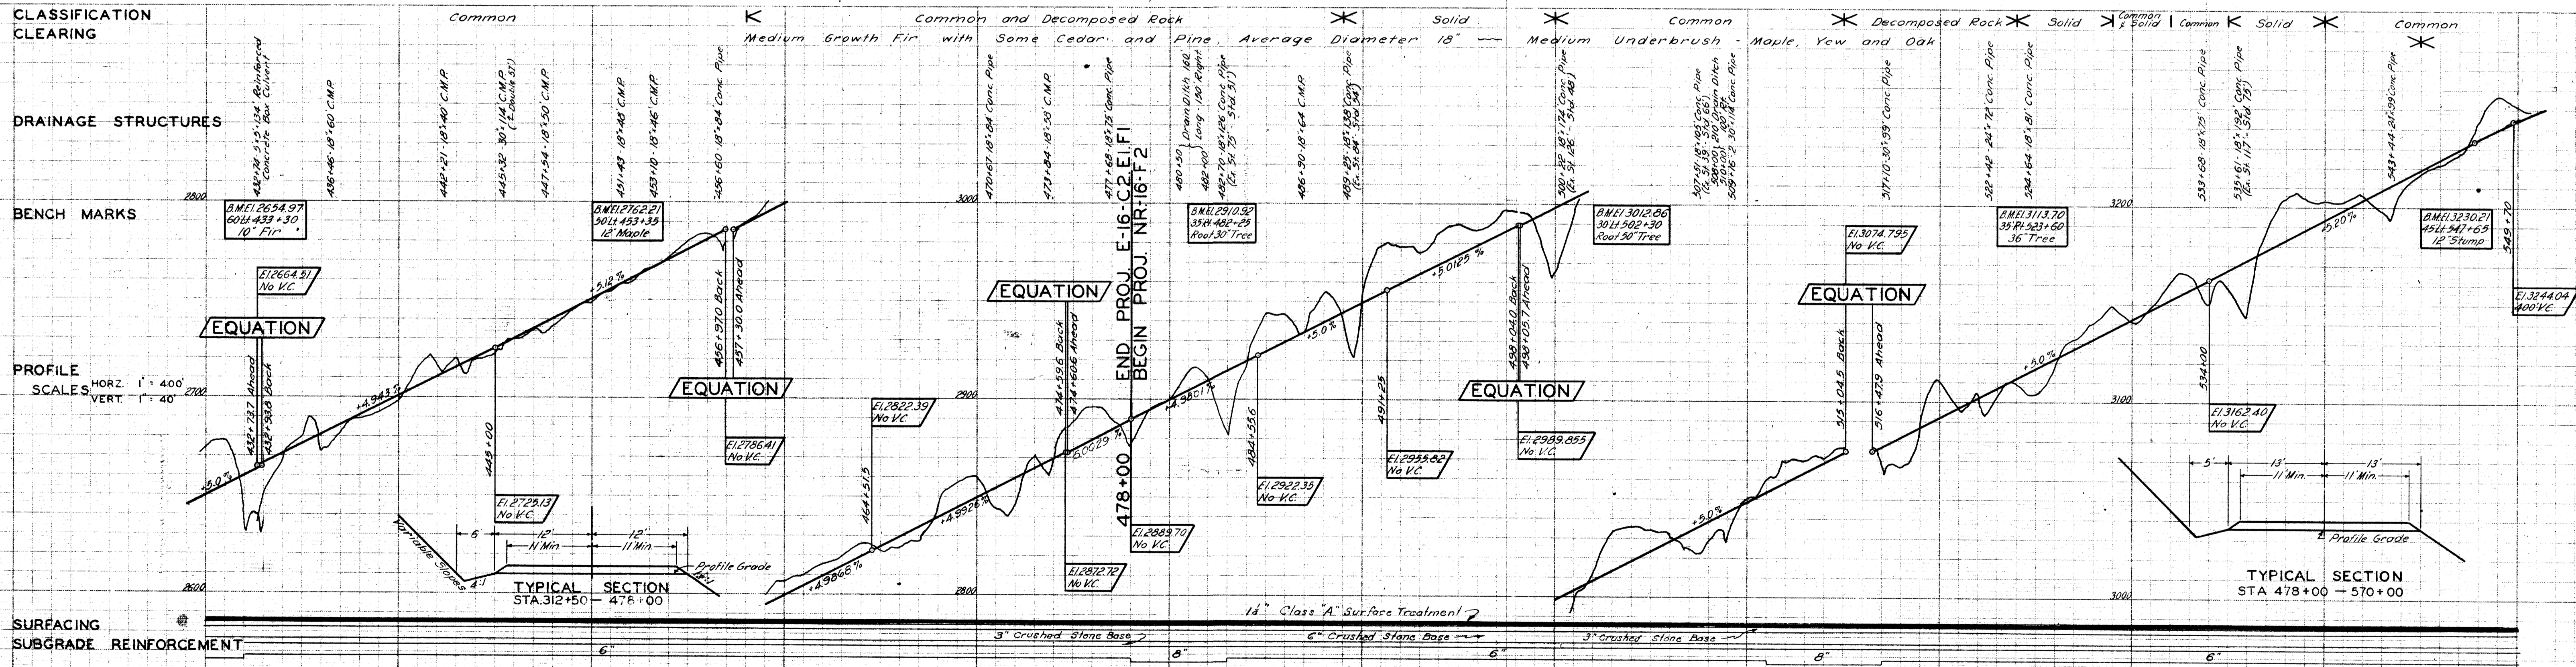

RES. ENGRS. <i>B. Deesley - A. Nelson</i>	GRADING COMPLETED 1933 - 1934	PROJECT NO. E-16-C2-EI-F1 NR.16-F2	BEGAN 10/51
PLOTTED BY <i>R. Baker</i>	SUBGRADE REINF. COMP. 1934	GRADING 2,9803 1,8017	COMPLETED 7/53
CHECKED BY <i>A. Nelson</i>		ADV. CLEARING 0 0	
TRACED BY <i>B. Deis</i>		TOTAL 2,9803 1,8017	

TILLER-TRAIL HWY. SURFACING & BIT SURFACING - 6.733 MILES

430 440 450 460 470 480 490 500 510 520 530 540 550