



DOUGLAS COUNTY, OREGON  
 PLANS FOR PROPOSED PROJECT  
 GRADING, SURFACING, STORM —  
 SEWER, & SANITARY SEWER

# RANCH ROAD & FERN ACRES SUBDIVISION 1976

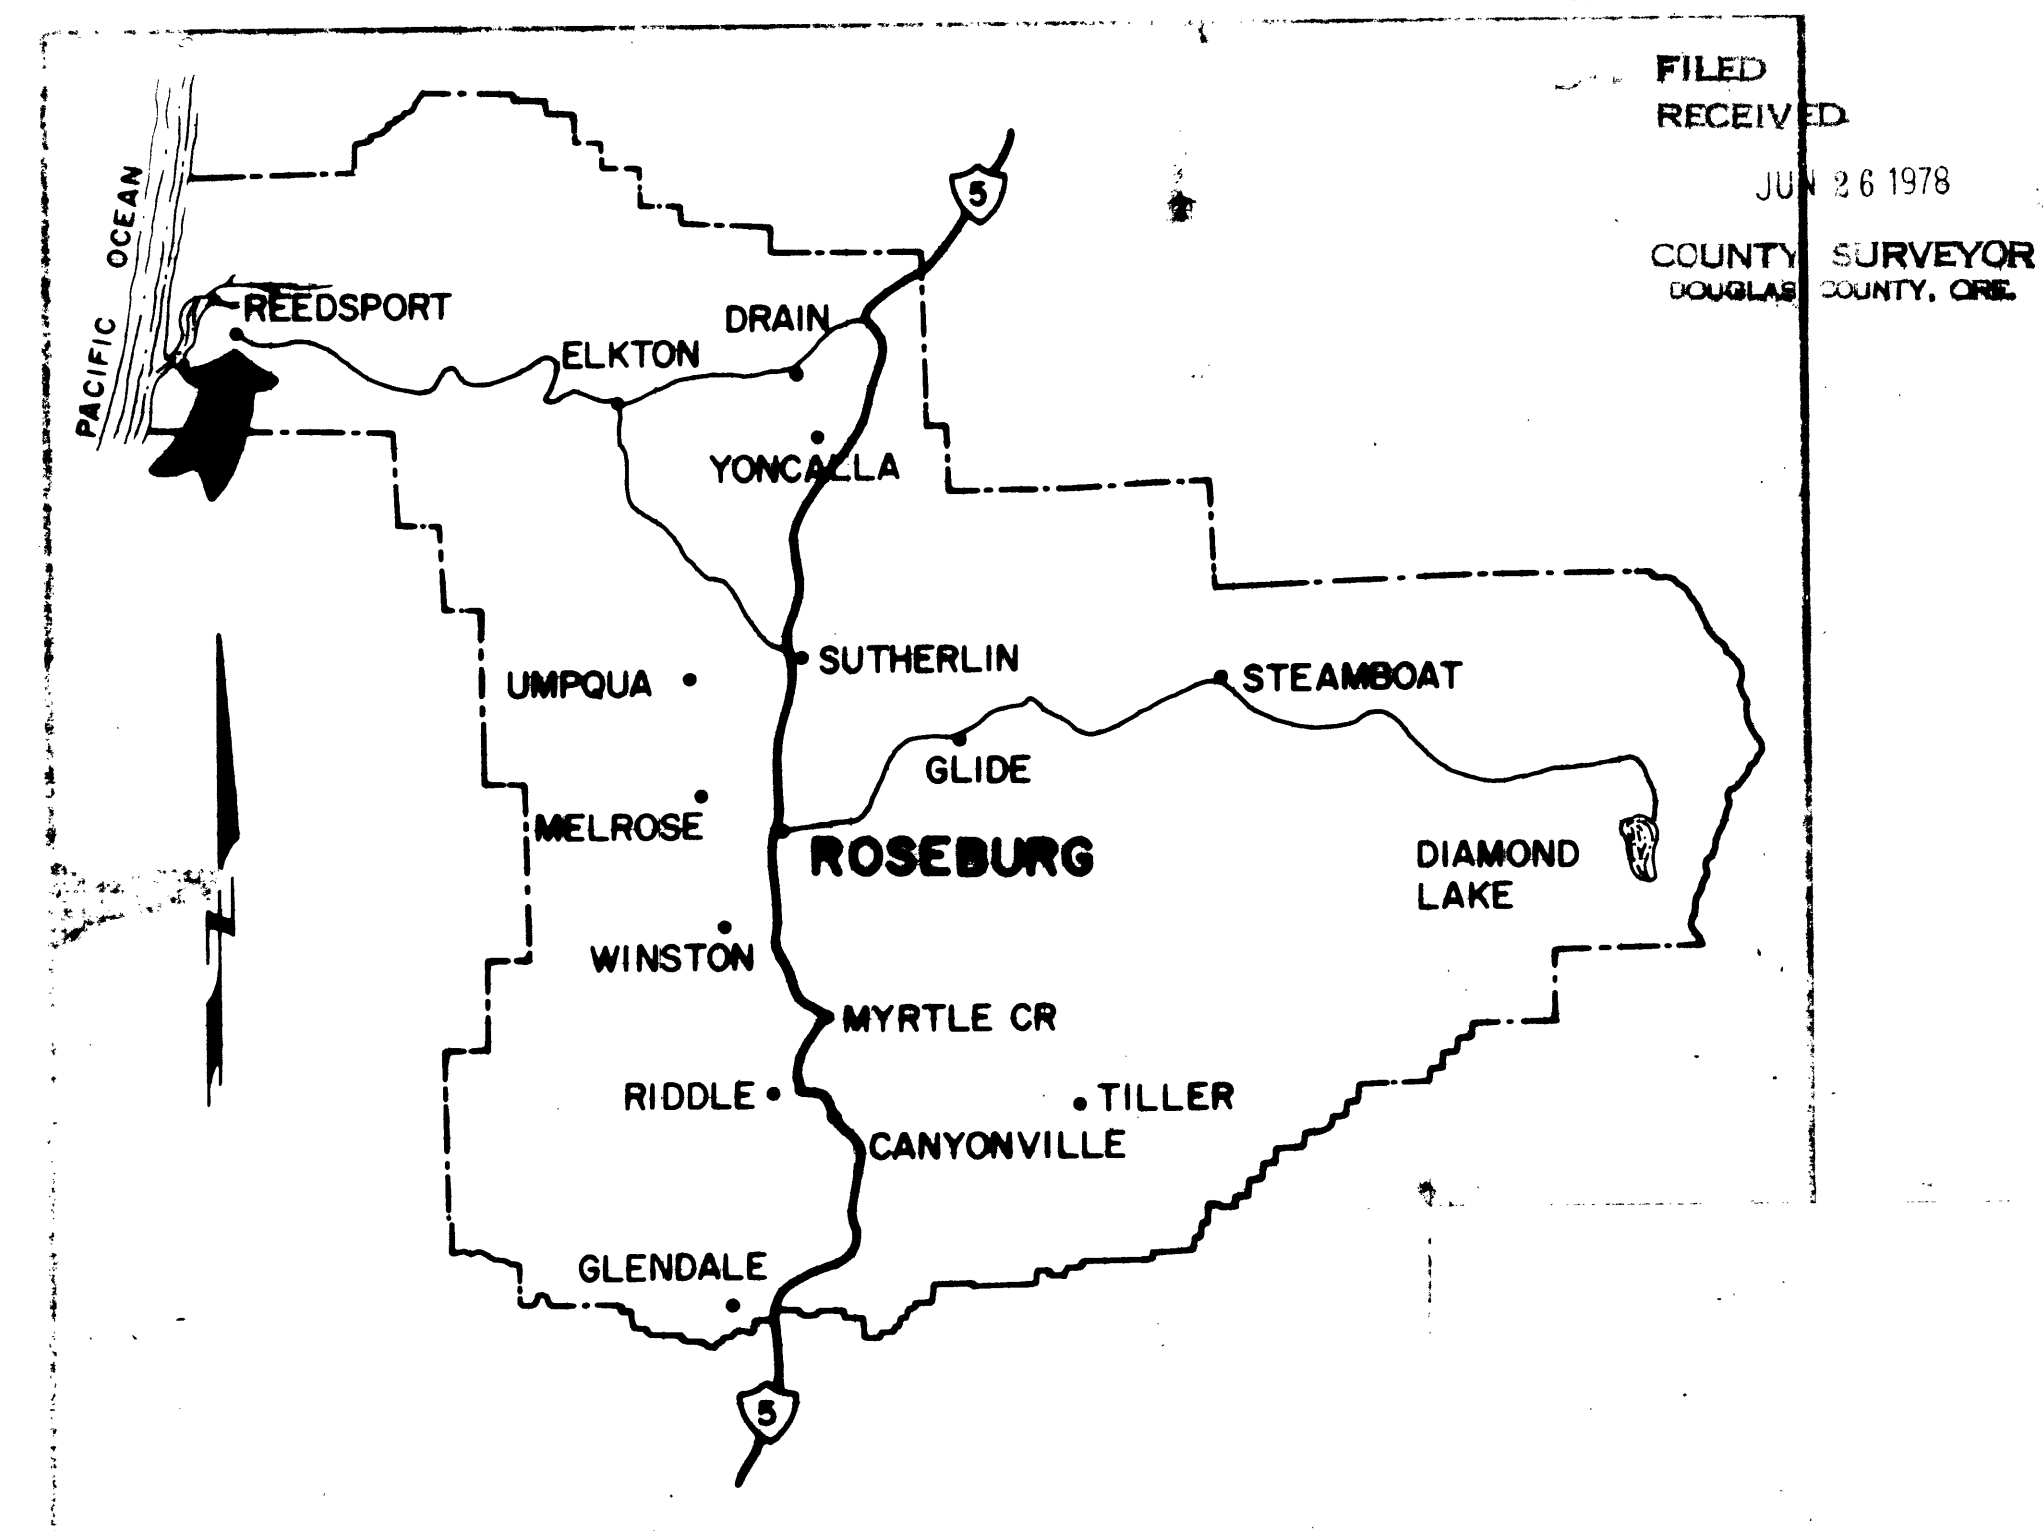

## INDEX OF DRAWINGS

- SHEET NO.
- 1. COVER SHEET
  - 2. QUANTITY SUMMARY
  - 3. TYPICAL SECTIONS
  - 4-6 ROAD PLANS
  - 7. STORM DRAIN PLAN
  - 8-13 SANITARY SEWER PLANS
  - 14. MANHOLE DETAIL DRAWINGS
- STANDARD DRAWINGS  
 310, 110, & 9,  
 17 SHEETS TOTAL

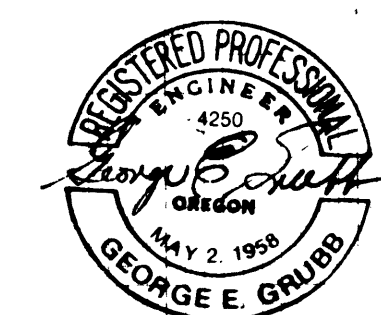

AS BUILT - 6/13/78 S.B.G.  
 DOUGLAS COUNTY  
 PUBLIC WORKS DEPARTMENT  
 RANCH ROAD & FERN ACRES SUB.  
 1976 SHT. 1  
 GEORGE E. GRUBB, DIRECTOR