



TYPICAL SECTION  
 "L" 50+00 TO "L" 78+96.47

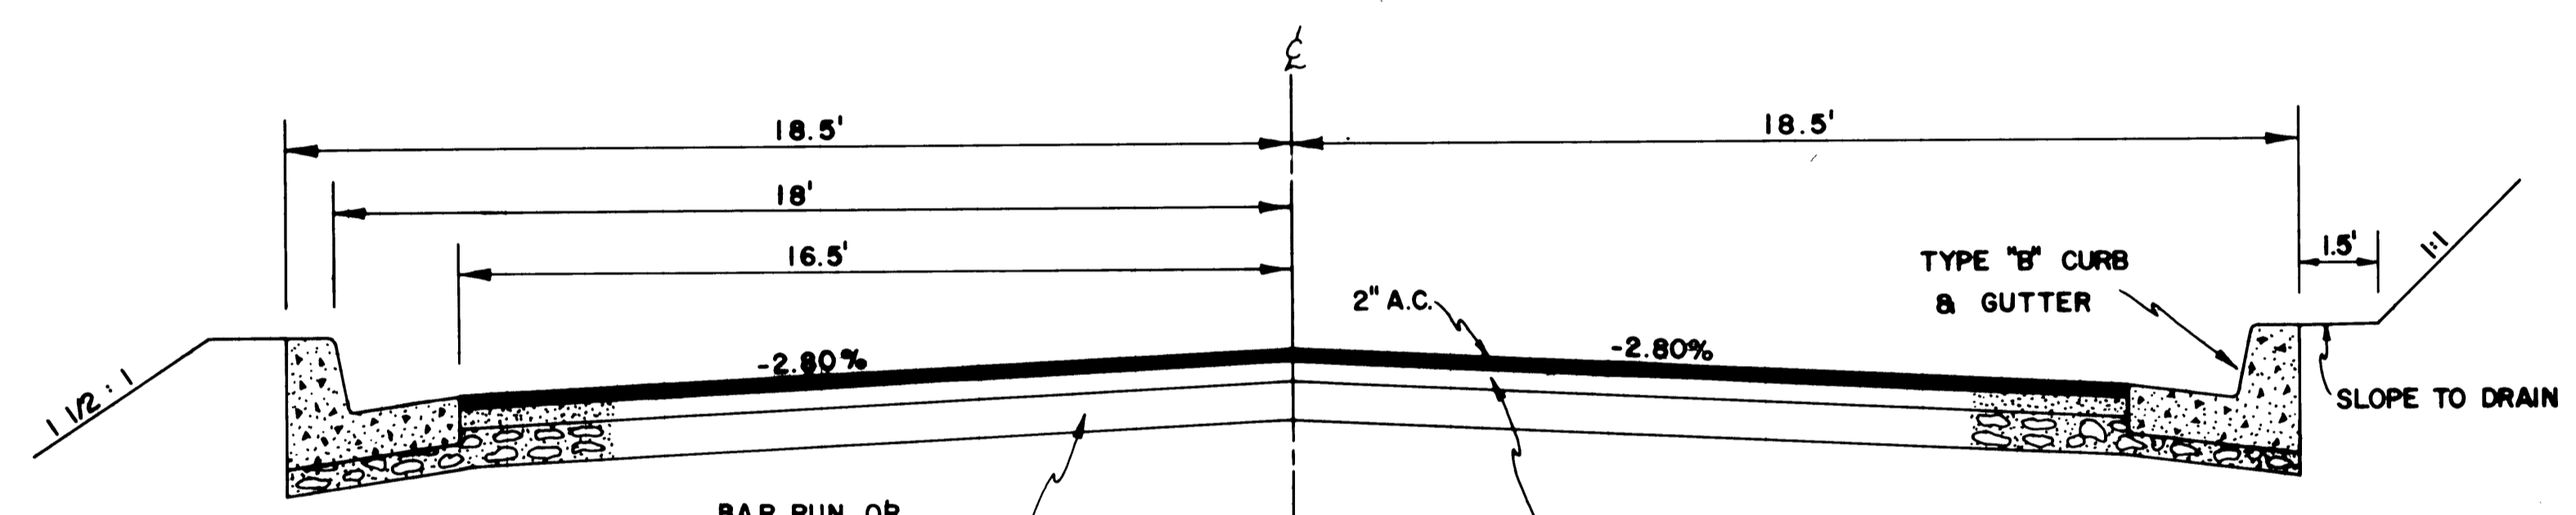

TYPICAL SECTION  
 "L" 2+50 TO "L" 4+50  
 AND ALL SIDE STREETS  
 TRANSITION  
 FROM "L" 4+50 TO "L" 10+00

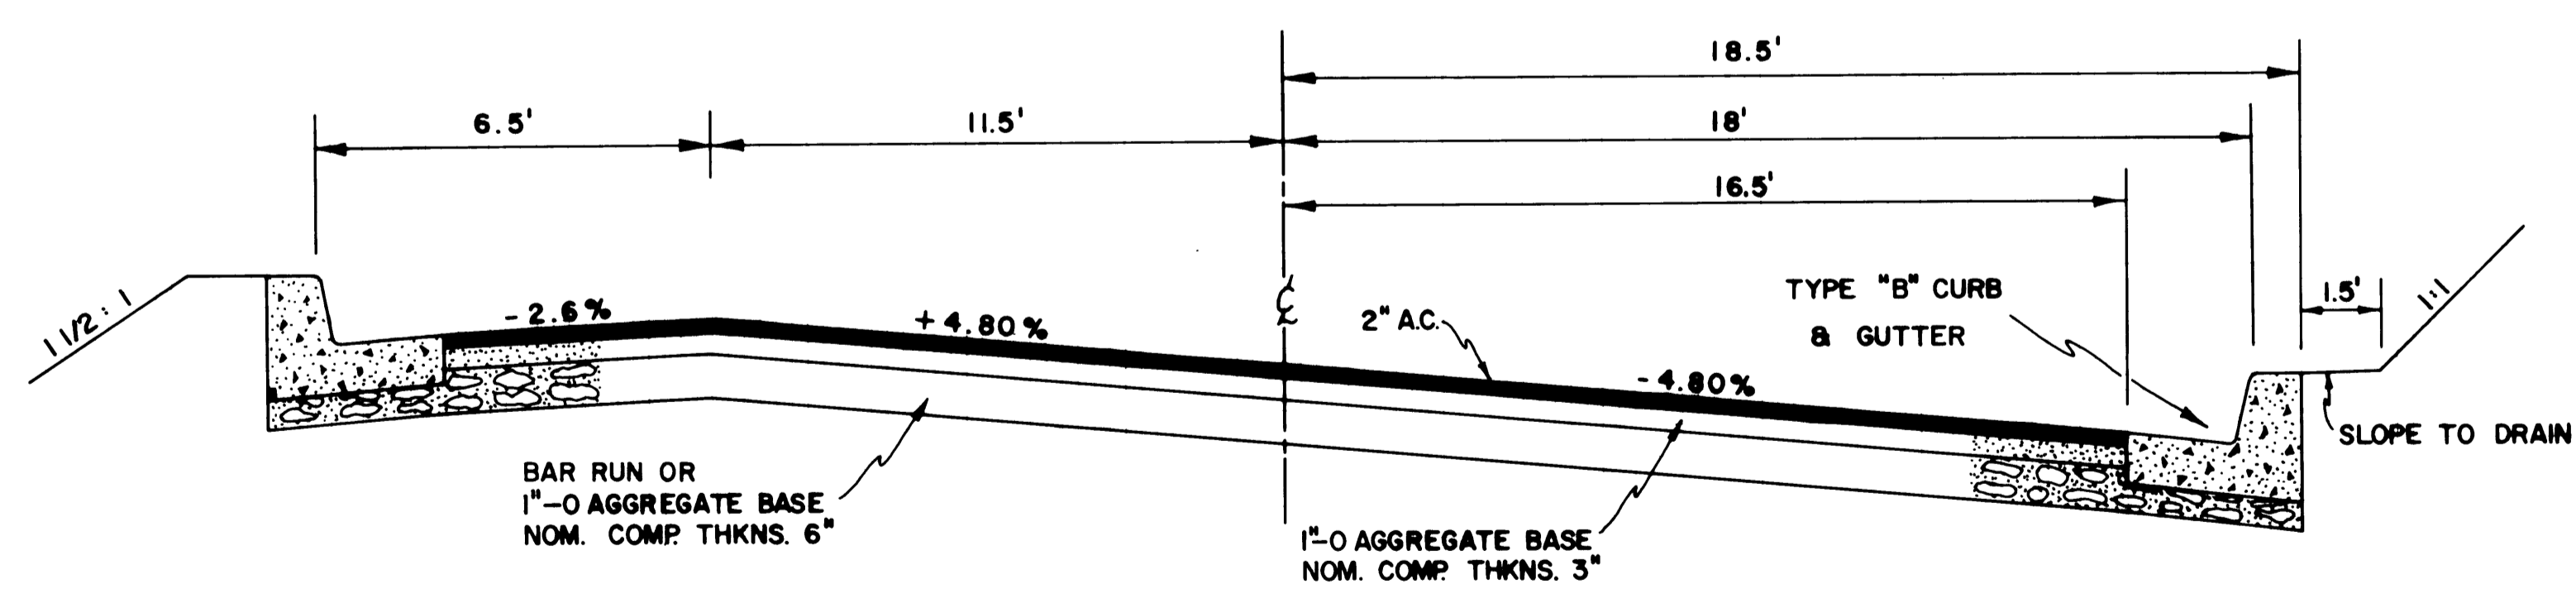

TYPICAL SECTION  
 "L" 10+00 TO "L" 15+70

AS BUILT - 6/13/78 S.B.G.  
 DOUGLAS COUNTY  
 PUBLIC WORKS DEPARTMENT  
 FERN ACRES SUBDIVISION  
 1976 SHT. 3  
 GEORGE E. GRUBB, DIRECTOR