


FILED
 JUN 28 1978
 COUNTY ENGINEER
 DOUGLAS COUNTY, ORE.

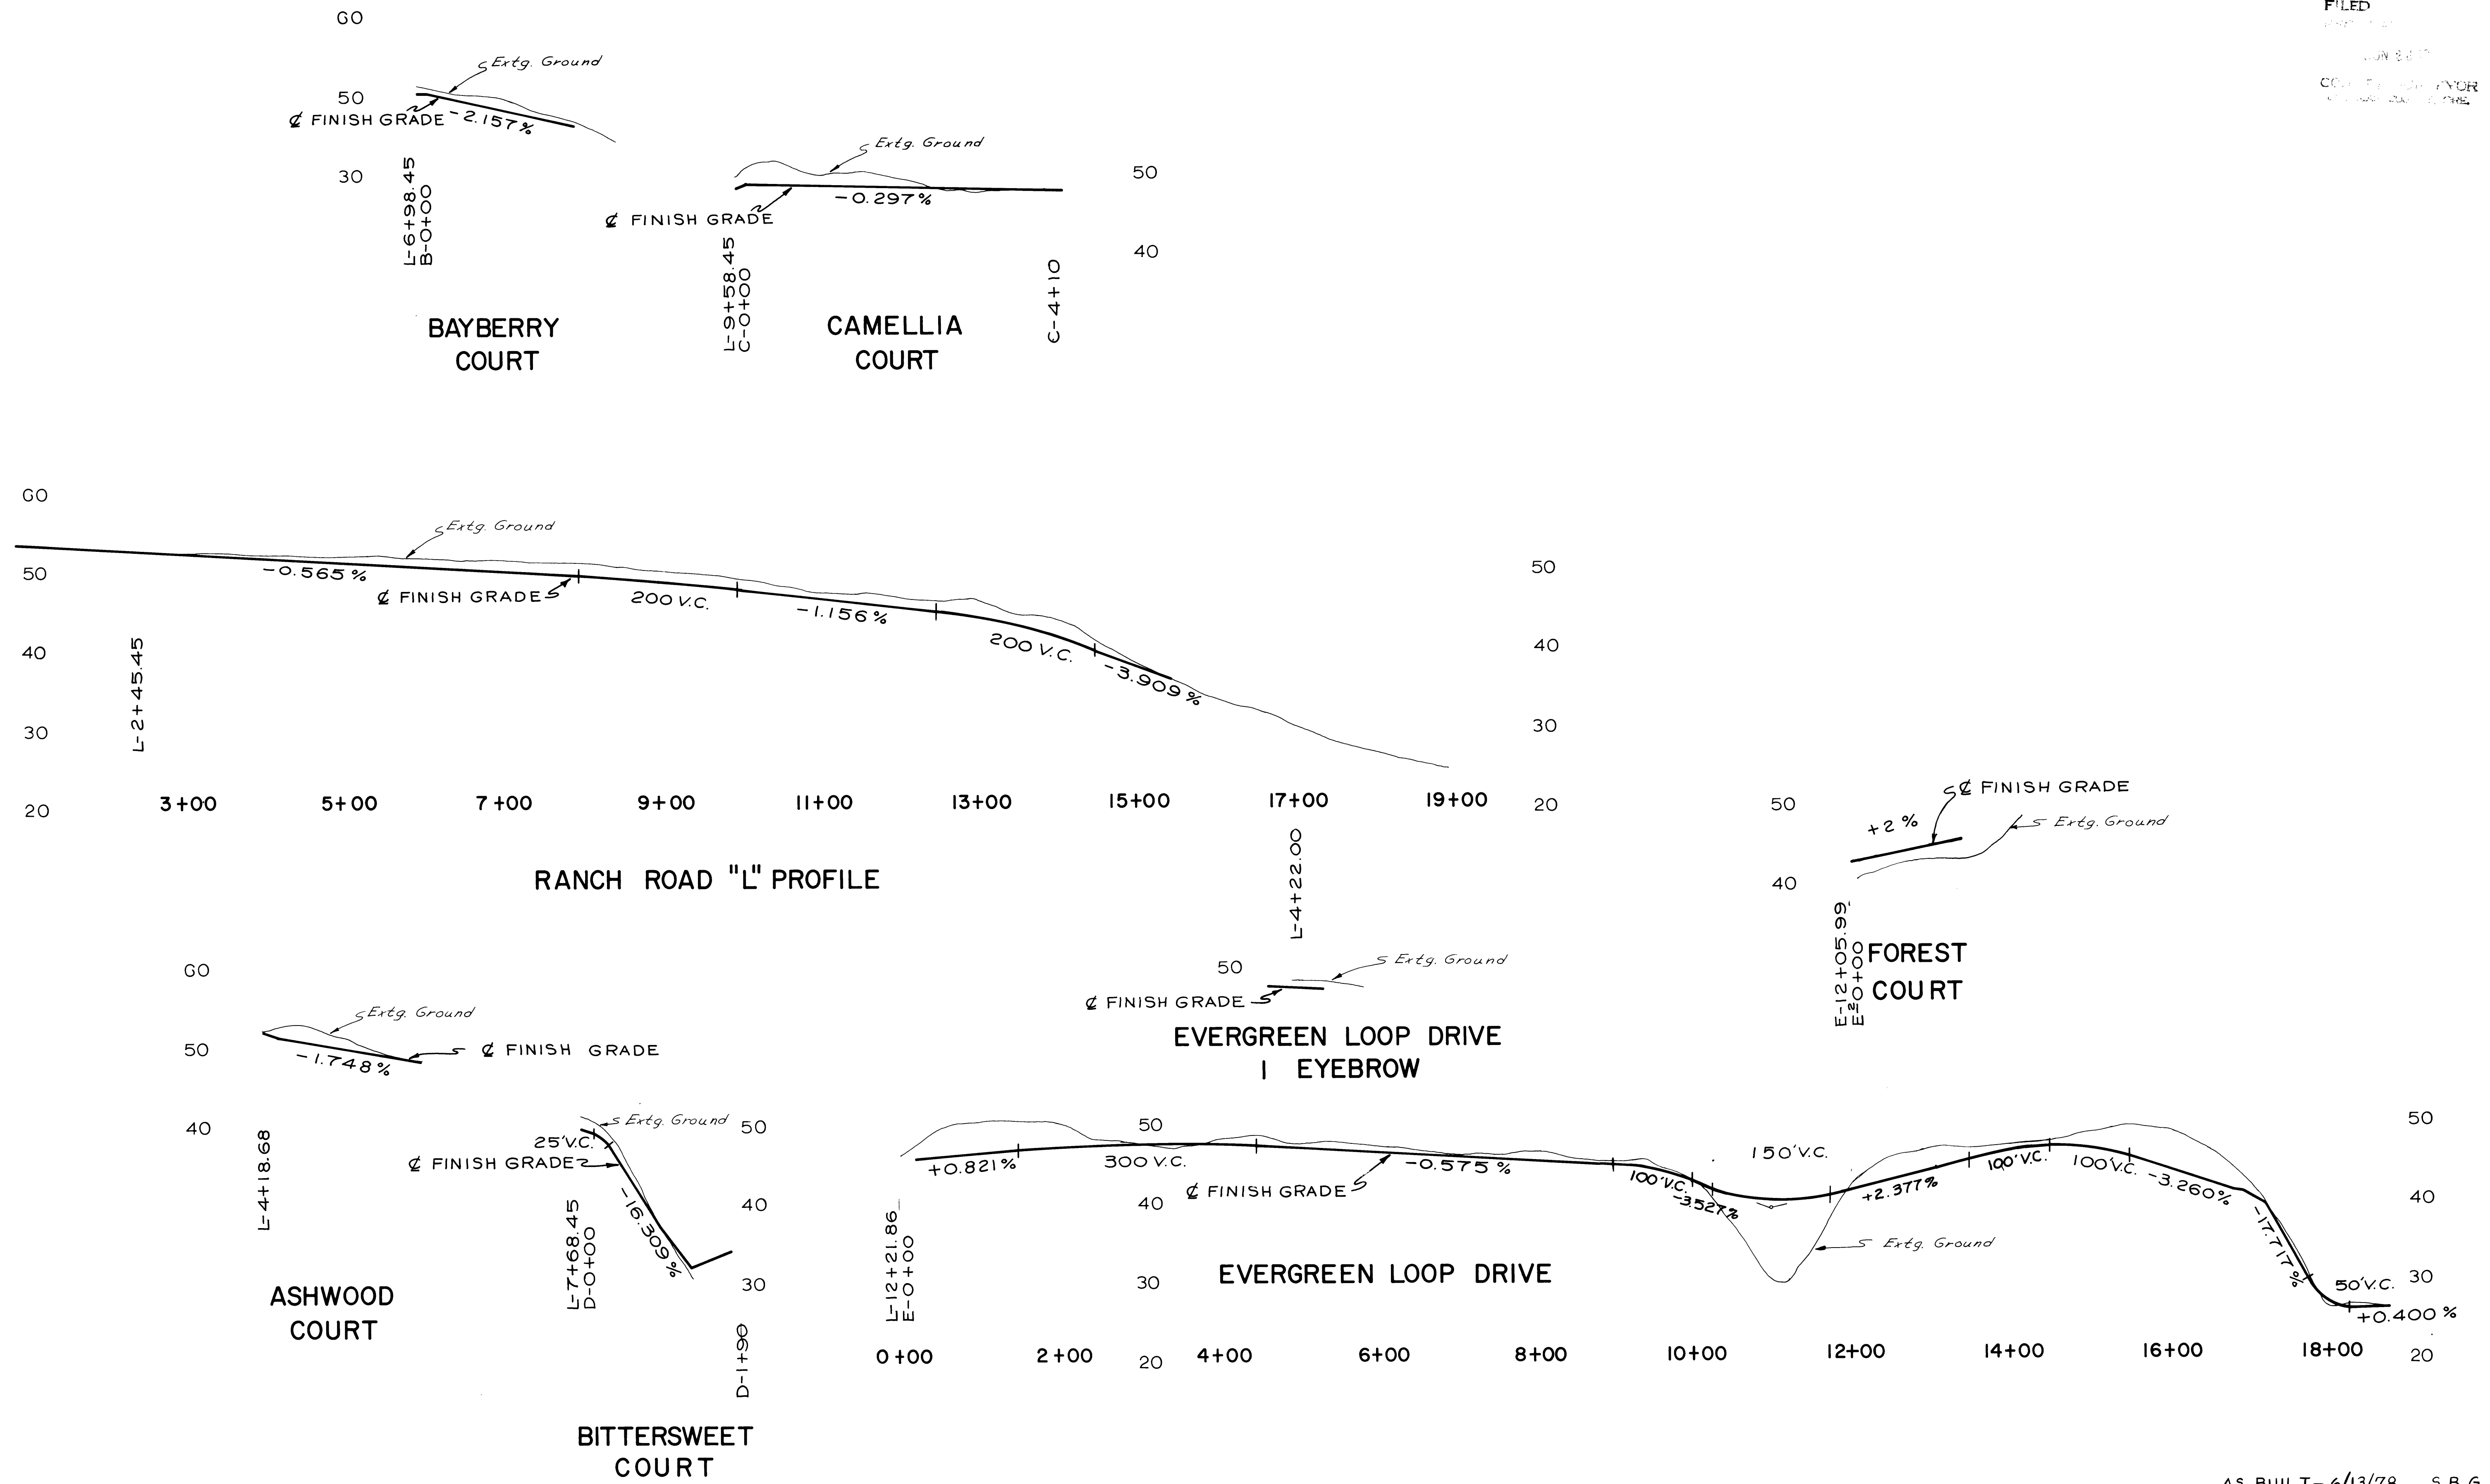

AS BUILT - 6/13/78 S.B.G
 DOUGLAS COUNTY
 PUBLIC WORKS DEPARTMENT
 FERN ACRES SUBDIVISION
 1976 SHT. 6
 GEORGE E. GRUBB, DIRECTOR