


- GENERAL NOTES - WATER AND SANITARY SEWER IMPROVEMENTS**
1. ALL WATER AND SANITARY SEWER IMPROVEMENTS SHALL BE CONSTRUCTED IN ACCORDANCE WITH TRI-CITY WATER AND SANITARY DISTRICTS' STANDARDS AND SPECIFICATIONS.
 2. IT SHALL BE THE RESPONSIBILITY OF THE CONTRACTOR TO CONTACT TRI-CITY WATER DISTRICT TO DETERMINE IF THE CONTRACTOR SHALL MAKE THE CONNECTION TO THE EXISTING 4-INCH WATER LINE OR IF THIS CONNECTION SHALL BE MADE BY DISTRICT FORCE.
 3. THE WATER LINE SHALL BE INSTALLED WITH 30-INCH MINIMUM COVER UNLESS OTHERWISE NOTED.
 4. THE SANDFILL ABOVE THE PIPE ZONE FOR WATER AND SANITARY SEWER LINES AND SERVICES SHALL BE WITH GRANULAR MATERIAL.
 5. WATER MAINS SHALL BE CONSTRUCTED OF CAST IRON OR CLASS 150 ASBESTOS-CEMENT PIPE CONFORMING TO CURRENT AMERICAN WATER WORKS ASSOCIATION (AWWA) STANDARDS.
 6. WATER HOUSE SERVICES SHALL BE 1/2-INCH DIAMETER TYPE K COPPER TUBING AND/OR OTHER MATERIALS APPROVED BY TRI-CITY WATER DISTRICT. THE SERVICES ARE TO BE TERMINATED WITH A CORPORATION STOP AT THE METER LOCATION.
 7. SANITARY SEWER LINES SHALL BE CONCRETE PIPE CONFORMING TO ASTM C-14, CLASS II, WITH ASTM C-150 CEMENT OR ASBESTOS-CEMENT PIPE - CLASS 2400 - CONFORMING TO ASTM C-488, TYPE II.
 8. SANITARY SEWER HOUSE SERVICES SHALL BE 4-INCH DIAMETER AT 2 PERCENT SLOPE UNLESS OTHERWISE NOTED. THEY SHALL BE OF THE SAME MATERIAL AS THAT USED FOR THE MAIN SEWER.
 9. A 2" x 4" STAKE PAINTED WHITE SHALL BE PLACED AT END OF EACH SERVICE TO MARK LOCATION.
 10. CONTRACTOR SHALL CONTACT TRI-CITY WATER DISTRICT TO OBTAIN DESIRED MANUFACTURERS OF FIRE HYDRANTS, BRASS AND VALVES.

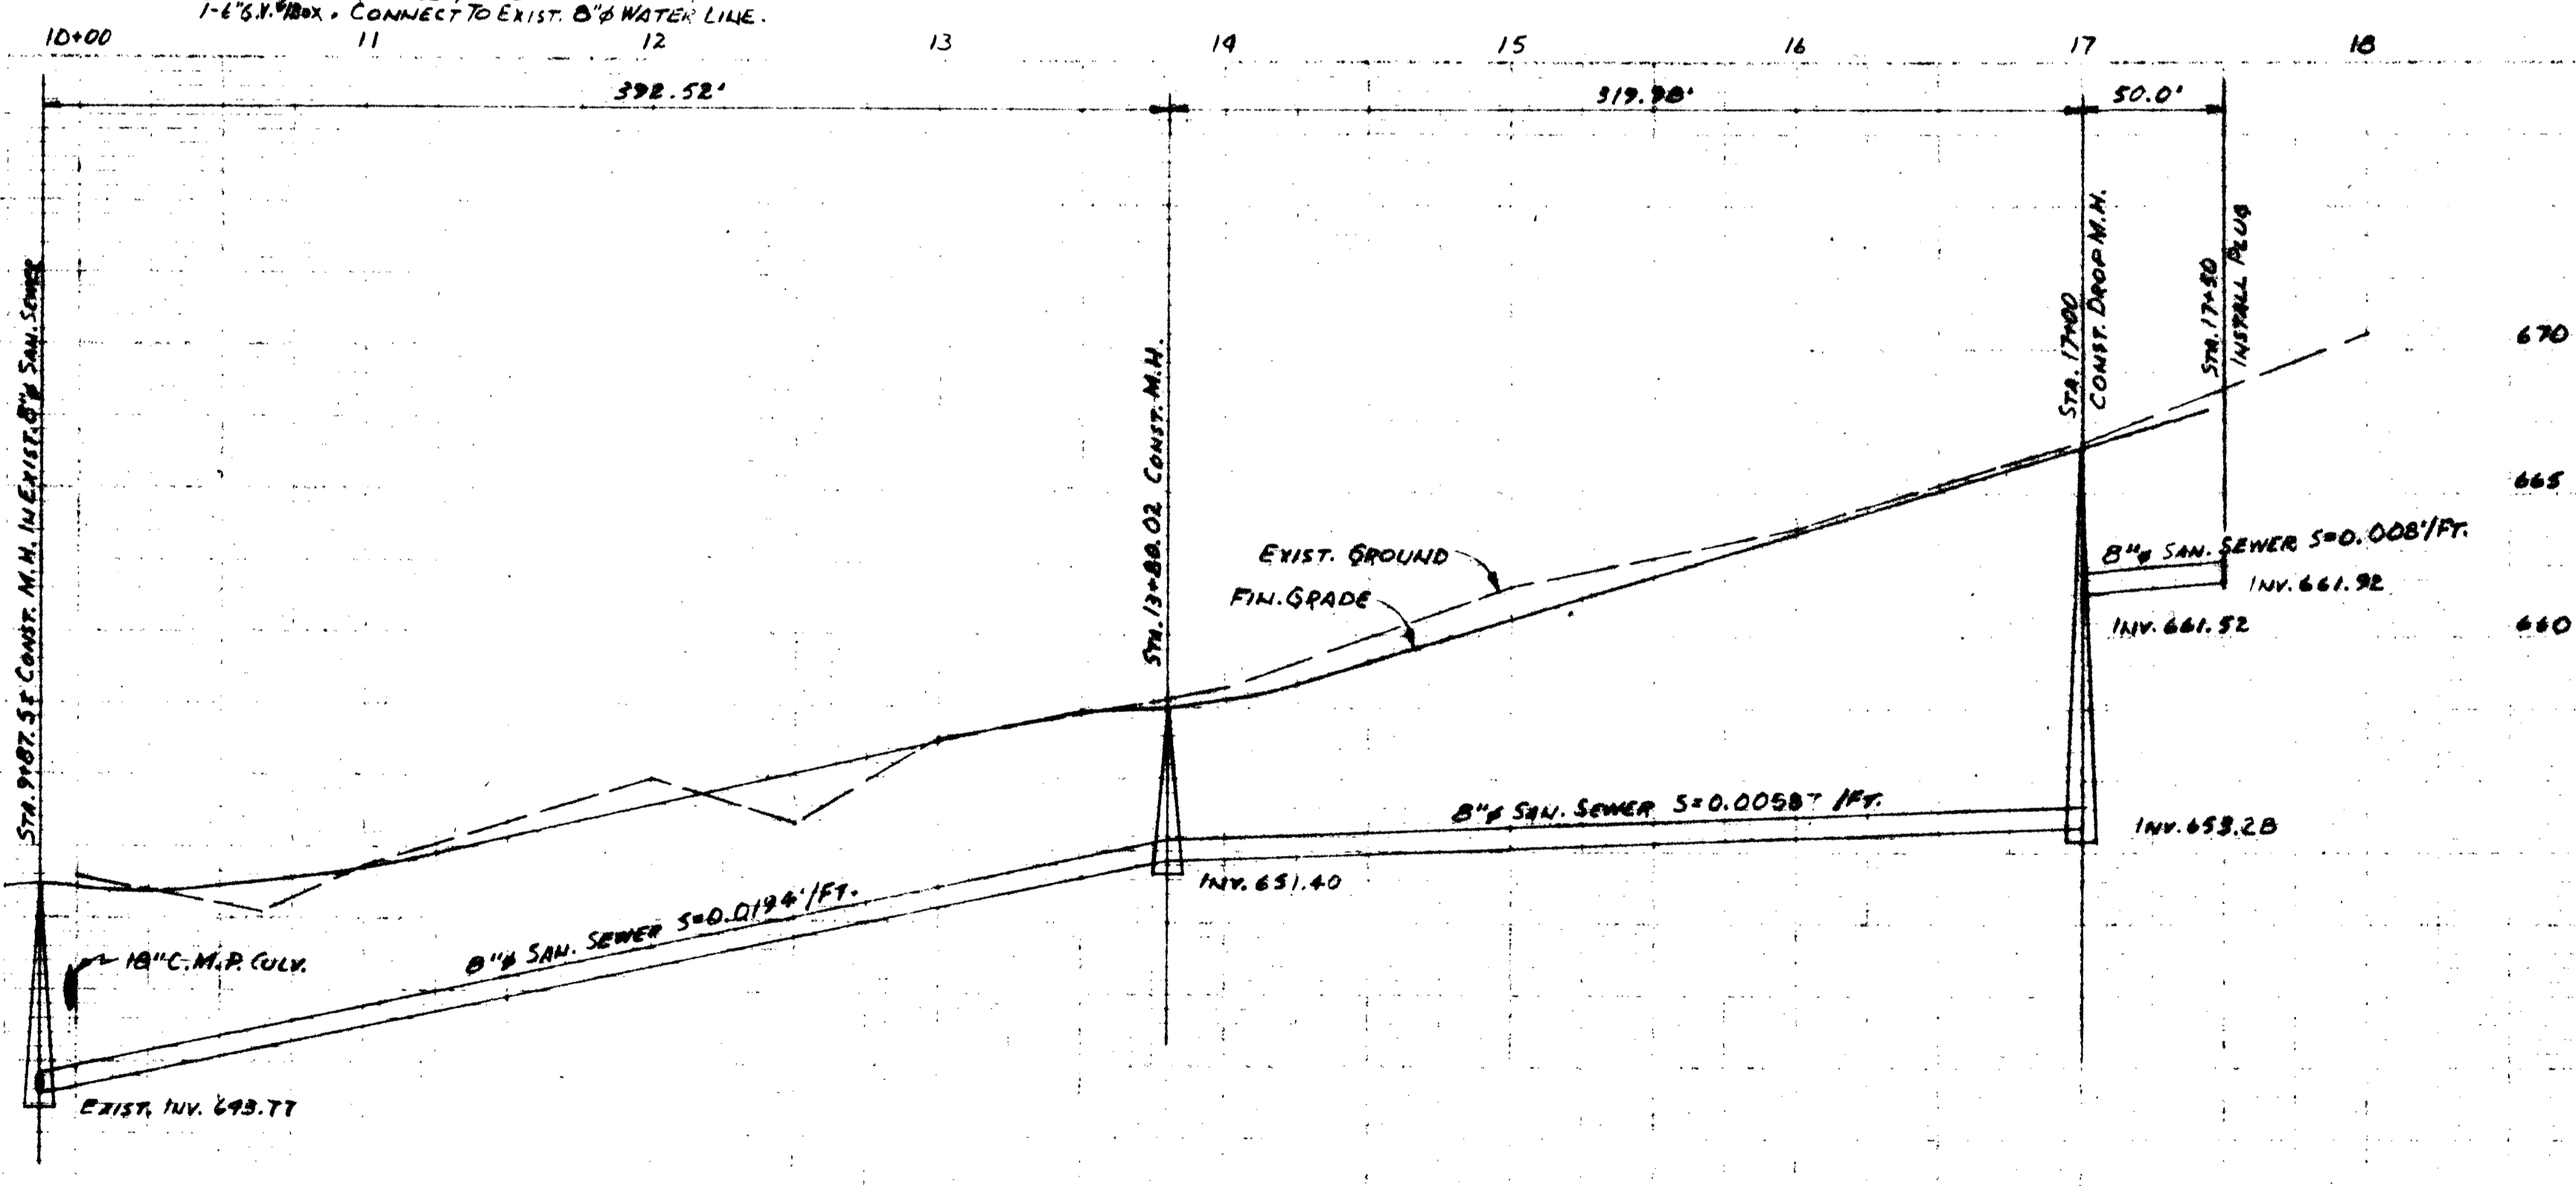

ASBUILT 12-9-77 JVB

REVISED 8-25-77 1" WATER LINE IN GUINEVERE CT. TO 1 1/2" W. SEWER GRADATION
REVISED 8-8-77 SAN. SEWER SERVICE TO LOTS B & C, BLK. 1

VIC J. & KIP A. RICE		MYRTLE CREEK, OREGON	
CAMELOT PLACE SUBDIVISION - PHASE I WATER & SANITARY SEWER IMPROVEMENTS			
	C & G ENGINEERING ENGINEERING ARTS BUILDING 3274 Commercial, S. E. SALMON, OREGON		SHEET 4 3
	DATE: JULY, 1977		JOB NO. 6150.0042