


LEBLANC SUBDIVISION


FILED
 Date: 9-1-1998 By: P
 This survey consists of:
 Map:
 Narrative:
 Corner Ppt:
 DOUGLAS COUNTY
 SURVEYOR

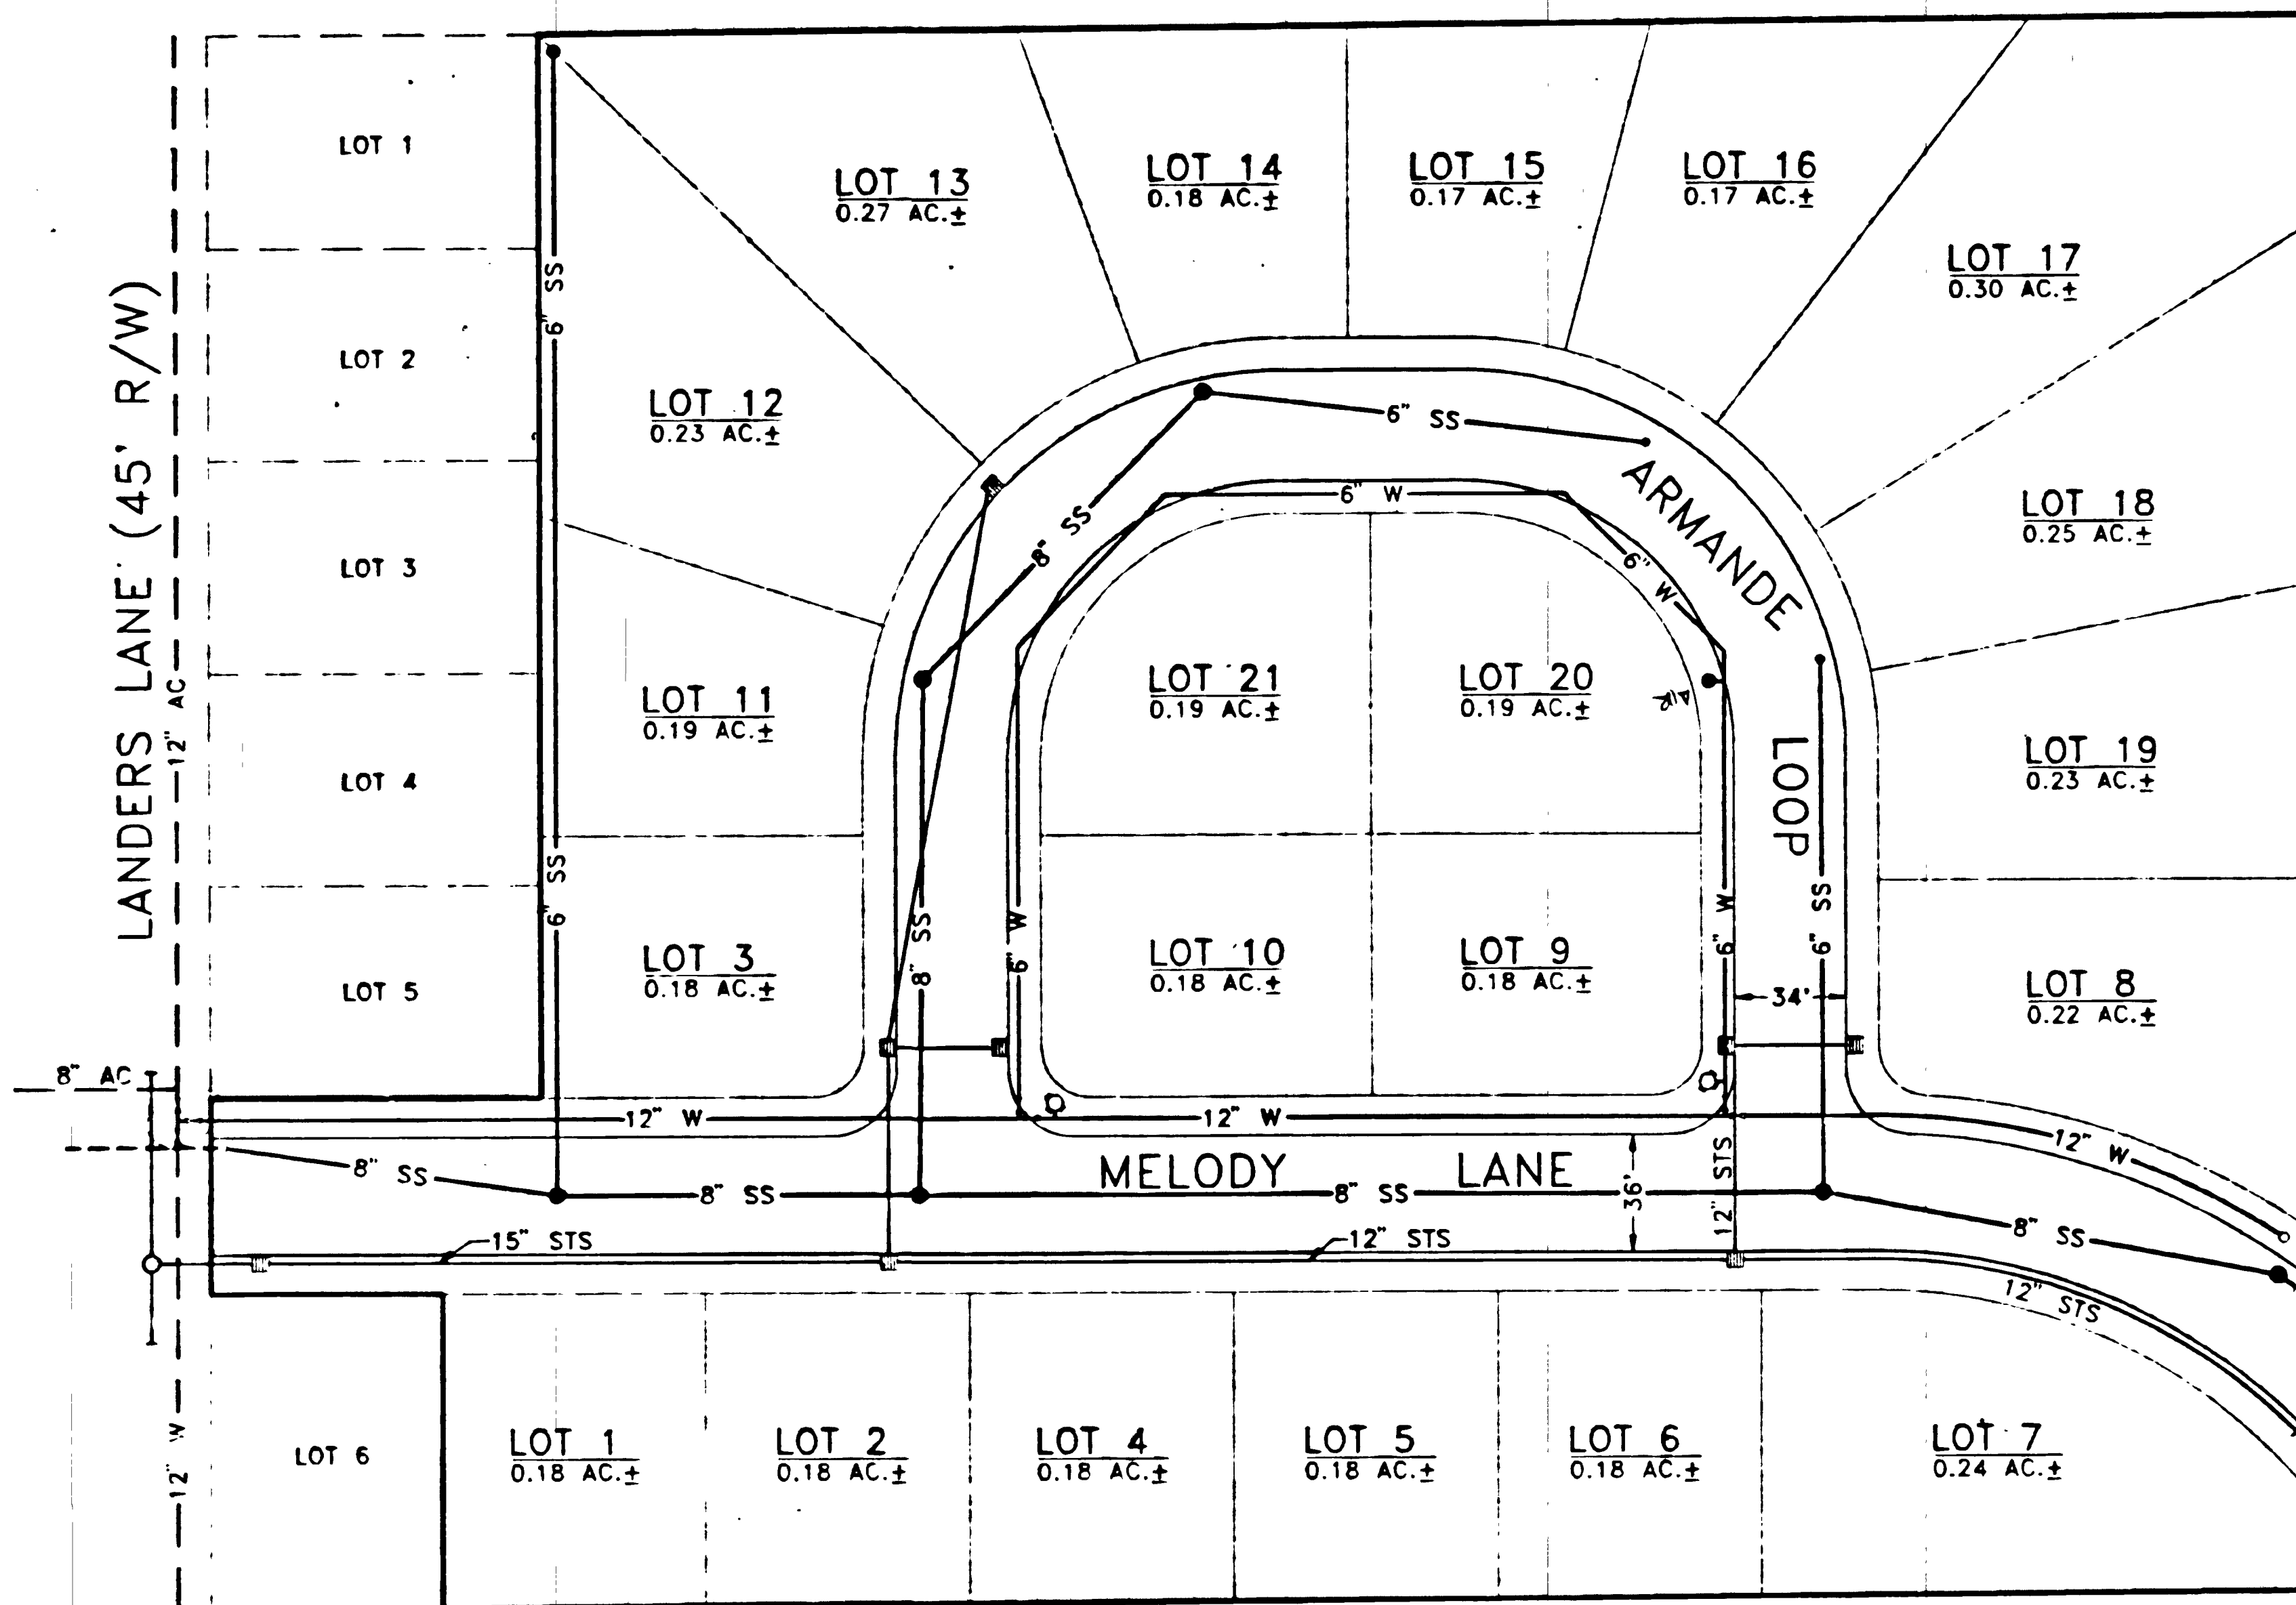

OVERALL PLAN
 SCALE: 1" = 40'

SHEET INDEX

- SHT. 1 COVER & OVERALL PLAN
- SHT. 2 MELODY LANE PLAN & PROFILE
- SHT. 3 MELODY LANE PLAN & PROFILE AND STD. DETAILS
- SHT. 4 ARMANDE LOOP PLAN & PROFILE AND STD. DETAILS
- SHT. 5 ARMANDE LOOP PLAN & PROFILE AND GENERAL NOTES
- SHT. 6 SANITARY SEWER PLAN & PROFILE
- SHT. 7 WATERLINE DETAILS

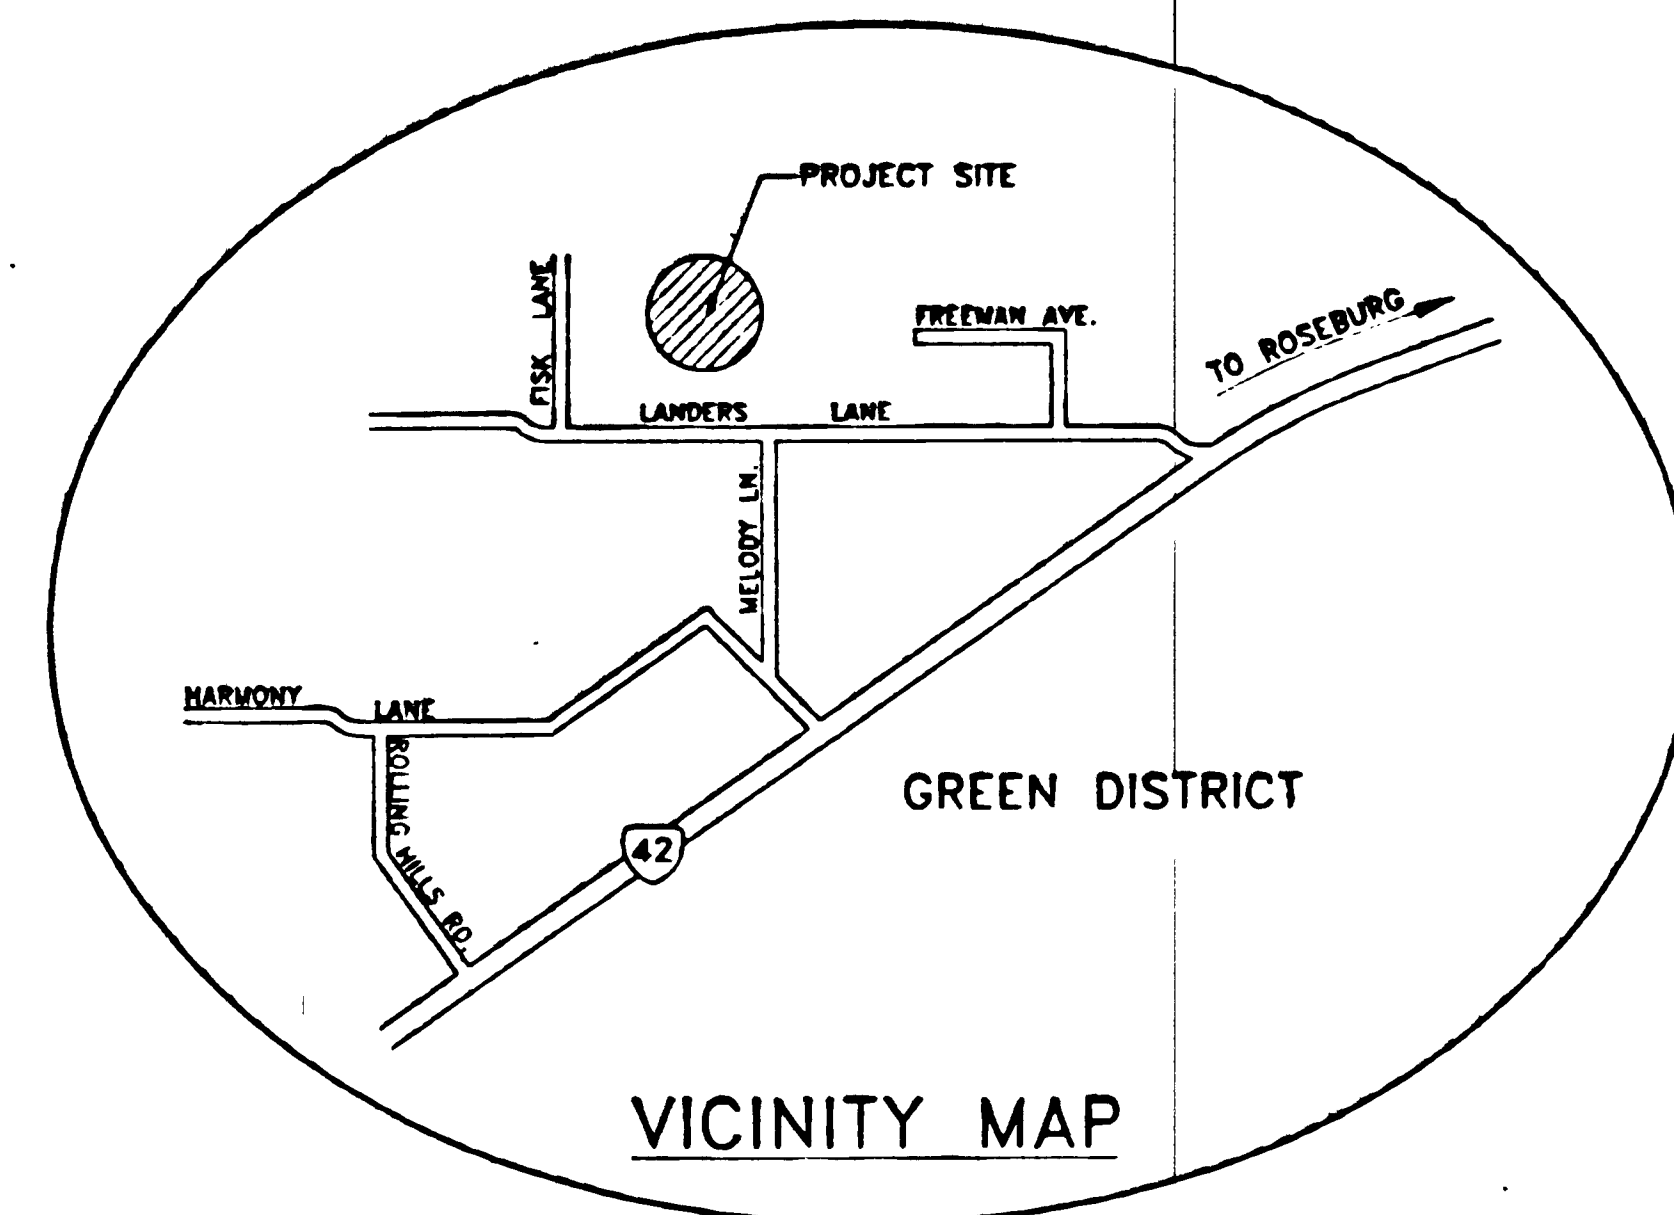


LEGEND


- SS PROPOSED SANITARY SEWER MAINLINE
- W PROPOSED WATER MAINLINE
- STS PROPOSED STORM SEWER MAINLINE
- PROPOSED MANHOLE
- EXISTING MANHOLE
- PROPOSED SANITARY SEWER CLEANOUT
- ⊕ PROPOSED FIRE HYDRANT
- ⊗ PROPOSED WATER VALVE
- ▣ PROPOSED GUTTER INLET
- ⊞ PROPOSED WATER SERVICE
- PROPOSED 2" BLOWOFF

MOVED TO CO. RD. 288A

INSPECTED BY:
 L.A.A. SURVEYING SERVICE, INC.
 P. O. Box 130
 ROSEBURG, OREGON 97470

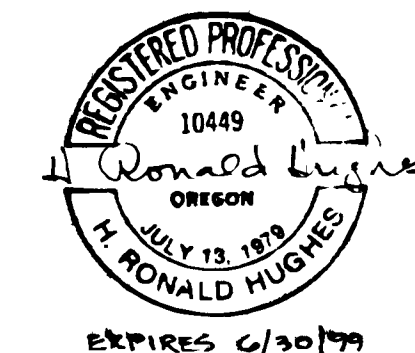

DESIGNED BY MIKE A. PARKER
 INSPECTED BY H. RONALD HUGHES

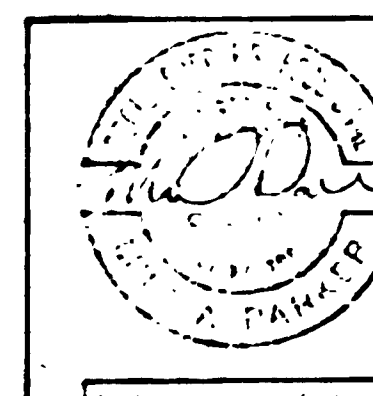

Rev.	Date	Dwg	Description
1	3-30-98	DAF	COUNTY/ROBERTS CREEK REVIEWS
2	4/25/98	DAF	ROBERTS CREEK WATER DIST COMMENTS
3	5/20/98	DAF	COUNTY FINAL REVIEW
4	7/24/98	HRM	As BUILT

i.e.
 546 CE Jackson Street
 Roseburg, Oregon 97470
 PHONE (541) 673-0164
 FAX (541) 440-9392

Project Name
LEBLANC SUBDIVISION
STREET IMPROVEMENT PLANS

DES OK	PROJECT NO. 137-01
DWG DAF	DATE: DECEMBER 1998
CHK SH	SCALE: 1" = 40'
APP MAF	SHEET 1 OF 7

DS-105

DO NOT REPLICATE