



- WETLAND AREA - 11574 SQ FT (0.266 AC)
- MITIGATION WETLAND - 5336 SQ FT (0.123 AC)
- IMPACTED WETLAND - 3356 SQ FT (0.077 AC)

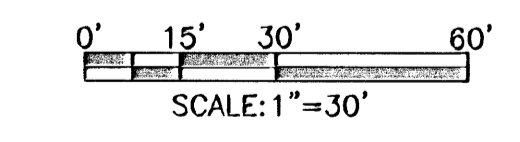

CALL BEFORE YOU DIG 1
ONE CALL (800) 332-2344
 OAR 952-001-0010 THROUGH
 OAR 952-001-0090

i.e. ENGINEERING
 809 SE Pine Street
 Roseburg, Oregon 97470
 PHONE (541) 673-0166
 FAX (541) 440-9392
 jemail@ieengineering.com
 Project Name:

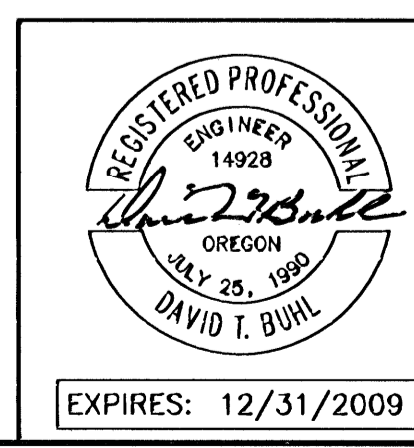

Rev.	Date	Dwg	Description
1	4/20/07	BWC	AGENCIES REVIEW
3	3/18/09	ANY	AS-BUILTS

Title: CAMELOT	
OVERALL	
DES JPM	PROJECT NO. 973-21
DWG BWC	DATE: MARCH 27, 2007
CHK SNL	SCALE: AS SHOWN
APP SNL	SHEET: 2 OF 10

DO NOT DUPLICATE