


FILED
 Date: 1/10/09 By: M.W.
 This survey consists of:
 Map DS-114 Tract 1A
 Narrative: _____
 Corner Ppt: _____
DOUGLAS COUNTY
SURVEYOR


SEED AND MULCH ALL
 DISTURBED AREAS

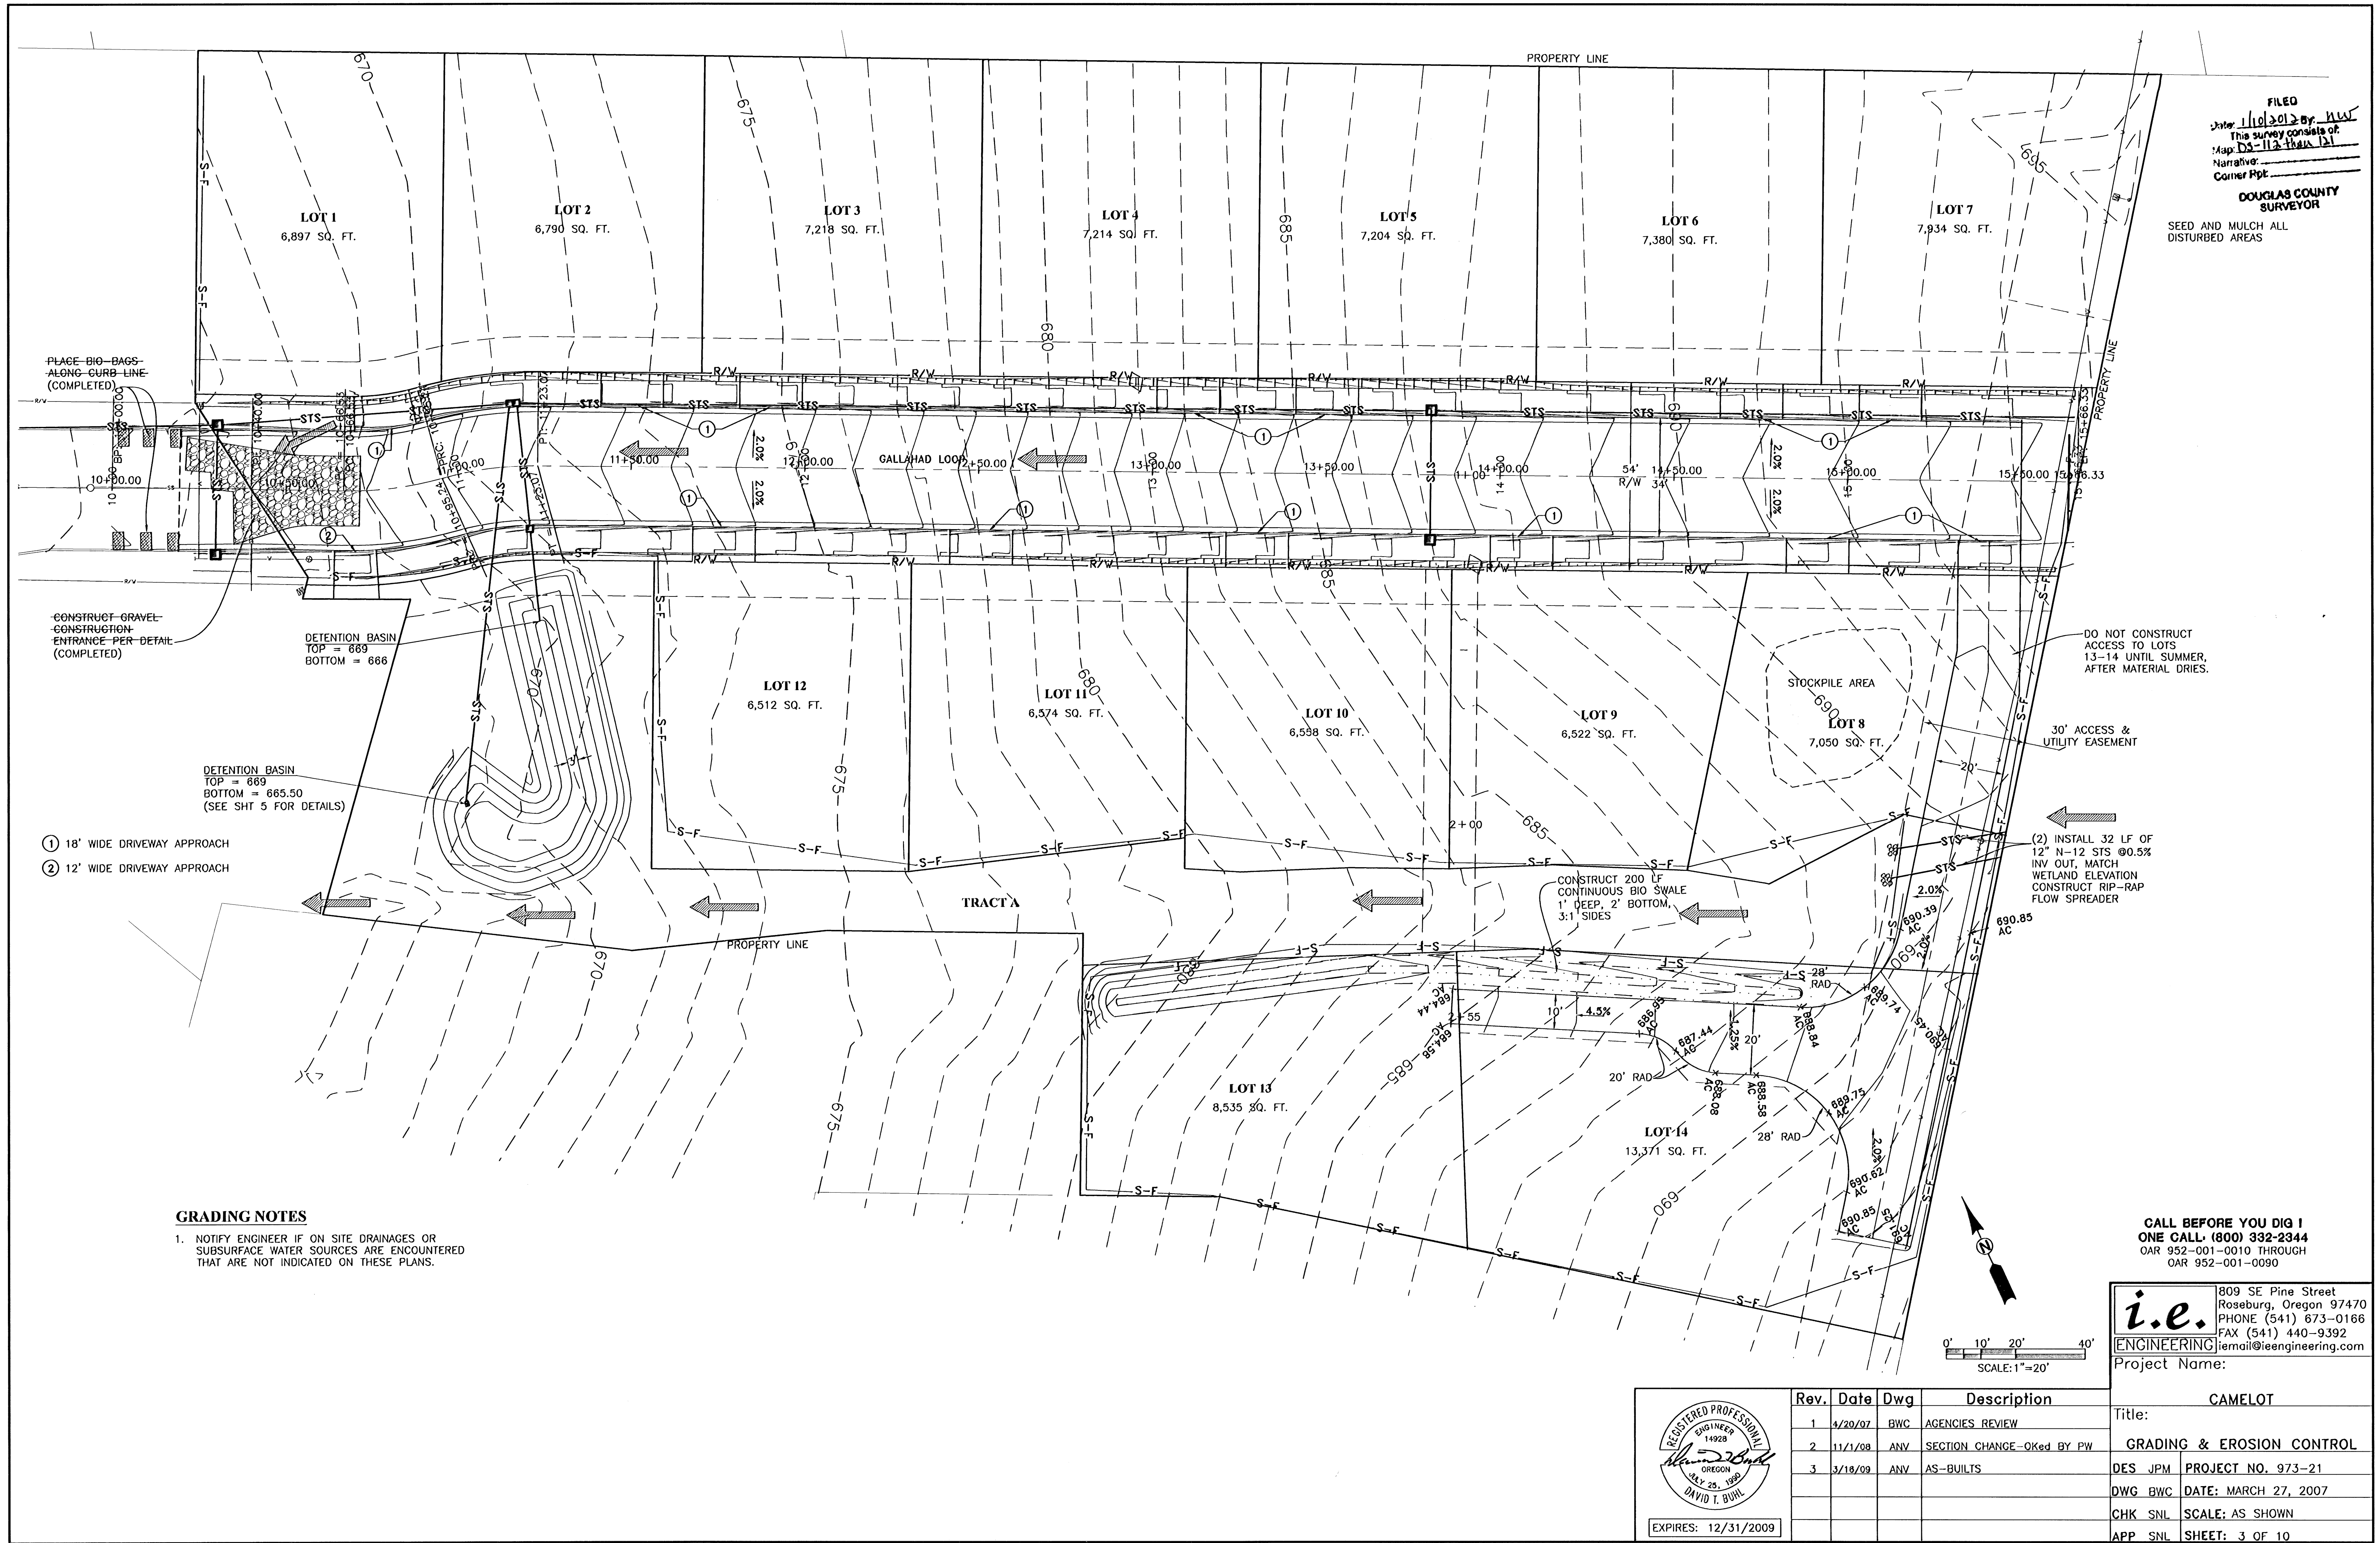

GRADING NOTES
 1. NOTIFY ENGINEER IF ON SITE DRAINAGES OR SUBSURFACE WATER SOURCES ARE ENCOUNTERED THAT ARE NOT INDICATED ON THESE PLANS.

CALL BEFORE YOU DIG 1
ONE CALL (800) 332-2344
 OAR 952-001-0010 THROUGH
 OAR 952-001-0090

i.e. ENGINEERING
 809 SE Pine Street
 Roseburg, Oregon 97470
 PHONE (541) 673-0166
 FAX (541) 440-9392
 Email: iemail@ieengineering.com
 Project Name: CAMELOT

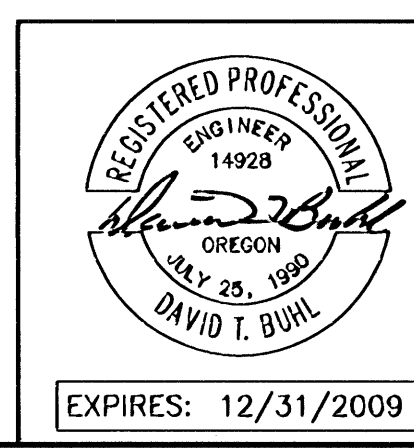

Rev.	Date	Dwg	Description
1	4/20/07	BWC	AGENCIES REVIEW
2	11/1/08	ANV	SECTION CHANGE - OKed BY PW
3	3/18/09	ANV	AS-BUILTS

Title: CAMELOT	
DES JPM	PROJECT NO. 973-21
DWG BWC	DATE: MARCH 27, 2007
CHK SNL	SCALE: AS SHOWN
APP SNL	SHEET: 3 OF 10

DO NOT DUPLICATE