


MAP Engineering, Inc.
 741 SE JACKSON STREET
 ROSEBURG, OREGON 97470
 PHONE: (541) 229-0365 FAX: (541) 229-0353
 EMAIL: info@mapengineeringinc.com

STATION	AREAS Square Feet		VOLUMES Cubic Yards		CUMULATIVE VOLUMES Cubic Yards	
	CUT	FILL	CUT	FILL	CUT	FILL
100+18	0.00	0.00	0.00	0.00	0.00	0.00
100+25	0.00	0.00	27.32	0.00	27.32	0.00
100+50	59.01	0.00	54.64	0.00	81.96	0.00
100+75	59.01	0.00	62.15	0.00	144.10	0.00
101+00	75.23	0.00	69.66	0.00	213.76	0.00
101+25	75.23	0.00	75.20	0.00	288.96	0.00
101+50	87.19	0.00	80.73	0.00	369.70	0.00
101+75	87.19	0.00	64.07	0.04	433.77	0.04
102+00	51.20	0.08	47.41	0.08	481.18	0.12
102+25	51.20	0.08	29.33	5.23	510.50	5.35
102+50	12.14	11.22	11.24	10.39	521.75	15.73
102+75	12.14	11.22	8.67	13.37	530.42	29.10
103+00	6.59	17.66	6.10	16.35	536.52	45.46
103+25	6.59	17.66	26.83	9.40	563.35	54.86
103+50	51.37	2.64	47.56	2.44	610.91	57.30
103+75	51.37	2.64	62.32	1.22	673.23	58.52
104+00	83.24	0.00	77.08	0.00	750.31	58.52
104+25	83.24	0.00	81.10	0.00	831.41	58.52
104+50	91.94	0.00	85.13	0.00	916.54	58.52
104+75	91.94	0.00	75.87	0.00	992.41	58.52
105+00	71.94	0.00	66.61	0.00	1059.02	58.52
105+25	71.94	0.00	54.70	0.15	1113.72	58.68
105+50	46.21	0.33	42.78	0.31	1156.50	58.99
105+75	46.21	0.33	32.82	3.45	1189.32	62.43
106+00	24.68	7.11	22.85	6.59	1212.18	69.02
106+25	24.68	7.11	40.16	6.71	1252.34	75.73
106+50	62.06	7.37	57.47	6.83	1309.80	82.55
106+75	62.06	7.37	31.84	1.64	1341.64	84.20
106+85	109.86	1.51	0.00	0.00	1341.64	84.20

NOTES:
 1) VOLUMES ARE UNADJUSTED
 2) VOLUMES ARE PROVIDED FOR ESTIMATION PURPOSES ONLY
 3) PROVIDED VOLUMES ARE NOT INTENDED FOR USE IN CONTRACTOR TAKE-OFFS

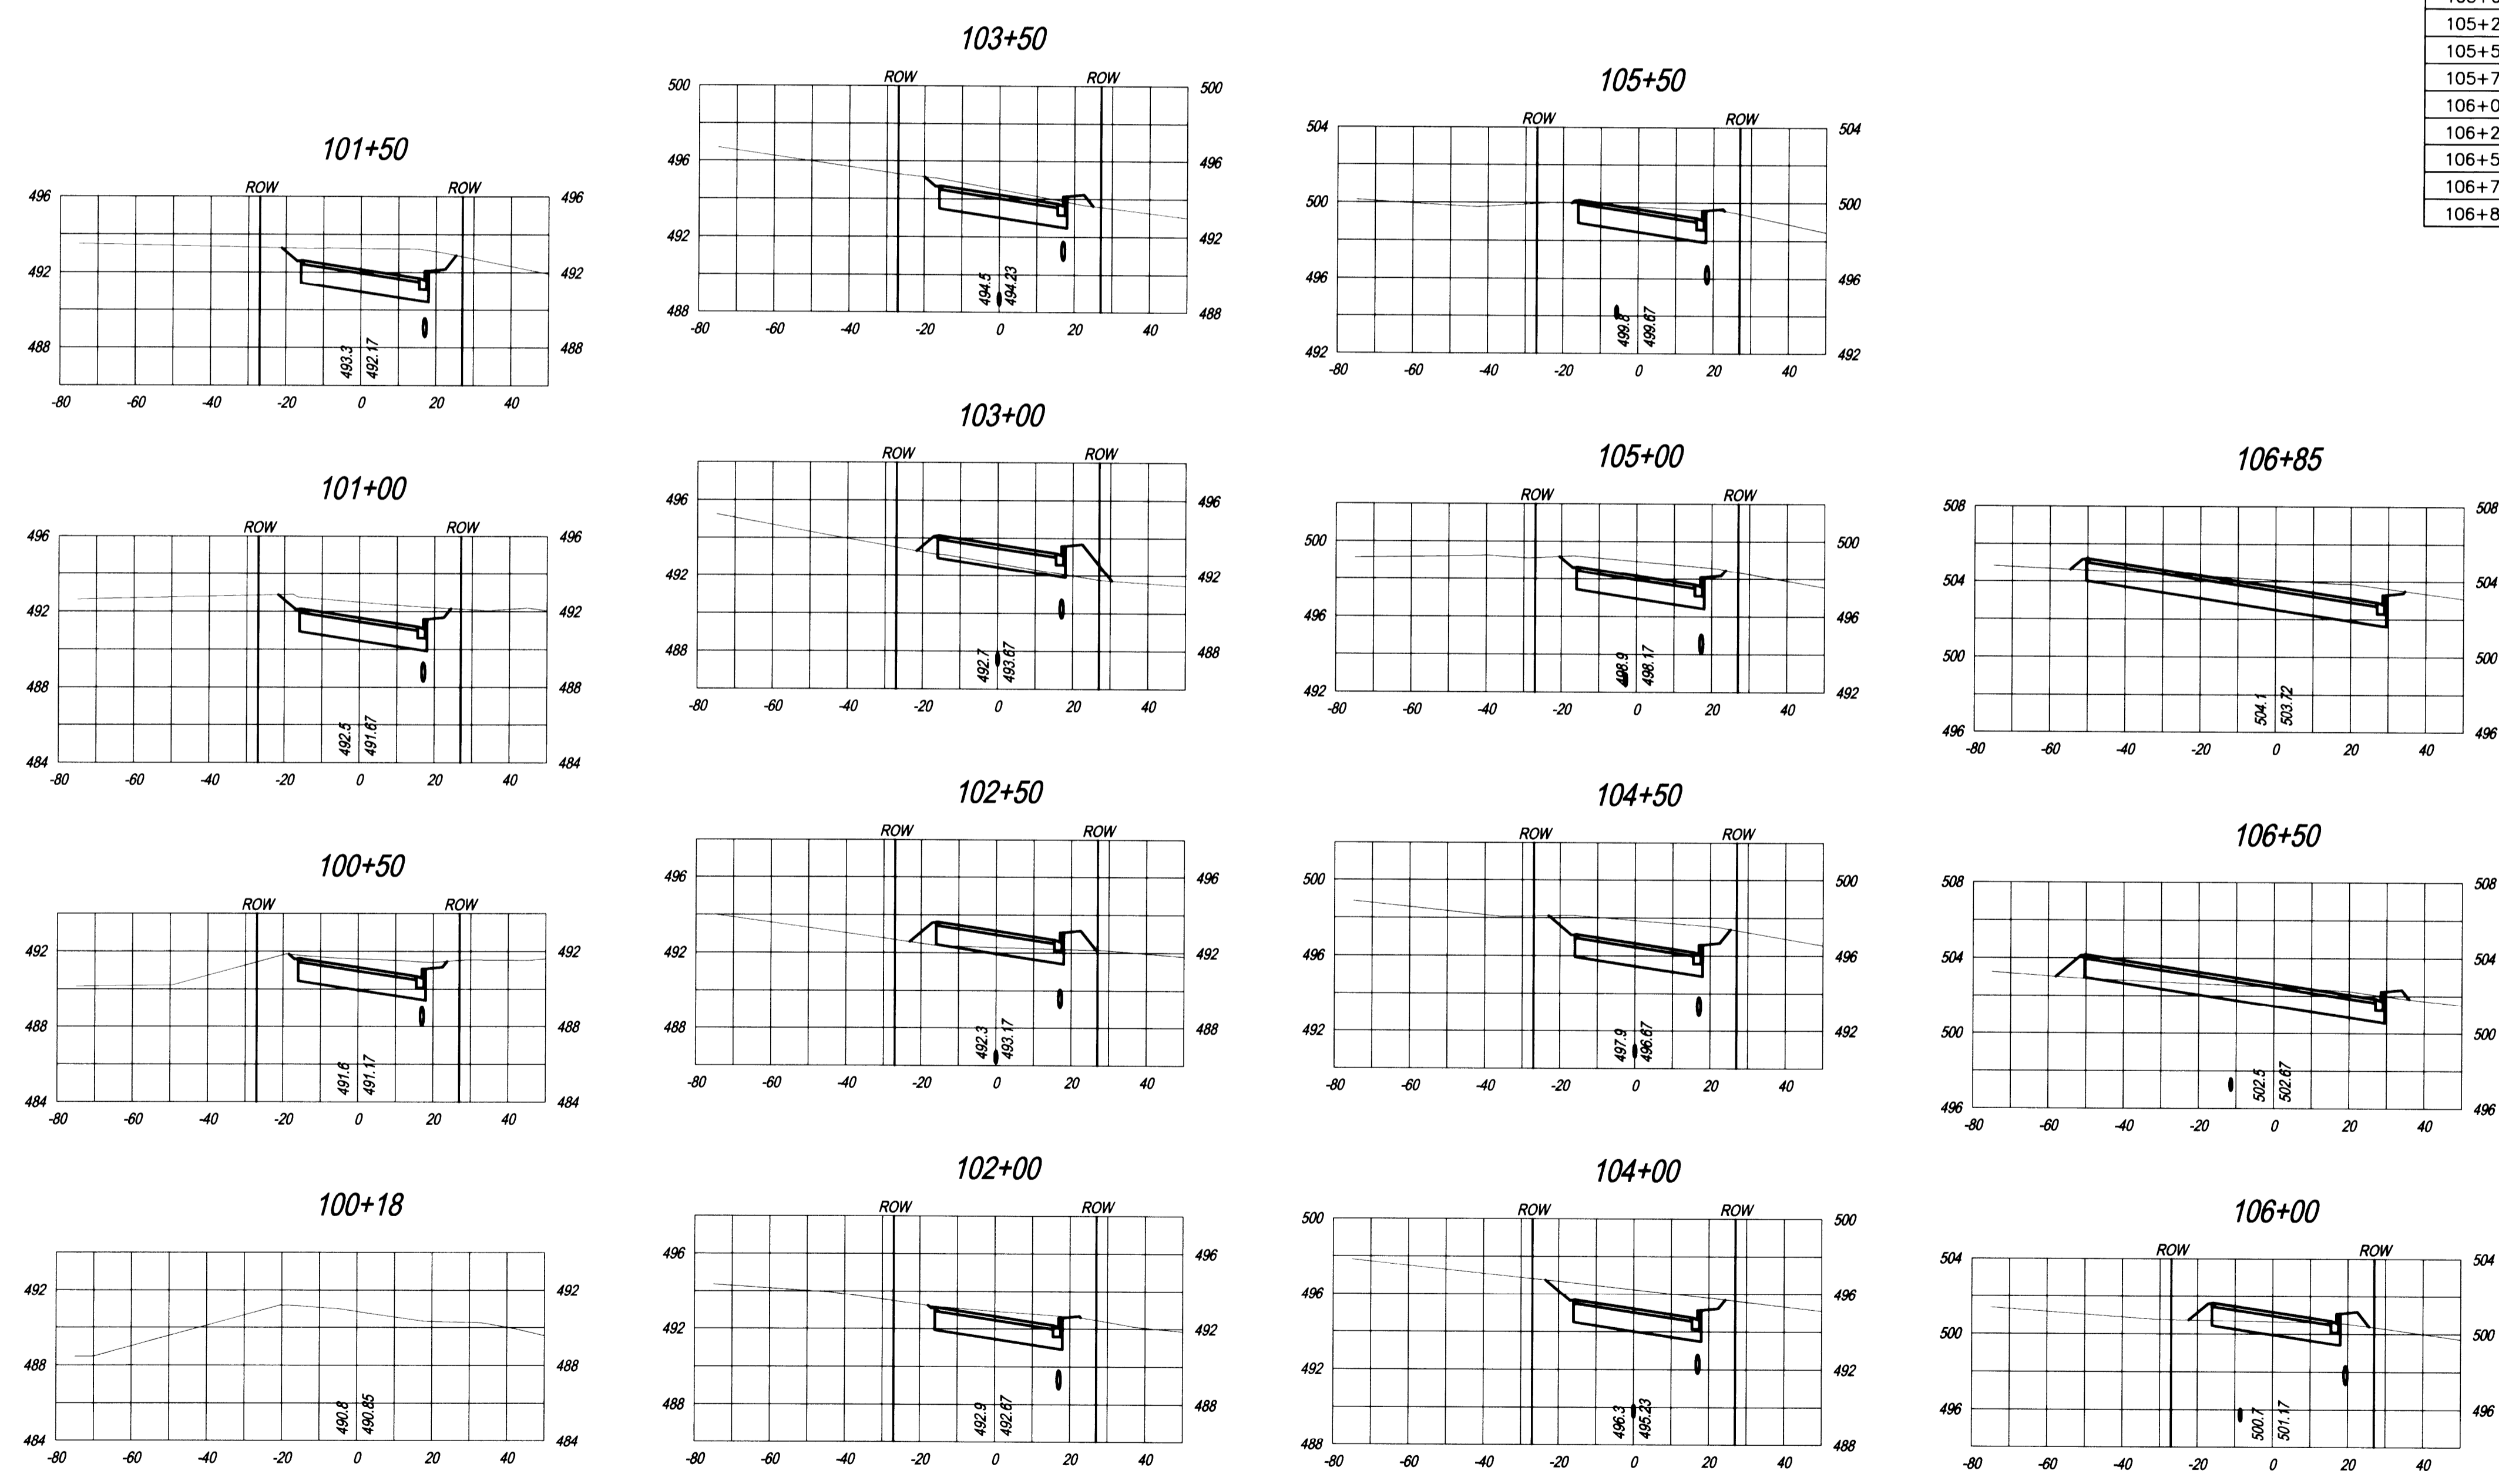

CROSS SECTIONS
 SCALE PER GRID

PROJECT NAME	KYLEE ESTATES ASBUILT DRAWINGS		
DRAWING TITLE	CROSS SECTIONS		
DATE	05/07/2007	DESIGNER	JCB
DWG SCALE	AS NOTED	DRAFTER	JCB
APPROVAL	MAP	PROJECT NO.	2065-01
REVISION #		BY	
DATE			

CALL BEFORE YOU DIG!
 ONE CALL: (800) 332-2344
 OAR 952-001-0010 THROUGH
 OAR 952-001-0090