

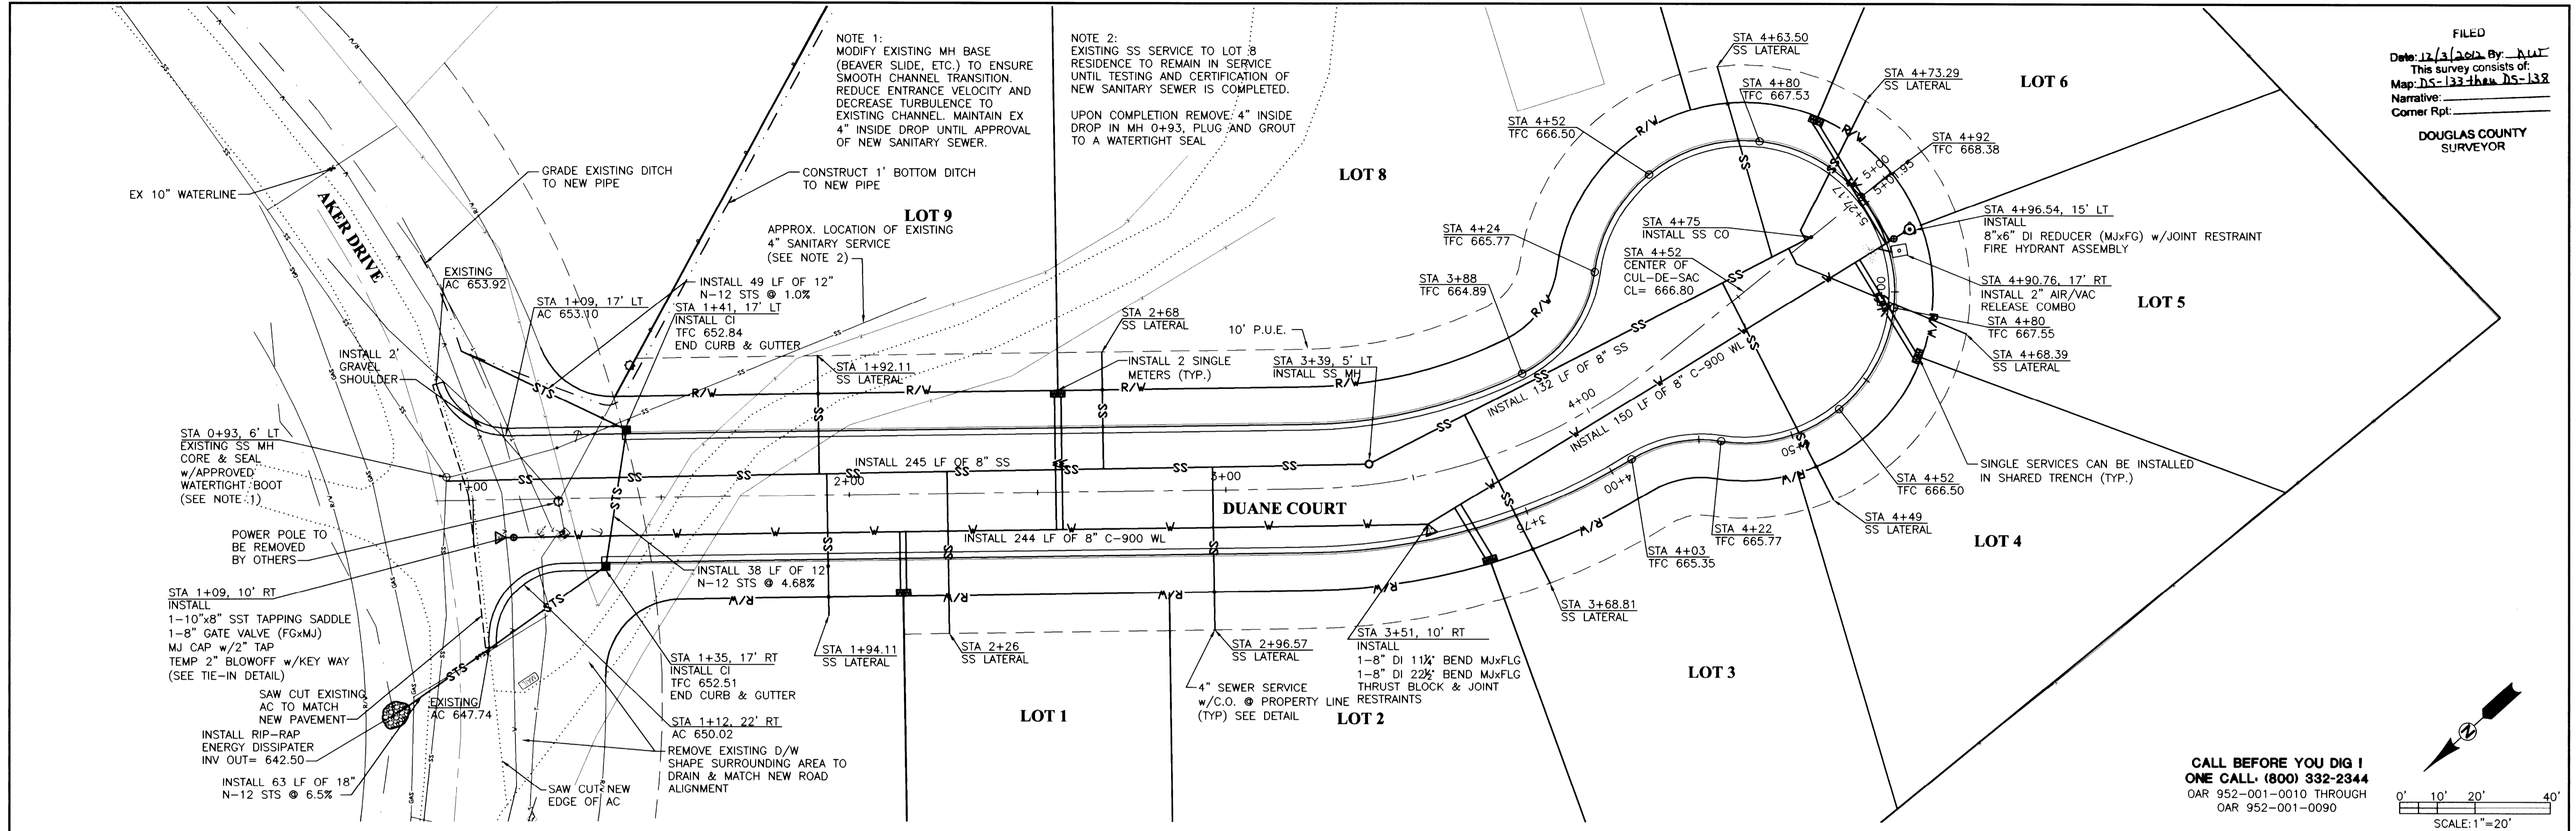


FILED  
 Date: 12/13/05 By: JDL  
 This survey consists of:  
 Map DS-133 thru DS-138  
 Narrative:  
 Corner Rpt:  
 DOUGLAS COUNTY  
 SURVEYOR

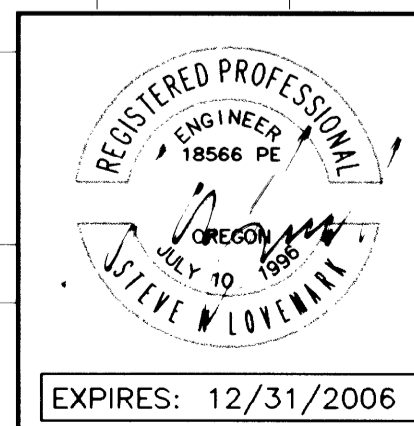

CALL BEFORE YOU DIG!  
 ONE CALL: (800) 332-2344  
 OAR 952-001-0010 THROUGH  
 OAR 952-001-0090

0' 10' 20' 40'  
 SCALE: 1"=20'

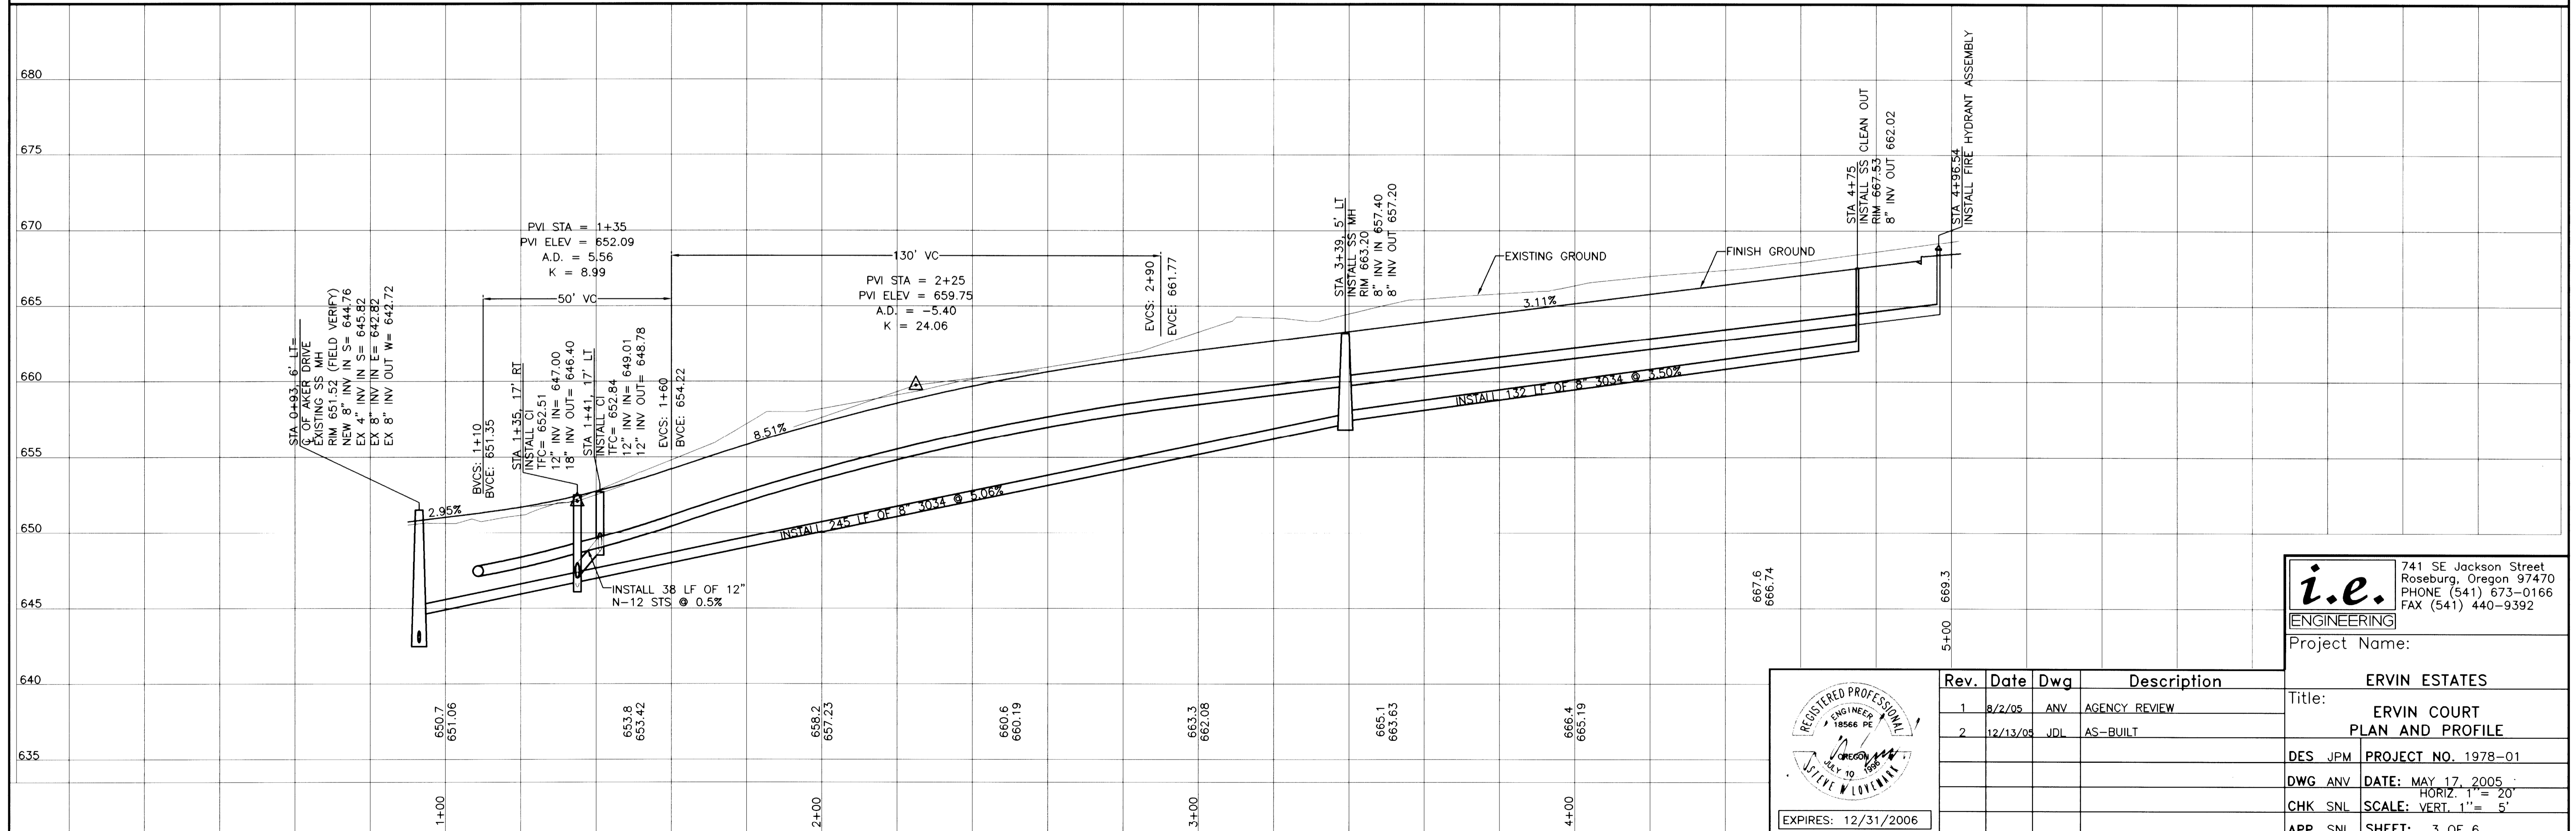

Rev.	Date	Dwg	Description
1	8/2/05	ANV	AGENCY REVIEW
2	12/13/05	JDL	AS-BUILT

**i.e.**  
 ENGINEERING  
 741 SE Jackson Street  
 Roseburg, Oregon 97470  
 PHONE (541) 673-0166  
 FAX (541) 440-9392

Project Name: ERVIN ESTATES  
 Title: ERVIN COURT  
 PLAN AND PROFILE  
 DES JPM PROJECT NO. 1978-01  
 DWG ANV DATE: MAY 17, 2005  
 CHK SNL SCALE: VERT. 1"= 20'  
 APP SNL SHEET: 3 OF 6  
 HORIZ. 1"= 20'  
 VERT. 1"= 5'
 DO NOT DUPLICATE