


130

North.

Yoncalla

Shutrens Addition to Yoncalla

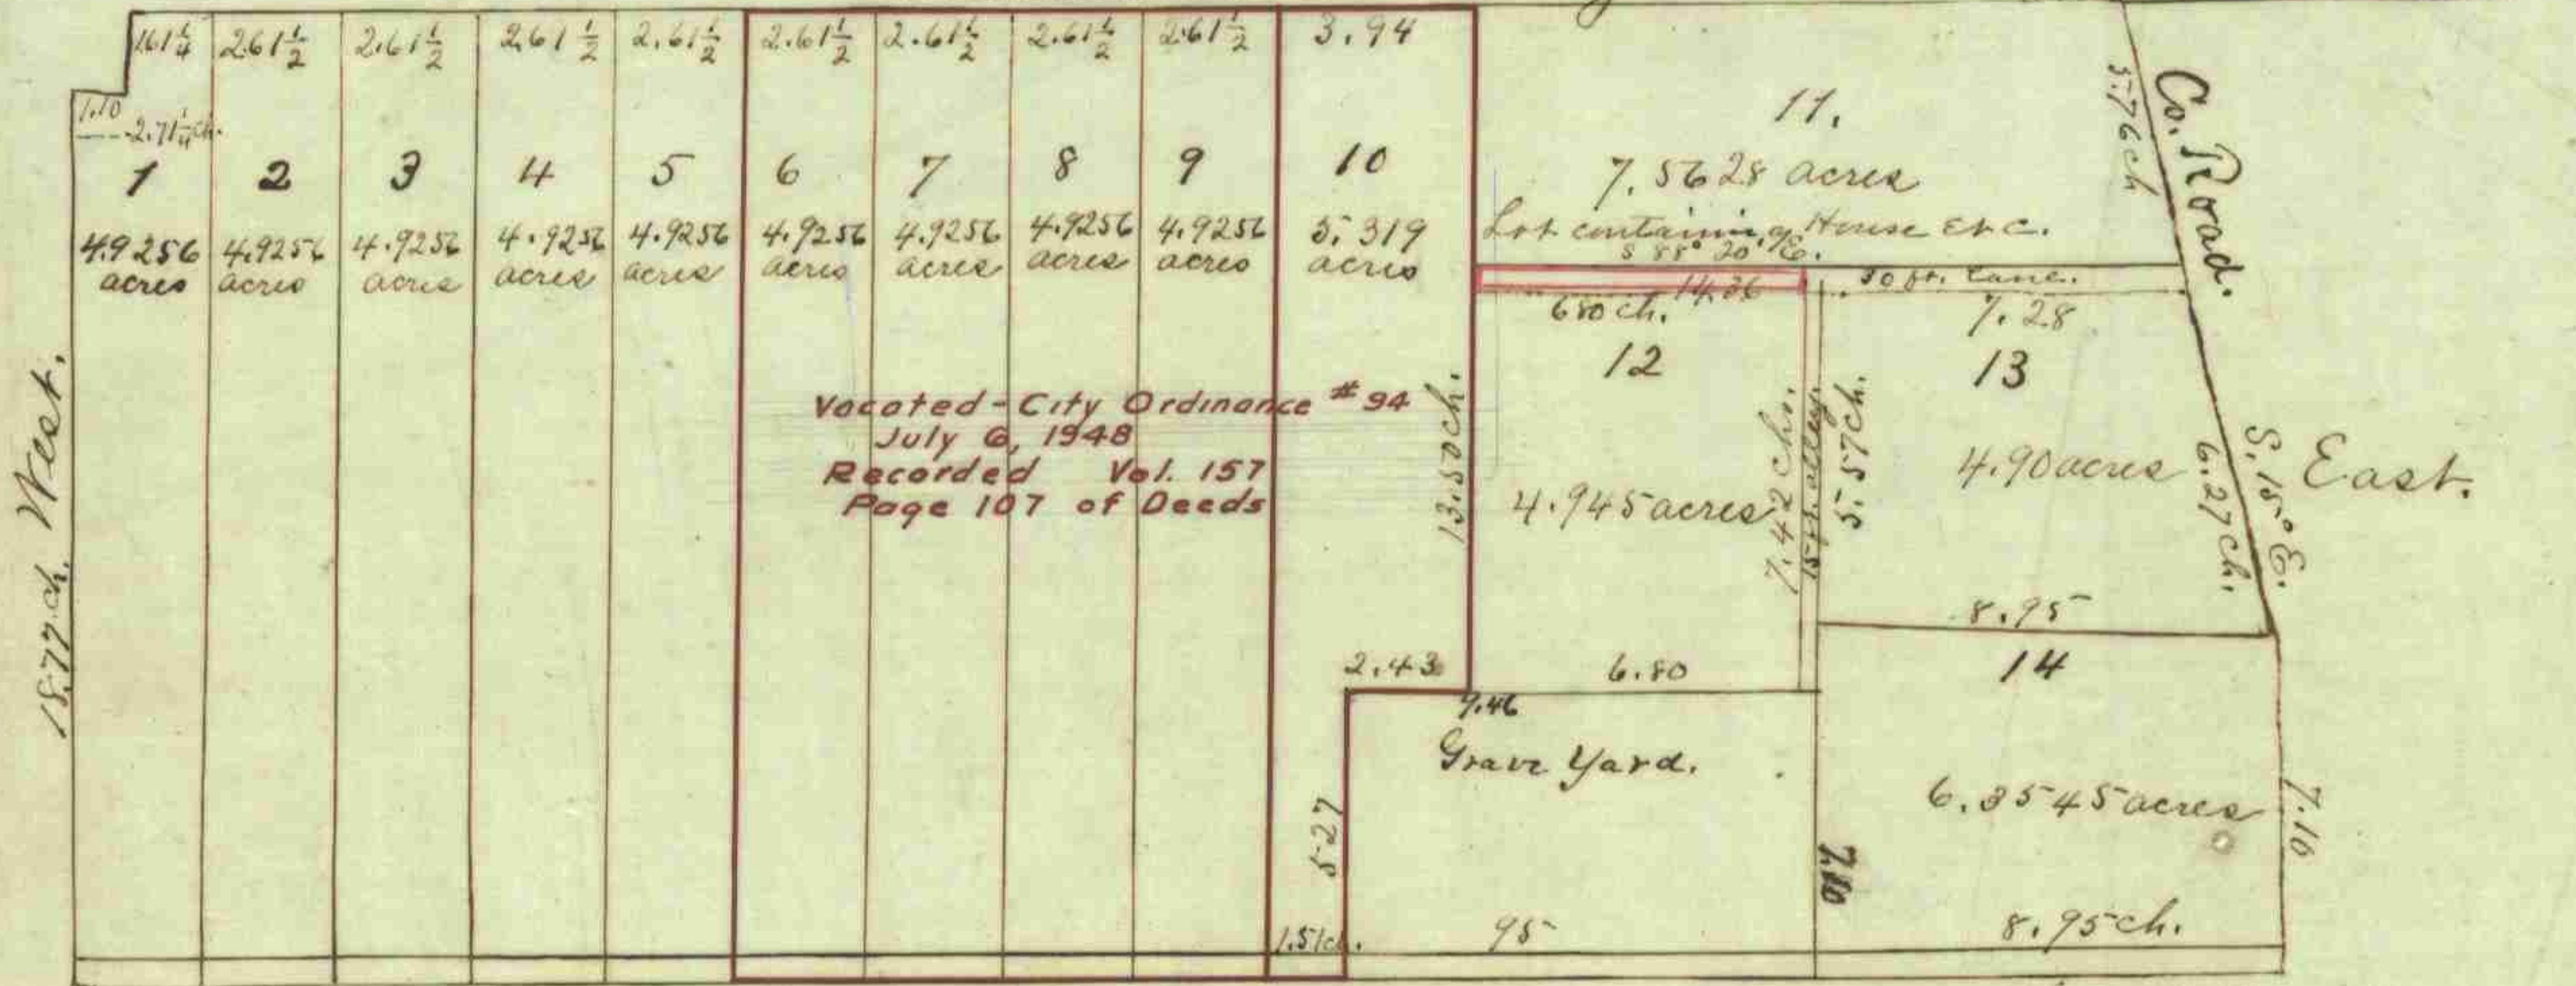

Vacated - City Ordinance # 94
July 6, 1948
Recorded Vol. 157
Page 107 of Deeds

Recorded Nov. 10, 1893

County Clerk.

Thos. E. Todd, Surveyor.

South.

1877 ch. West.

9

14