

THORNTONS ADDITION TO THE CITY OF ROSEBURG DOUGLAS CO. OREGON

—DEDICATION—

KNOW ALL MEN BY THESE PRESENTS, THAT WE, SAMUEL I. THORNTON AND MARY V. THORNTON ARE THE RIGHTFUL OWNERS OF LOT SEVENTEEN (17) IN THE "FIRST BROOKSIDE ADDITION" TO THE CITY OF ROSEBURG DOUGLAS COUNTY OREGON, AND WE HAVE CAUSED THE FOLLOWING DESCRIBED PORTION OF SAID PROPERTY TO-WIT- ALL THE NORTH FOUR HUNDRED AND FIFTY FEET OF LOT 17 OF THE FIRST BROOKSIDE ADDITION TO THE CITY OF ROSEBURG, DOUGLAS COUNTY OREGON, SITUATE IN THE WM. F. PERRY DONATION LAND CLAIM NO. 38, ALL IN T. 27 S., R. 5 W. WILLAMETTE MERIDIAN- TO BE SURVEYED AND PLATTED INTO LOTS, BLOCKS, STREETS AND ALLEYS AS SHOWN ON THE ACCOMPANYING PLAT, AND WE HEREBY DEDICATE ALL STREETS AND ALLEYS AS SHOWN ON SAID PLAT TO THE USE OF THE PUBLIC FOREVER.

FRANK G. MICELLI
JOHN T. LONG
WITNESSES

(SGD) SAMUEL I. THORNTON (SEAL)
(SGD) MARY V. THORNTON (SEAL)

SUBSCRIBED AND SWORN TO BEFORE ME THIS 28th DAY OF JANUARY, 1909
(SEAL) (SGD) FRANK G. MICELLI, NOTARY PUBLIC

STATE OF OREGON }
COUNTY OF DOUGLAS } SS

I, BEN B. IRVING, COUNTY SURVEYOR OF DOUGLAS COUNTY OREGON DO HEREBY CERTIFY THAT THIS COPY OF "THORNTONS ADDITION" IS A TRUE AND CORRECT COPY OF THE ORIGINAL PLAT AS FILED IN THE OFFICE OF THE COUNTY CLERK AND IS MADE IN COMPLIANCE WITH CHAPTER 92 OREGON LAWS 1953 SEC 92-130.

Ben B. Irving
COUNTY SURVEYOR

SUBSCRIBED AND SWORN TO BEFORE ME THIS 29th DAY OF December 1954.


Chas. Doerner
COUNTY CLERK

STATE OF OREGON }
COUNTY OF DOUGLAS } SS

I, CHAS. DOERNER, COUNTY CLERK OF DOUGLAS COUNTY OREGON DO HEREBY CERTIFY THAT FOREGOING COPY OF PLAT HAS BEEN BY ME COMPARED WITH THE ORIGINAL THEREOF THAT IT IS A TRUE AND CORRECT COPY THEREFROM AND OF THE WHOLE THEREOF AS THE SAME APPEARS ON FILE IN MY OFFICE AND CUSTODY.

WITNESS MY HAND AND OFFICIAL SEAL THIS 29th DAY OF December 1954.

Chas. Doerner
COUNTY CLERK

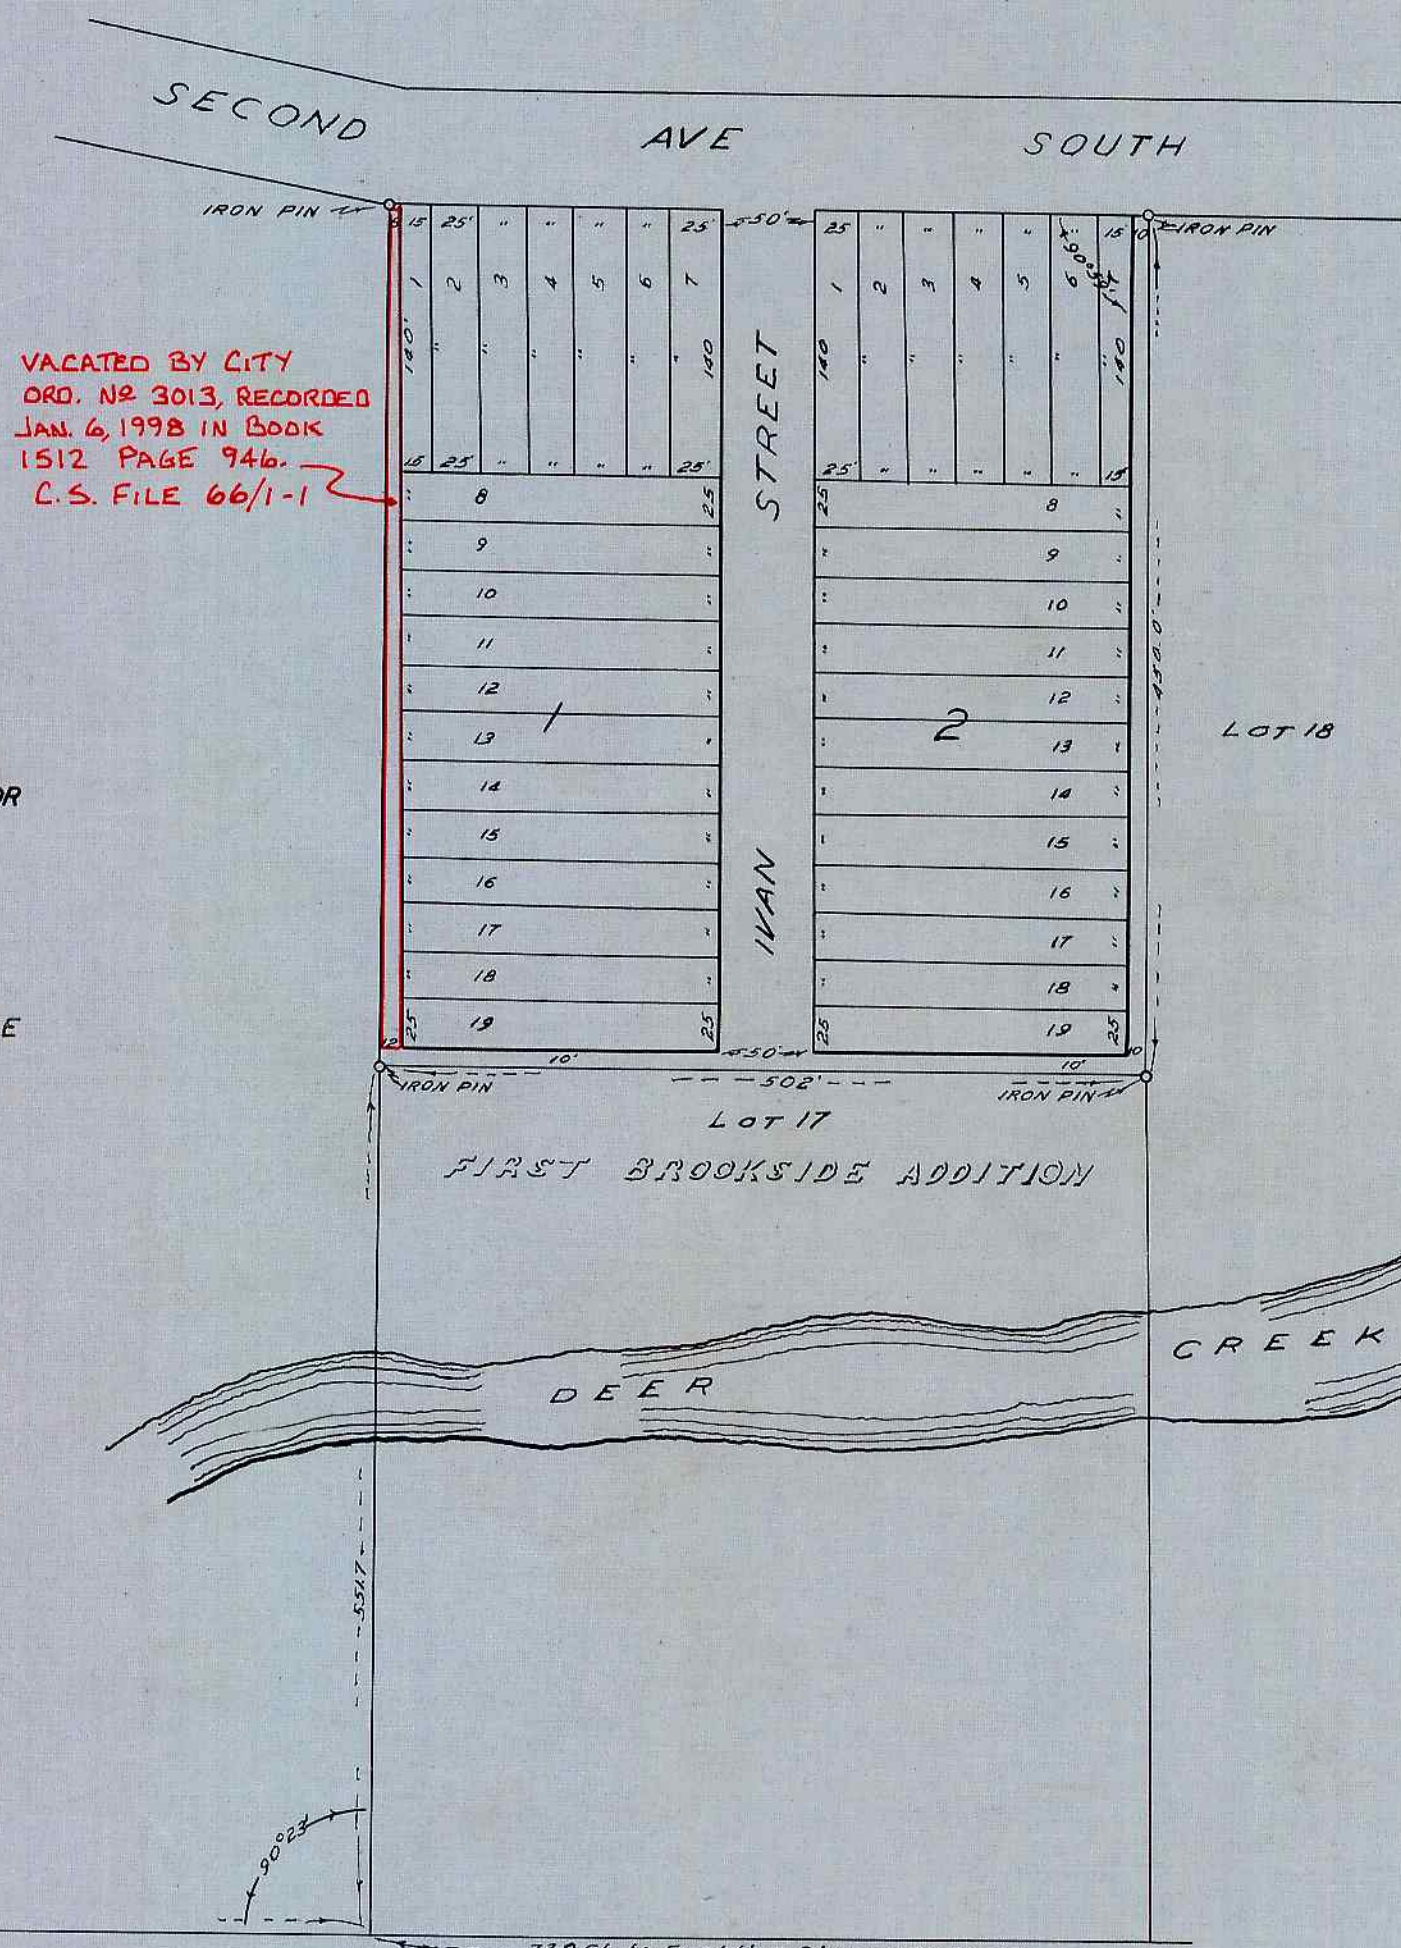

SURVEYED BY- J.M. HARTONG, CIVIL ENGINEER
JAN. 25, 1909

APPROVED MARCH 4TH 1909
(SGD) C. E. ROBERTS, COUNTY SURVEYOR

APPROVED MARCH 5TH 1909
(SGD) FRANK L. CALKINS, ASSESSOR

APPROVED MARCH TERM 1909
(SGD) G. W. WONACOTT, COUNTY JUDGE

FILED MCH. 4TH 1909
(SGD) E. H. LENOX, CO. CLERK