

BLOCK 12

T. 22-5  
NE 1/4 NW 1/4 S. 17

LOTS 1+2 GARDERS ADDITION  
TO

DRAIN , OREGON

109 DATE STREET

Scale: 1"=20'


March 17, 1965

I, Wilford N. Haines, hereby certify that  
on March 16, 1965, I examined this prop-  
erty and found the improvement to  
be as shown.

Wilford N Haines

• 1/4" iron pipes in place

NORTH

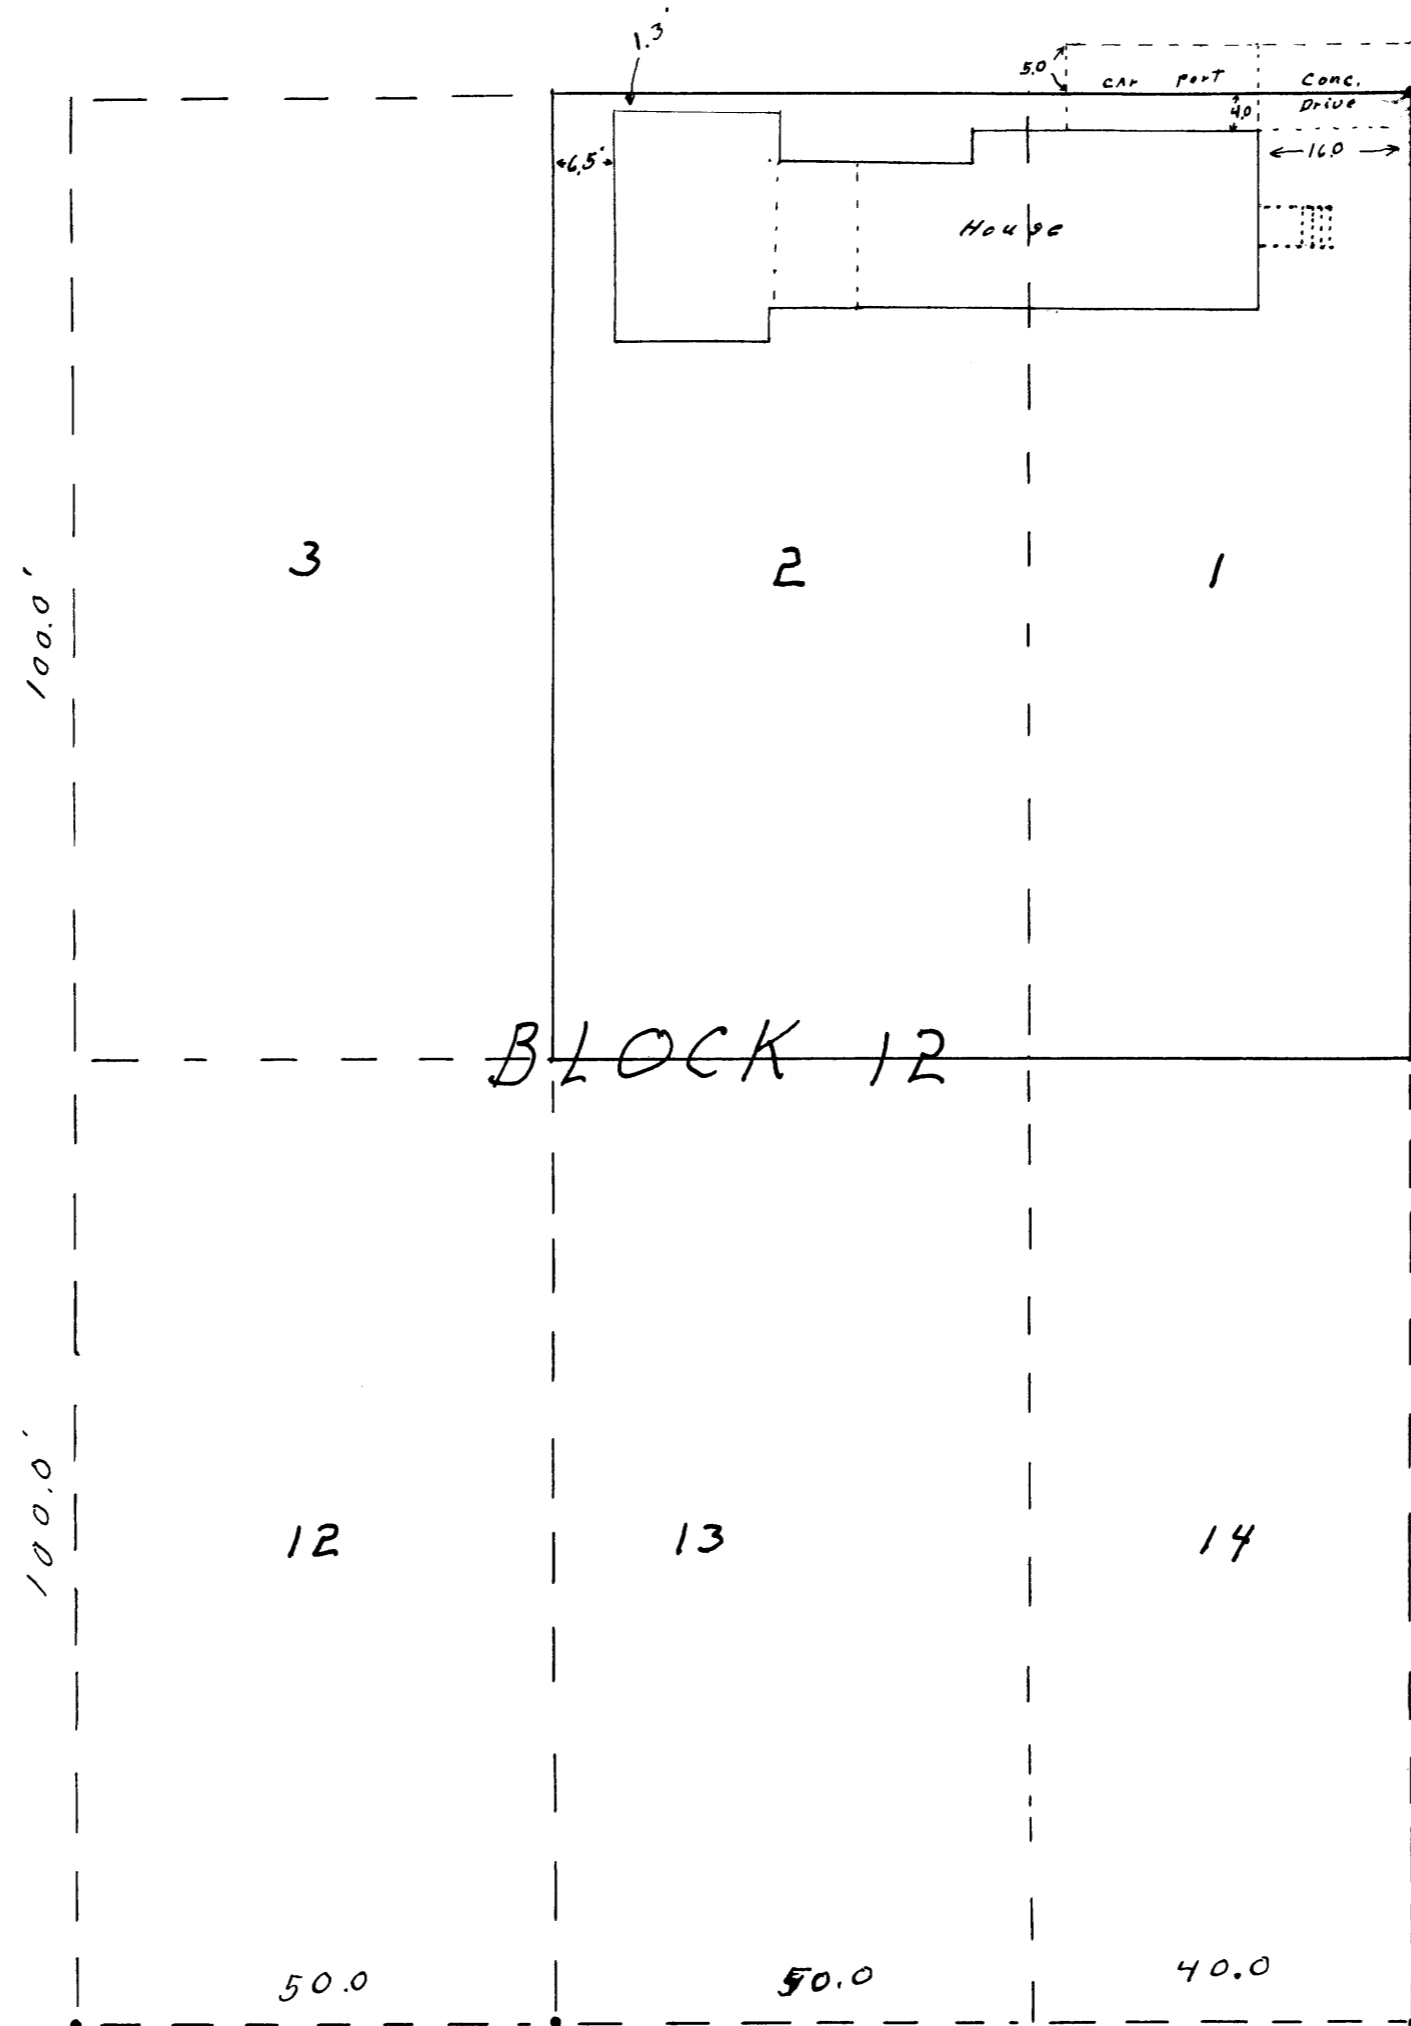

FILED *JL*  
SEP 20 1990  
COUNTY SURVEYOR  
DOUGLAS COUNTY, ORE.

STREET

DATE STREET

Document Rec'd  
FROM HAINES  
ESTATE. 1990  
*JL*

H EN. 24