


FILED
RECEIVED
AUG 6 1956
COUNTY SURVEYOR
DOUGLAS COUNTY, ORE.
JMB

MAP FILE M.L.F. 12

HERMAN SCHOSSO
YONCALLA OREGON
PART OF SO. HALF OF D.L.C. NO. 41
SECTION 10 T.23 S. R.5 W.
SEPTEMBER 1955 1"=100'

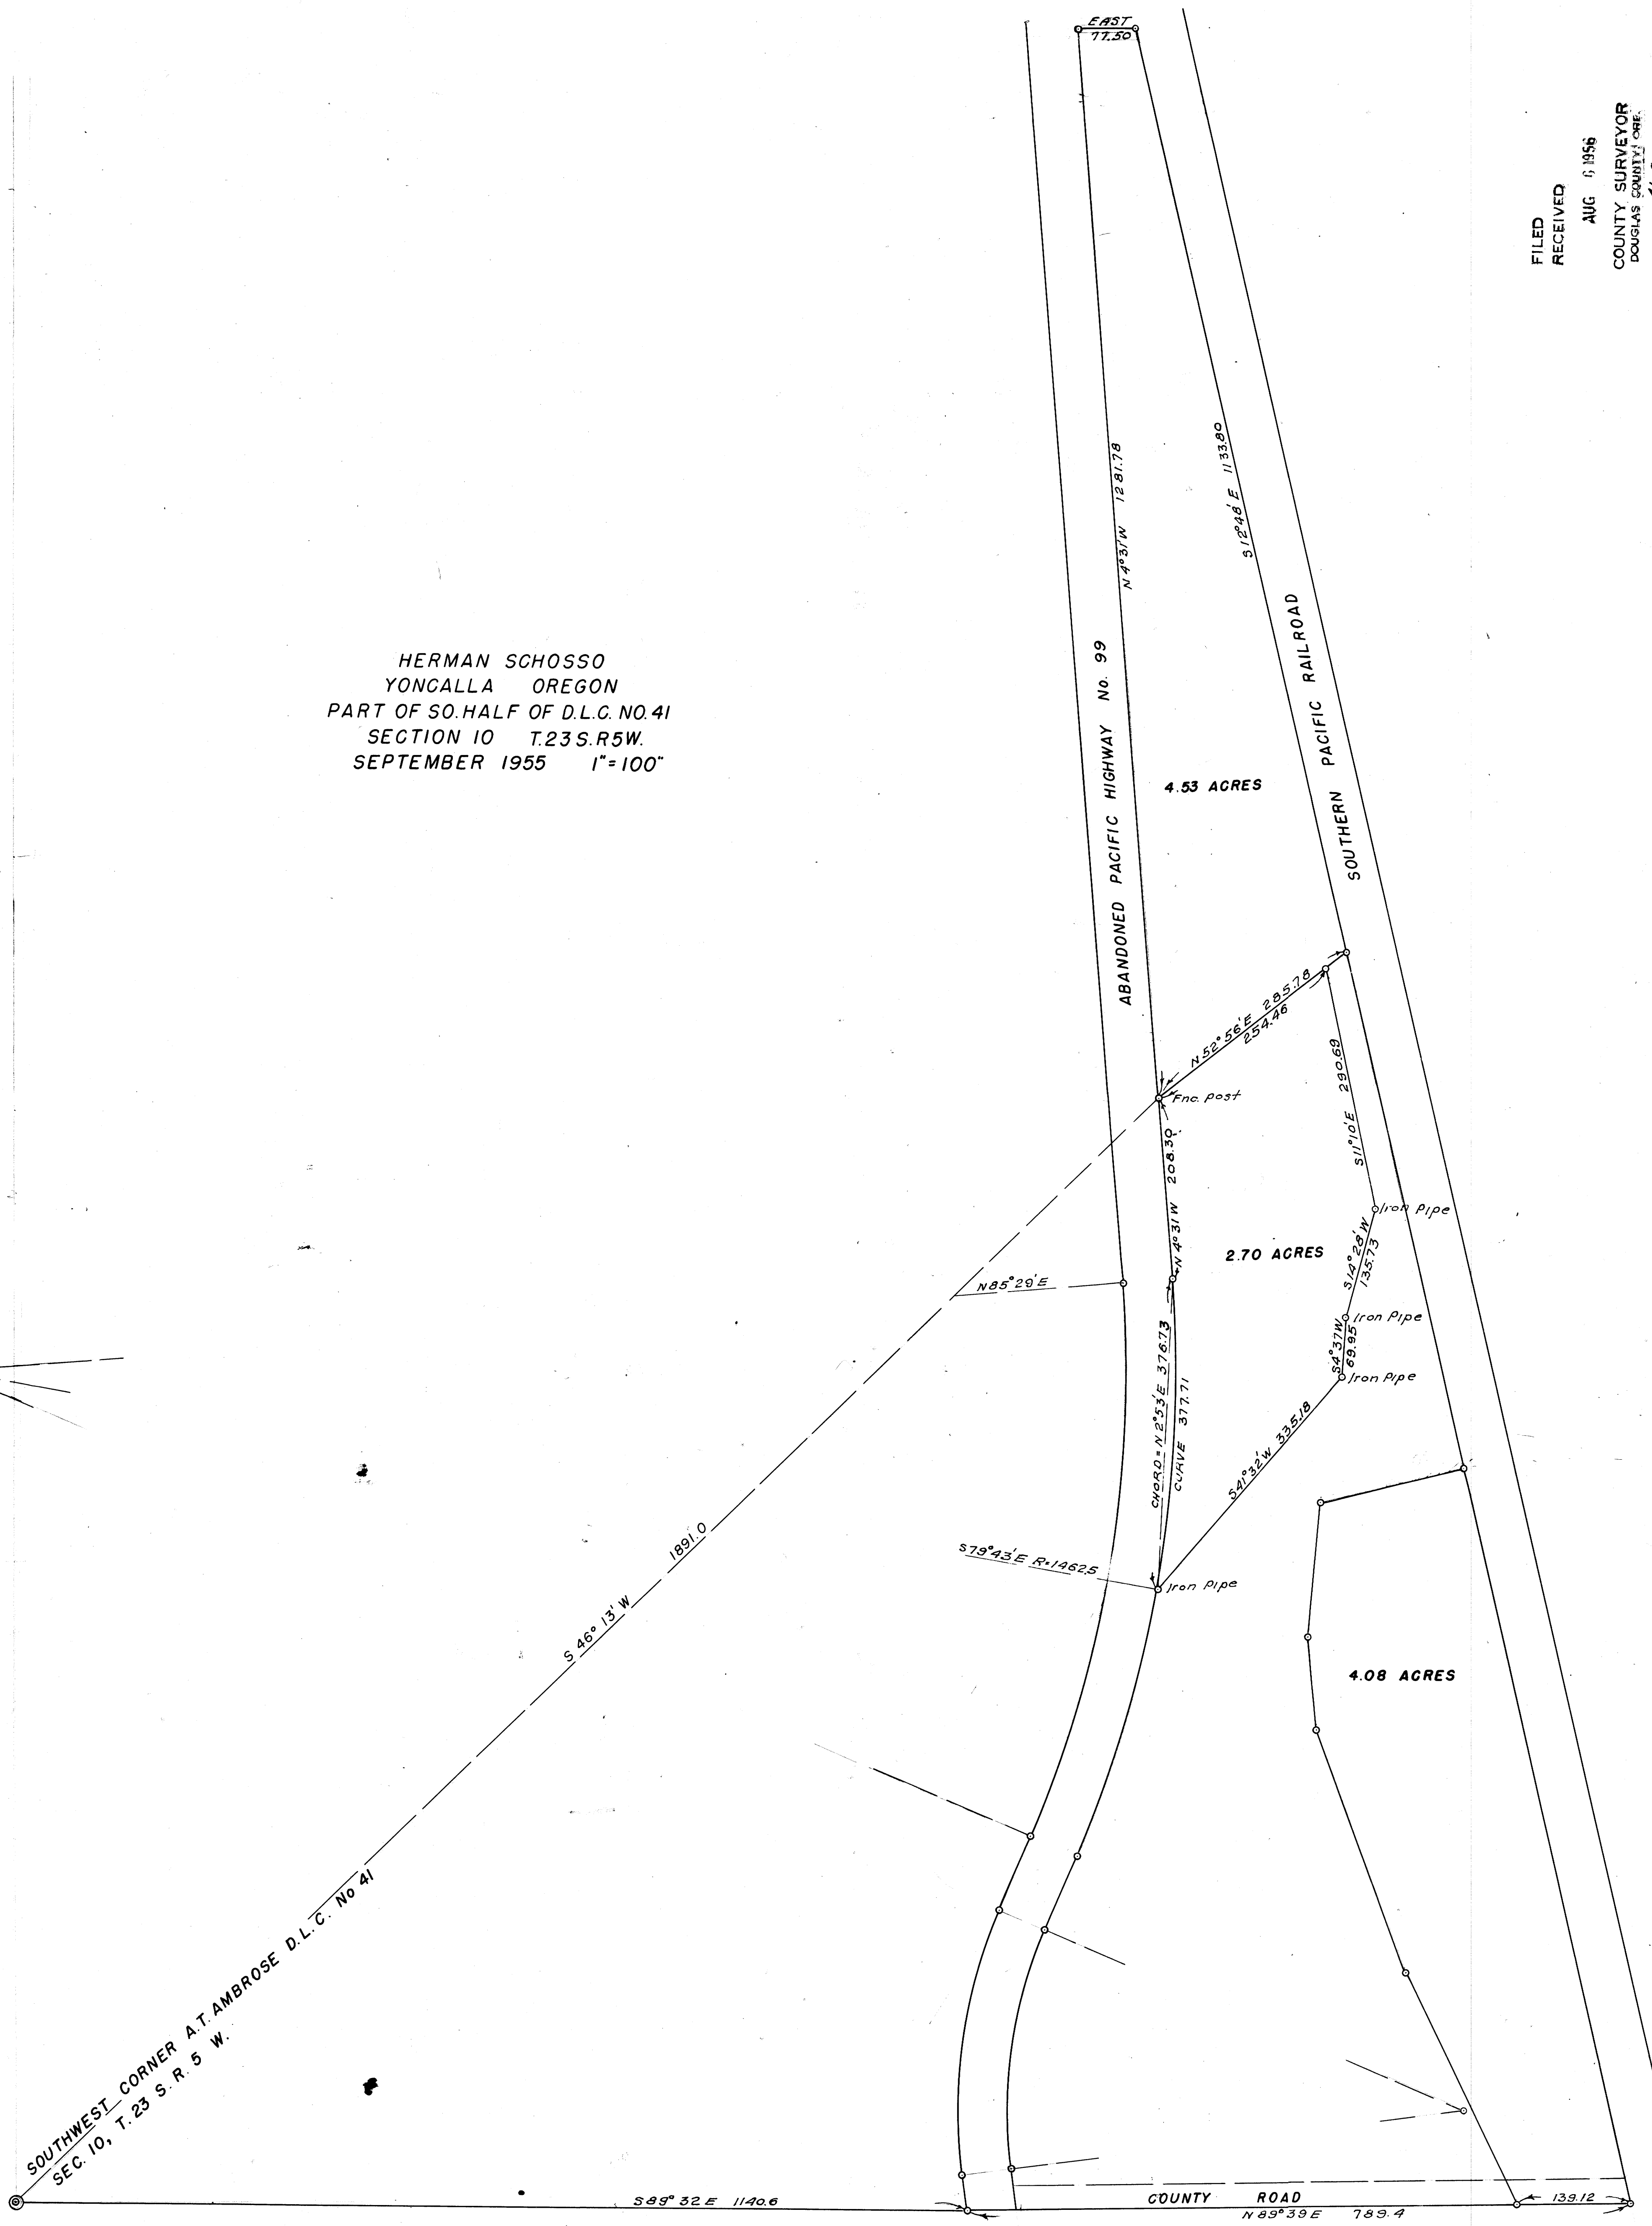

MAP FILE M.L.F. 12-E