


COUNTY SURVEYORS FILE DATA
DO NOT REMOVE FROM OFFICE

SURVEY TO ESTABLISH PROPERTY LINES


IN
LOT 13, BLOCK 1 PLAT "A"
SUTHERLIN LAND AND WATER CO.
S. 15, T. 25 S., R. 5 W., W. M.
FOR

HAROLD WESCOTT

GENE E. JOHNSON ENGINEER
ROSEBURG, OREGON
SURVEYED JUNE 1956 SCALE 1"=100'

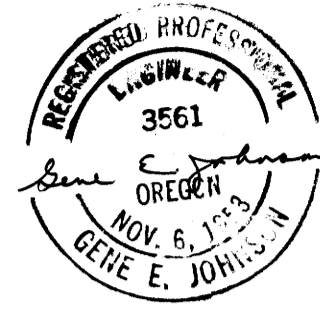

NOTE: BEARINGS SHOWN ARE BASED ON
RECORD BEARING - SOUTH - OF
EAST LINE OF LOT 15 AS PER
PLAT "A" AND EAST VALLEY HOMES.

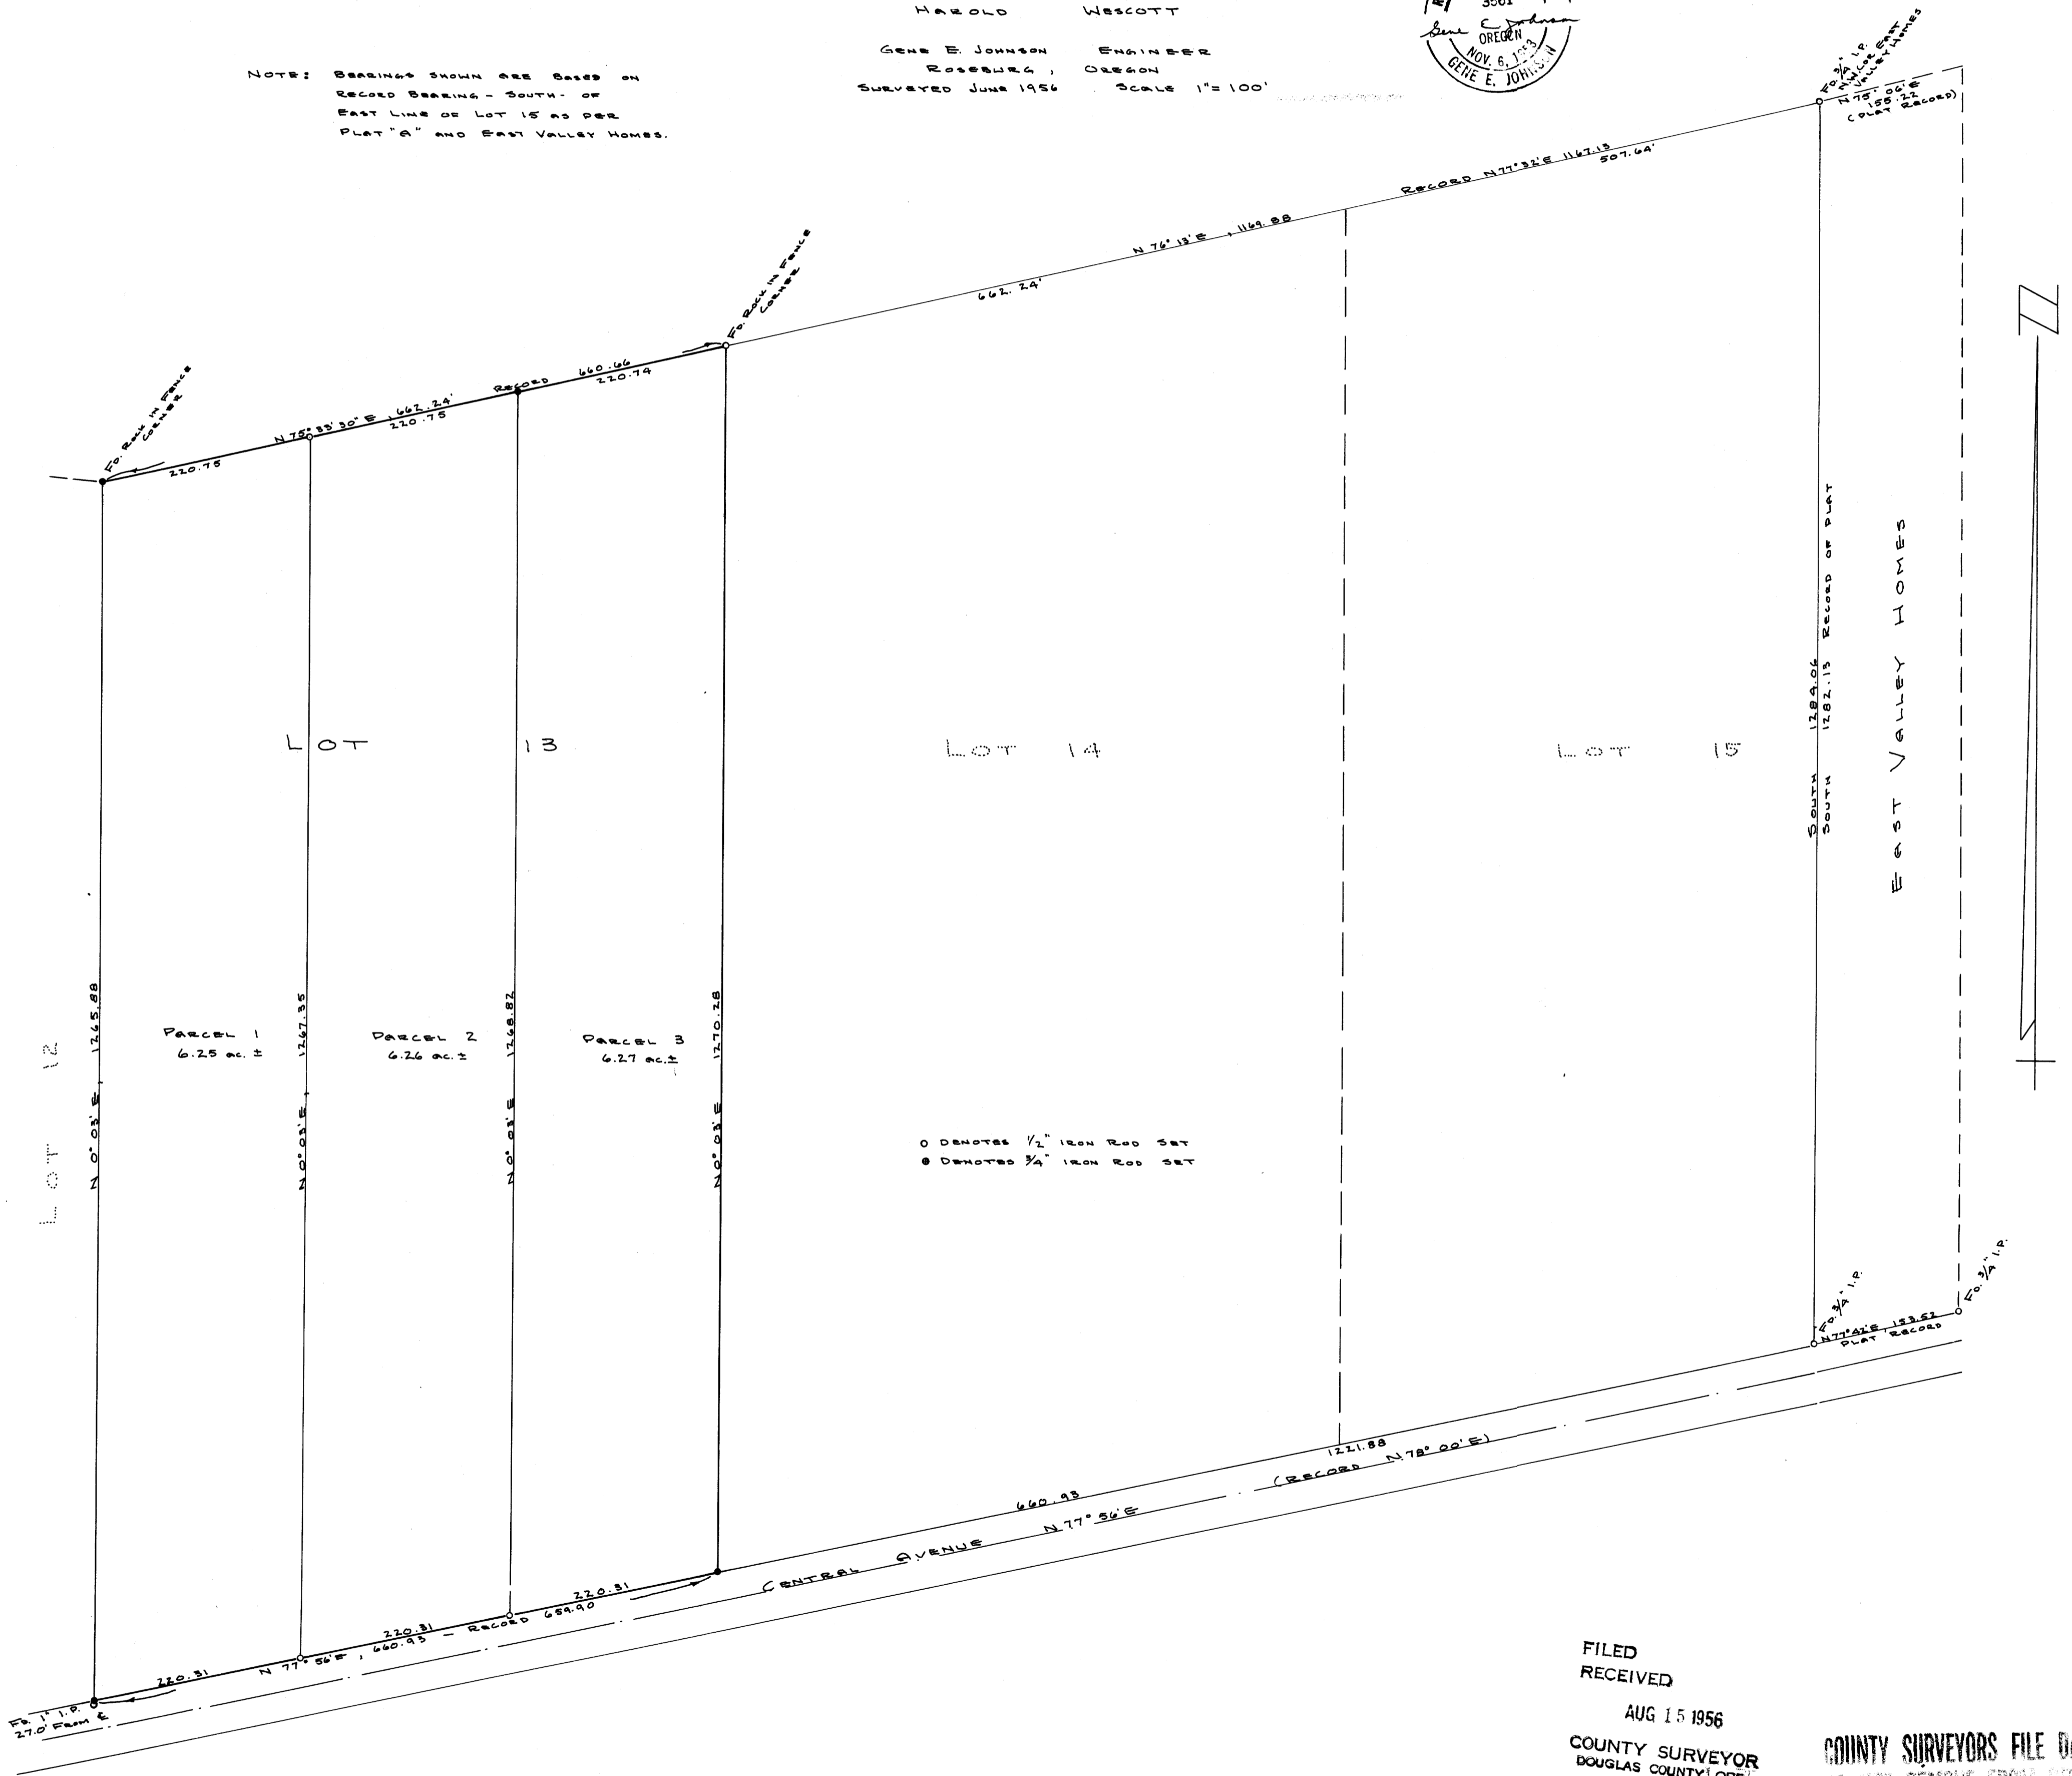

FILED
RECEIVED
AUG 15 1956
COUNTY SURVEYOR
DOUGLAS COUNTY, ORE.

COUNTY SURVEYORS FILE DATA
DO NOT REMOVE FROM OFFICE

JMR