



2" City Water Main

C.S. File No. 38/29
MAP FILE M1 23

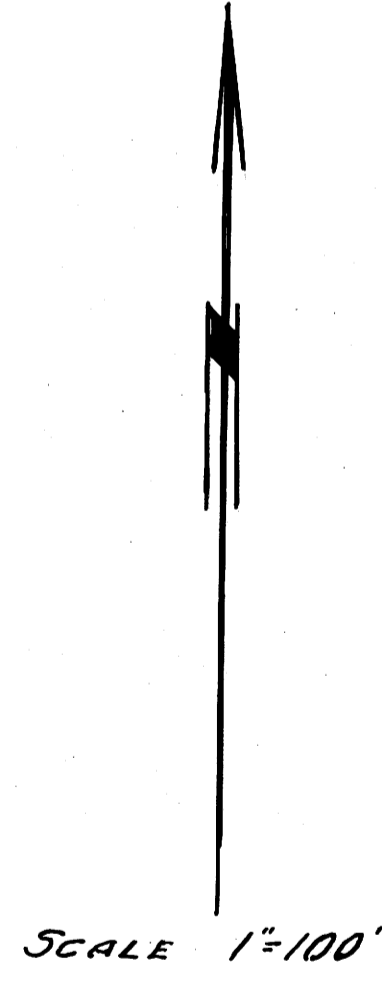

MAP SHOWING
 RELATIVE LOCATION OF SPRINGS AND
 PROPERTY LINES
 SECTION 29 T.29S., R.5W., WM.
 SURVEYED & PLOTTED BY
 BEN. B. IRVING
 REGISTERED CIVIL ENGINEER & COUNTY SURVEYOR
 ROSEBURG OREGON

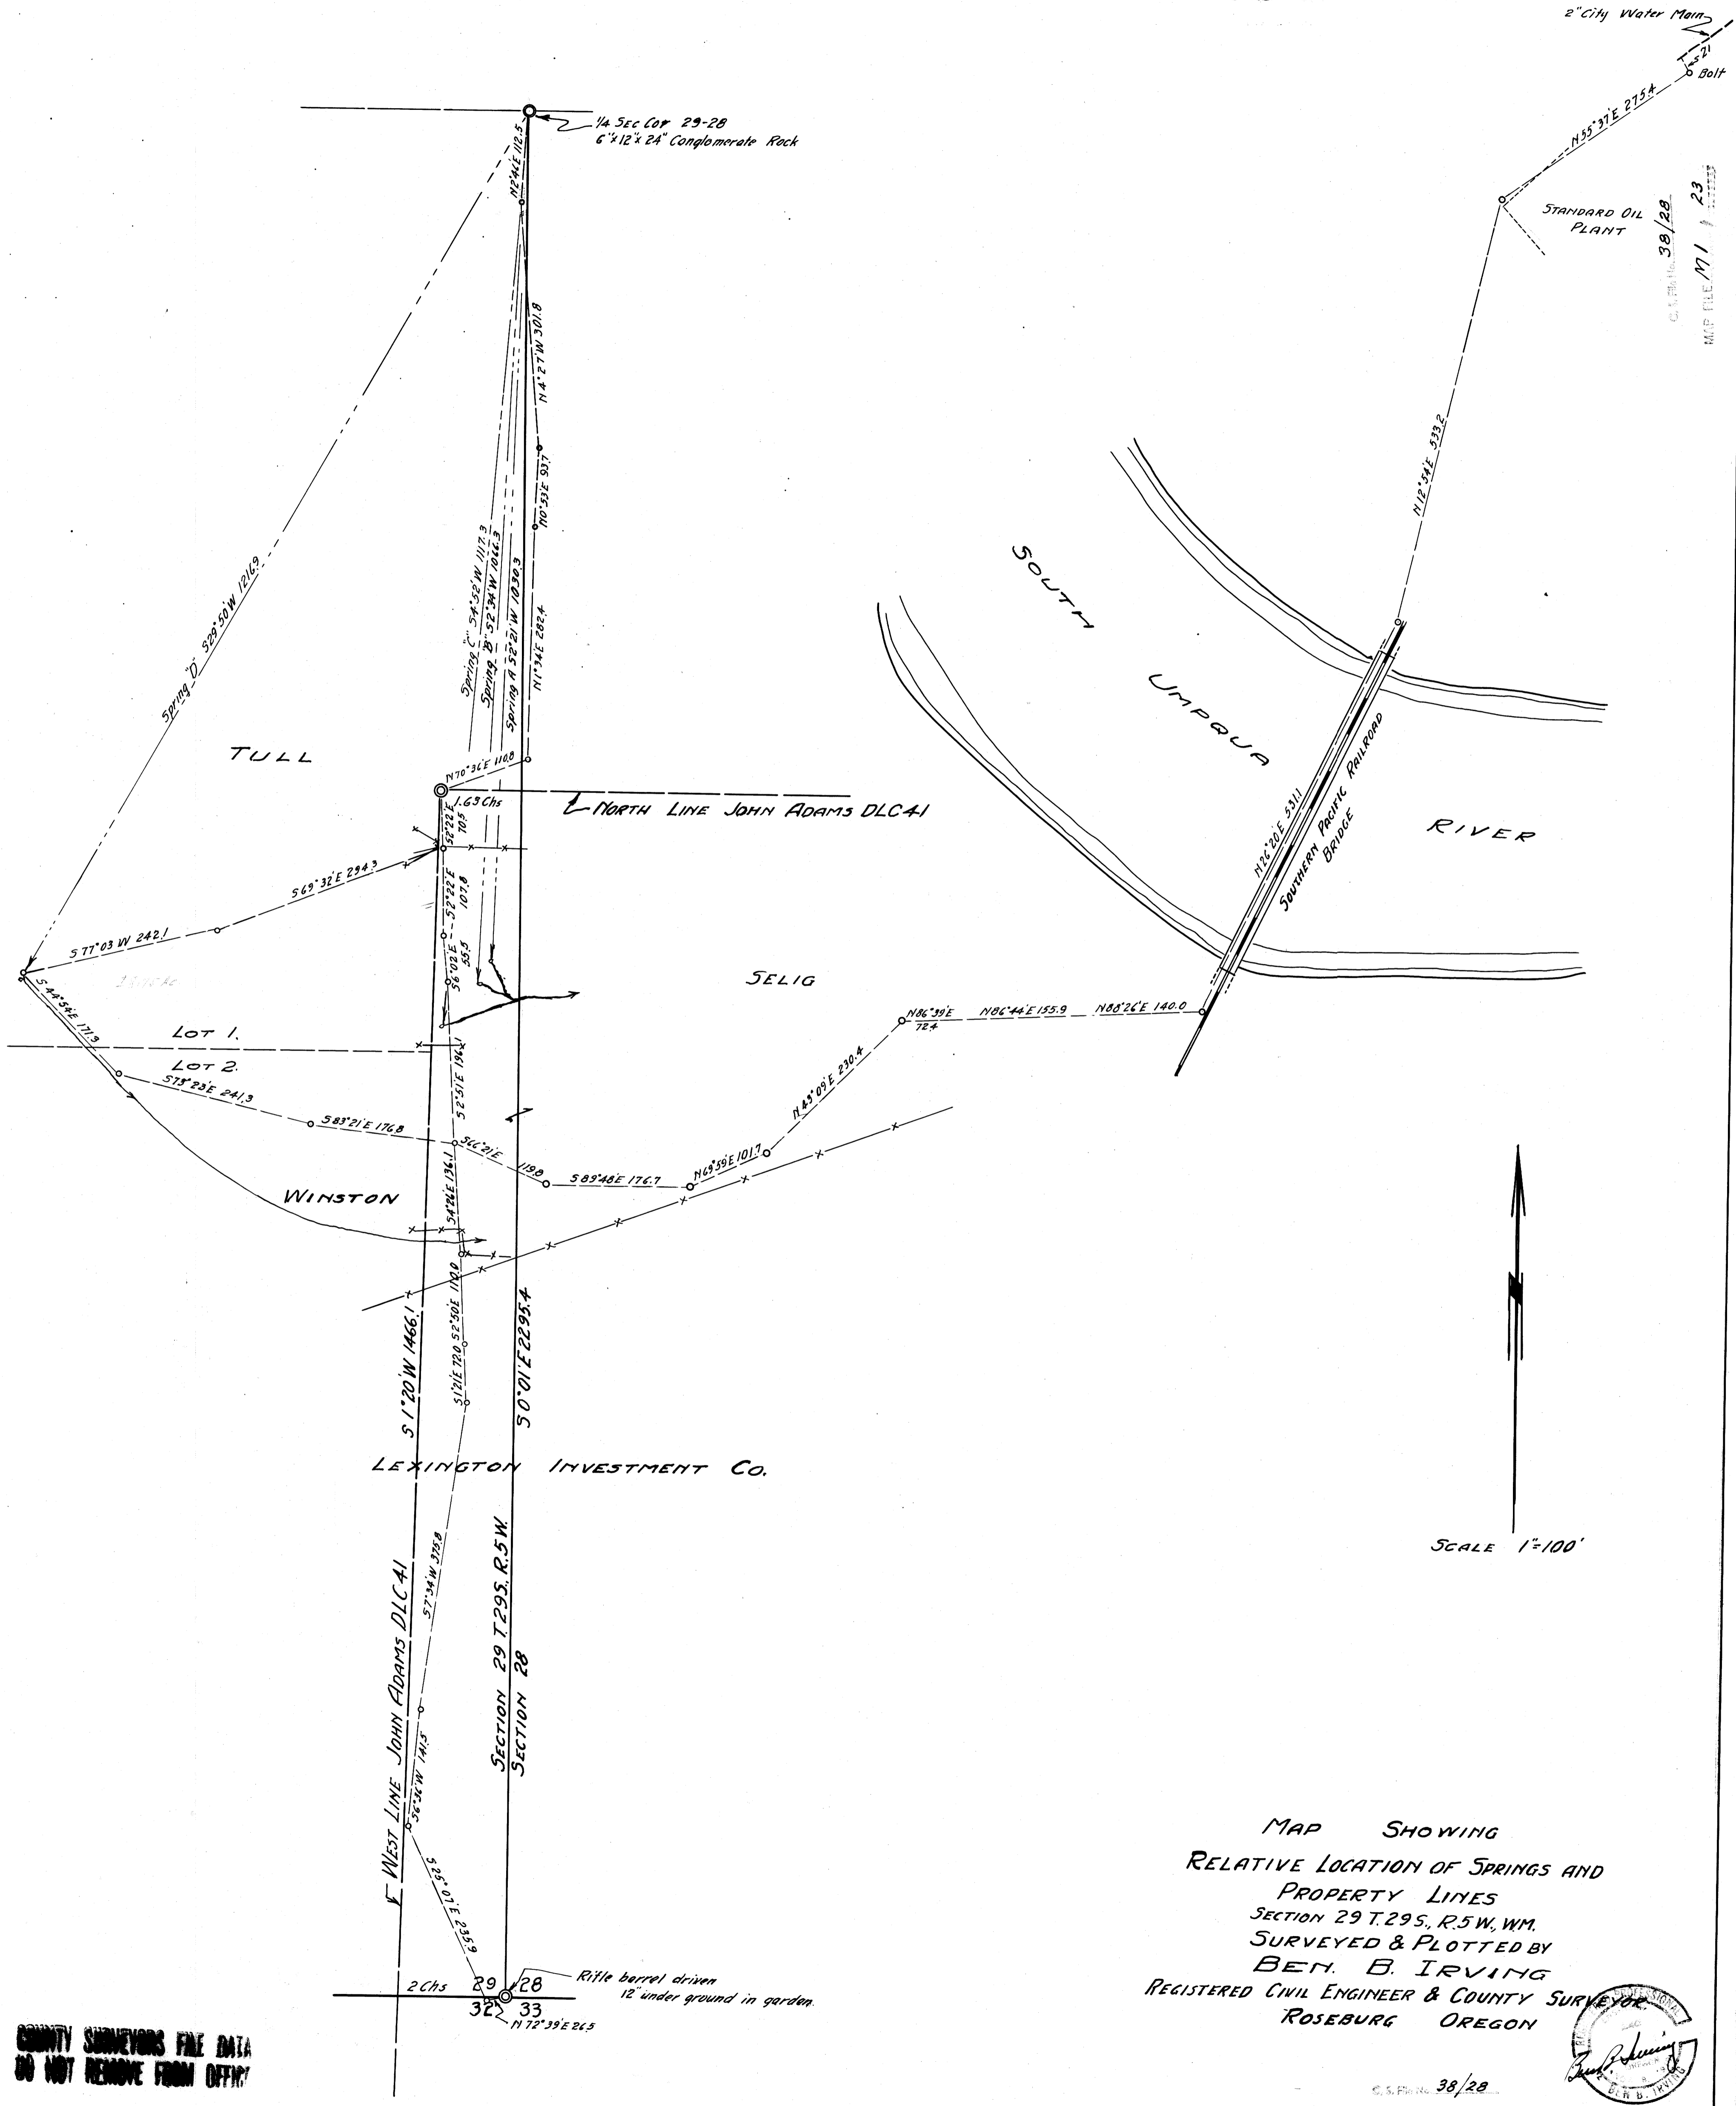