


"City" Electricity 2300 V.

STREET (no surfacing)

S. Side of Street
S 88° 41' E. 462.0

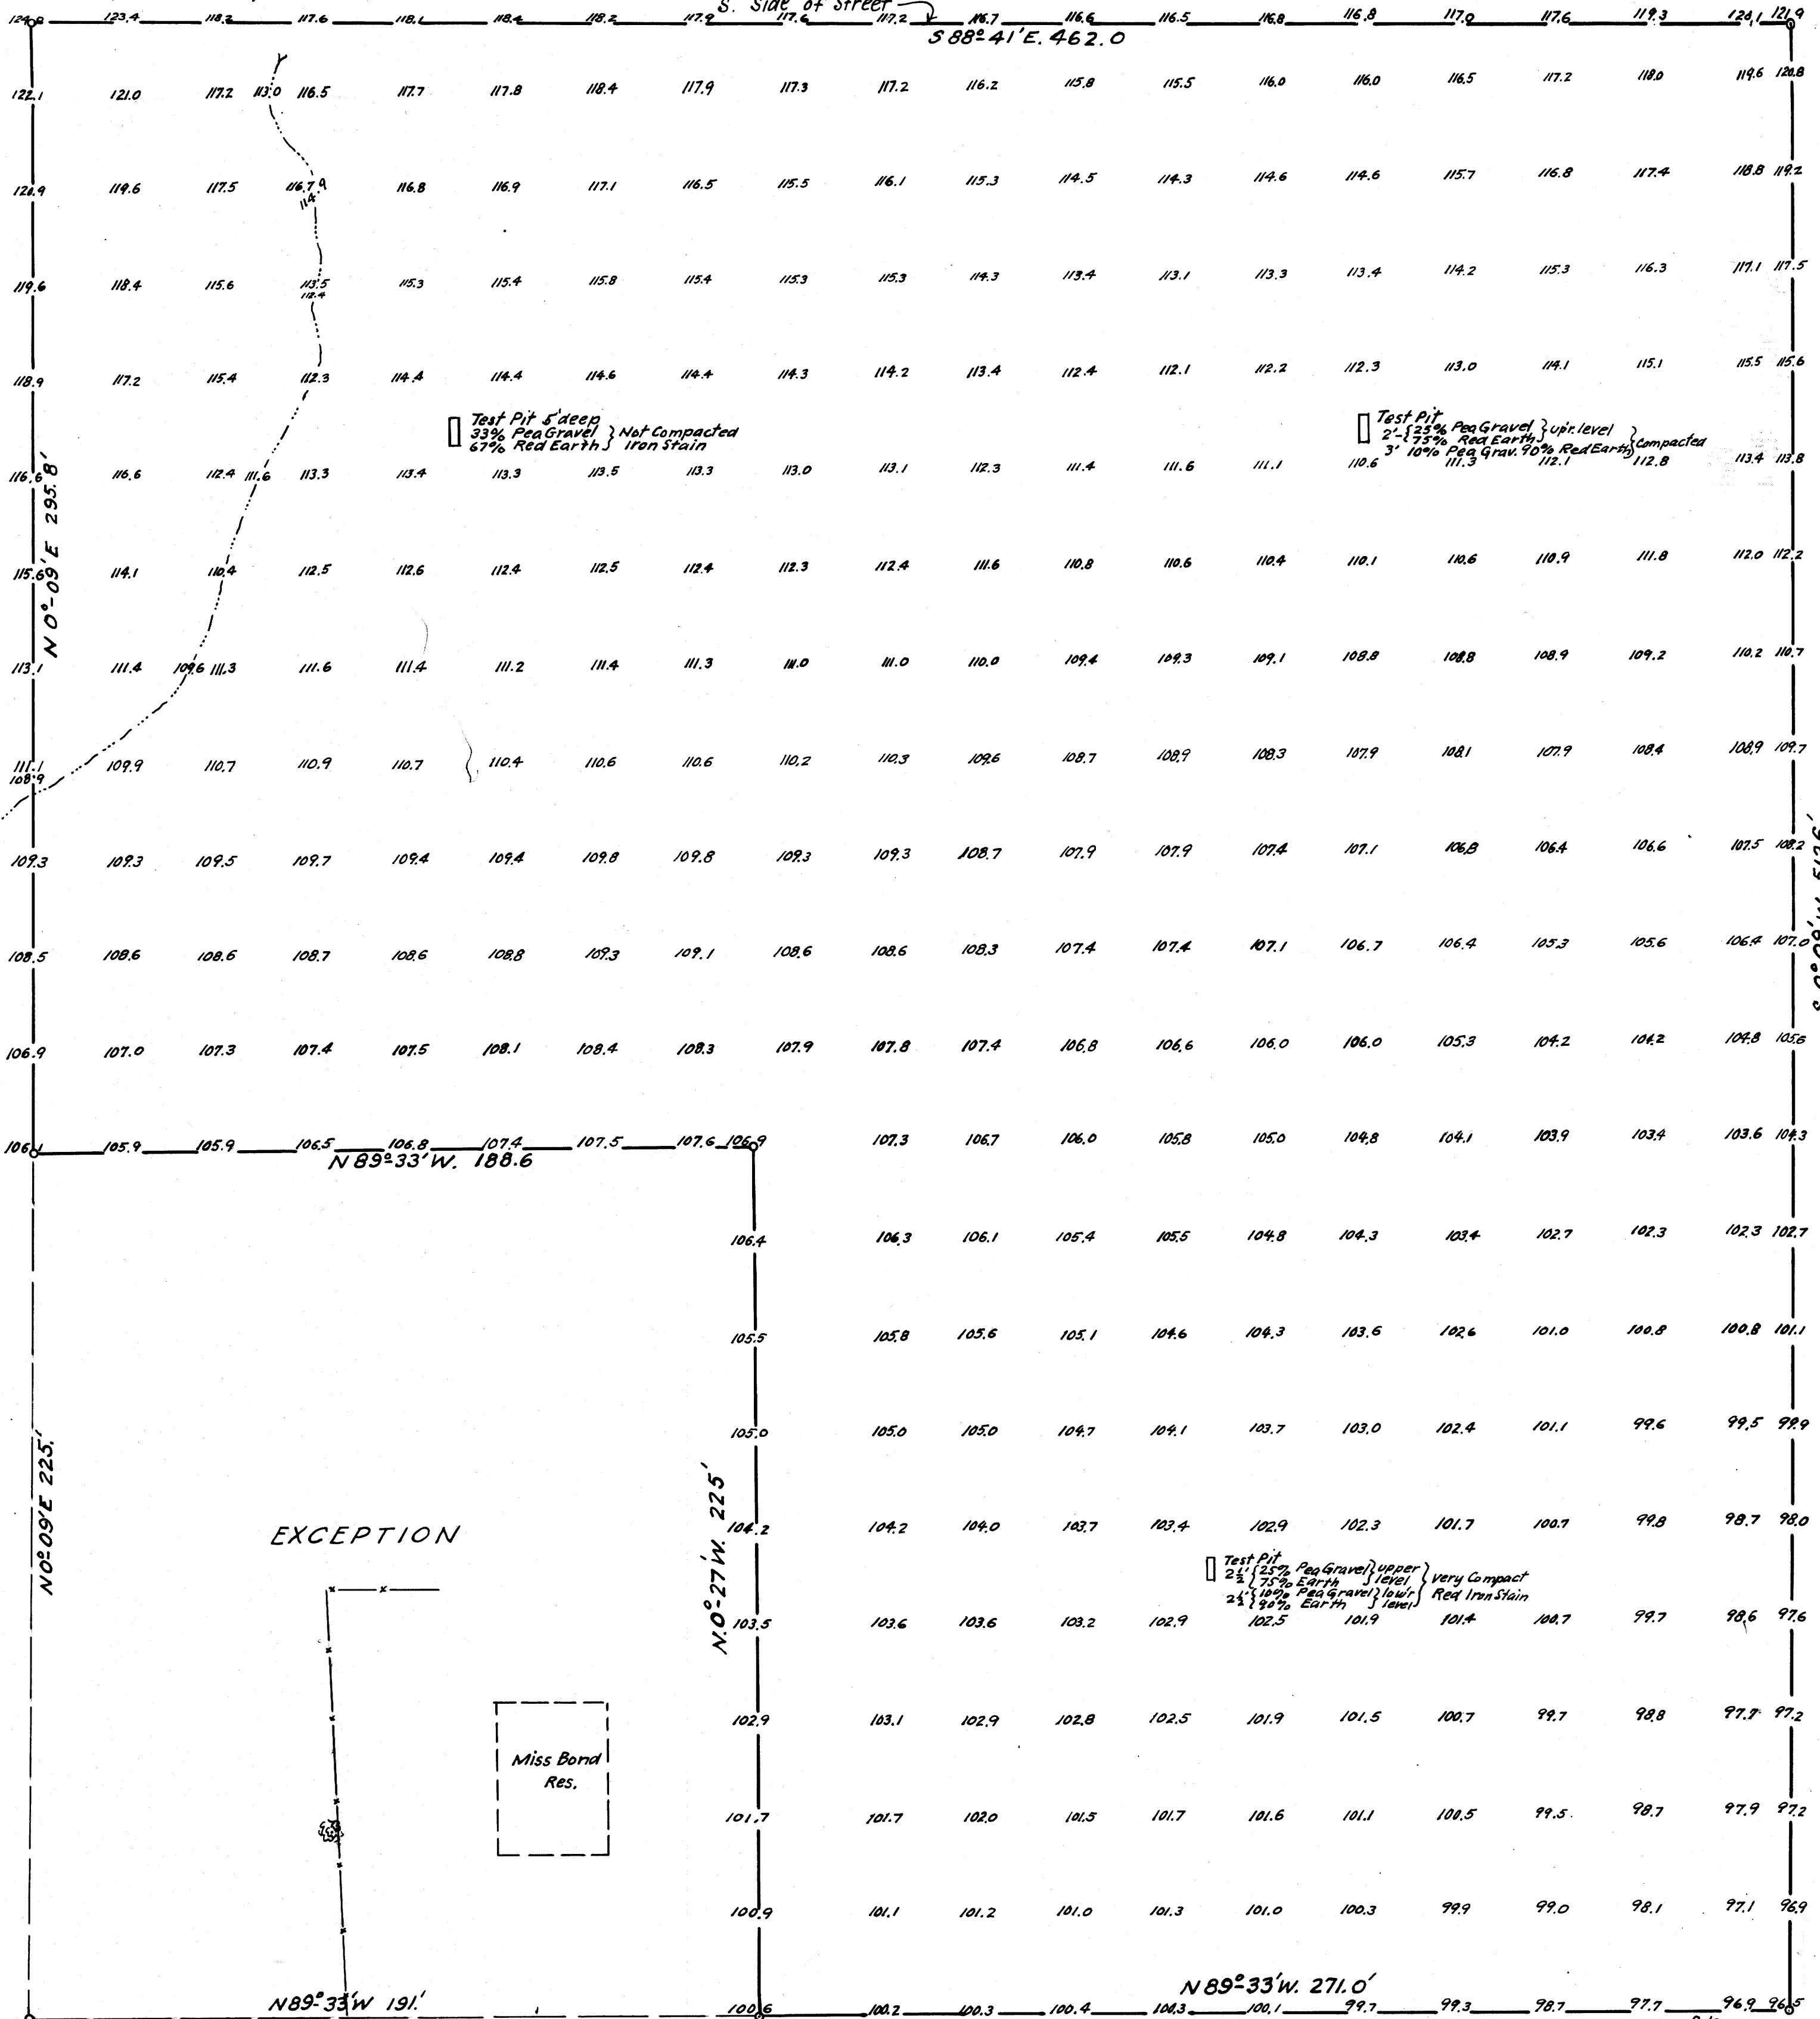

Test Pit 5' deep
33% Pea Gravel } Not Compacted
67% Red Earth } Iron Stain

Test Pit
2' 25% Pea Gravel } upper level } Compacted
2' 75% Red Earth }
3' 10% Pea Gravel, 90% Red Earth }
11.3 112.1 112.8

Test Pit
2 1/2' 25% Pea Gravel } upper } Very Compact
2 1/2' 75% Earth } lower } Red Iron Stain
2 1/2' 10% Pea Gravel } lower }
2 1/2' 90% Earth } level }

EXCEPTION

Miss Bond Res.

