


RENEW 1/4 COR. FOUND BT. AS RENEWED BY WENDROTH, 1852 THE N.E. BT. (PINE) STUMP ONLY SCRIBED 1/4 S. BT. ALSO PD 3/4" PIPE AT COR UNDER N-S FENCE. BEARS & SCRIBES 25" RING 5-83" 1887 SCRIBED 1/4 S. C.S. BT.

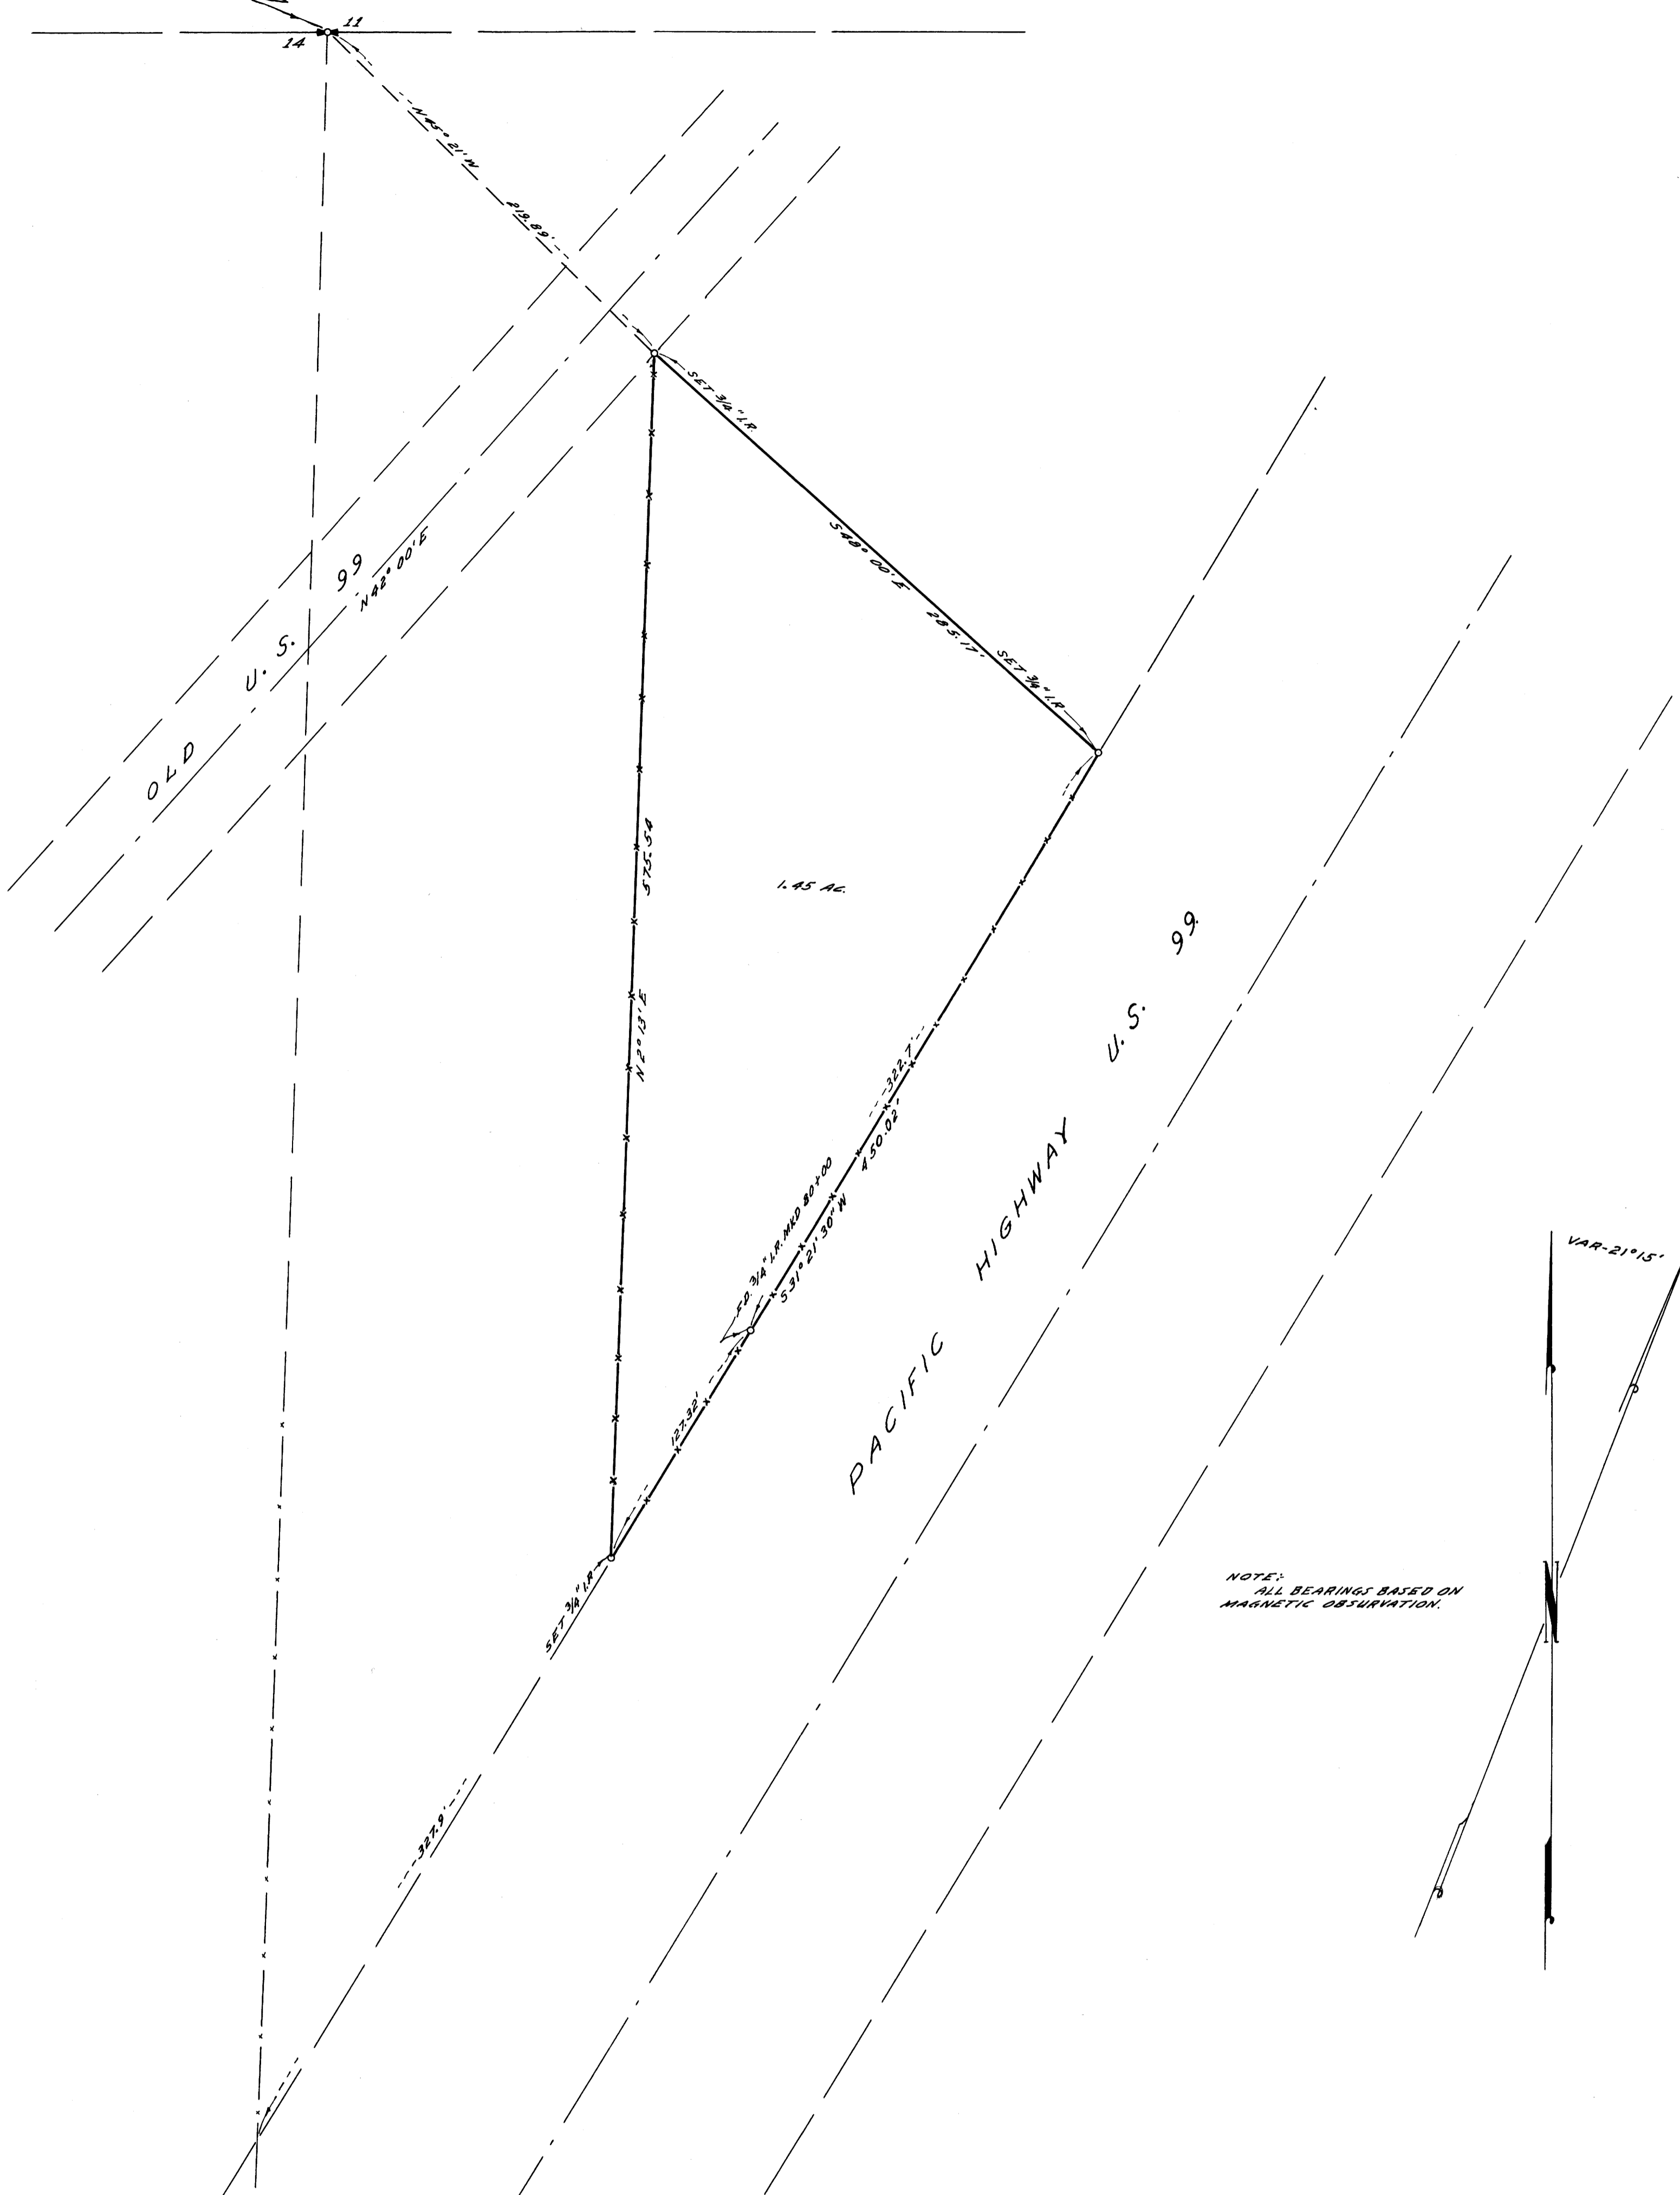

NOTE: ALL BEARINGS BASED ON MAGNETIC OBSERVATION.

COUNTY SURVEYOR'S OFFICE
DOUGLAS COUNTY, OREGON

SURVEY FOR DEED DESCRIPTION,
SECTION 14, T32S., R5W, W.M.

James W. Byron
REGISTERED
SURVEYOR
OREGON

FRED M. DARBY COUNTY SURVEYOR
SURVEYED MAR. 28, 1956
BY JAMES W. BYRON - DEPUTY SCALE 1" = 50'
SURVEYED FOR T. A. LASATER

COUNTY SURVEYORS FILE DATA
DO NOT REMOVE FROM OFFICE