
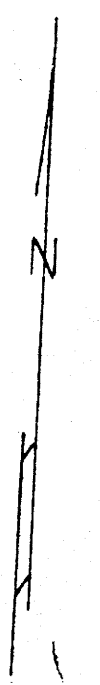



MAP FILE M. 2. 172

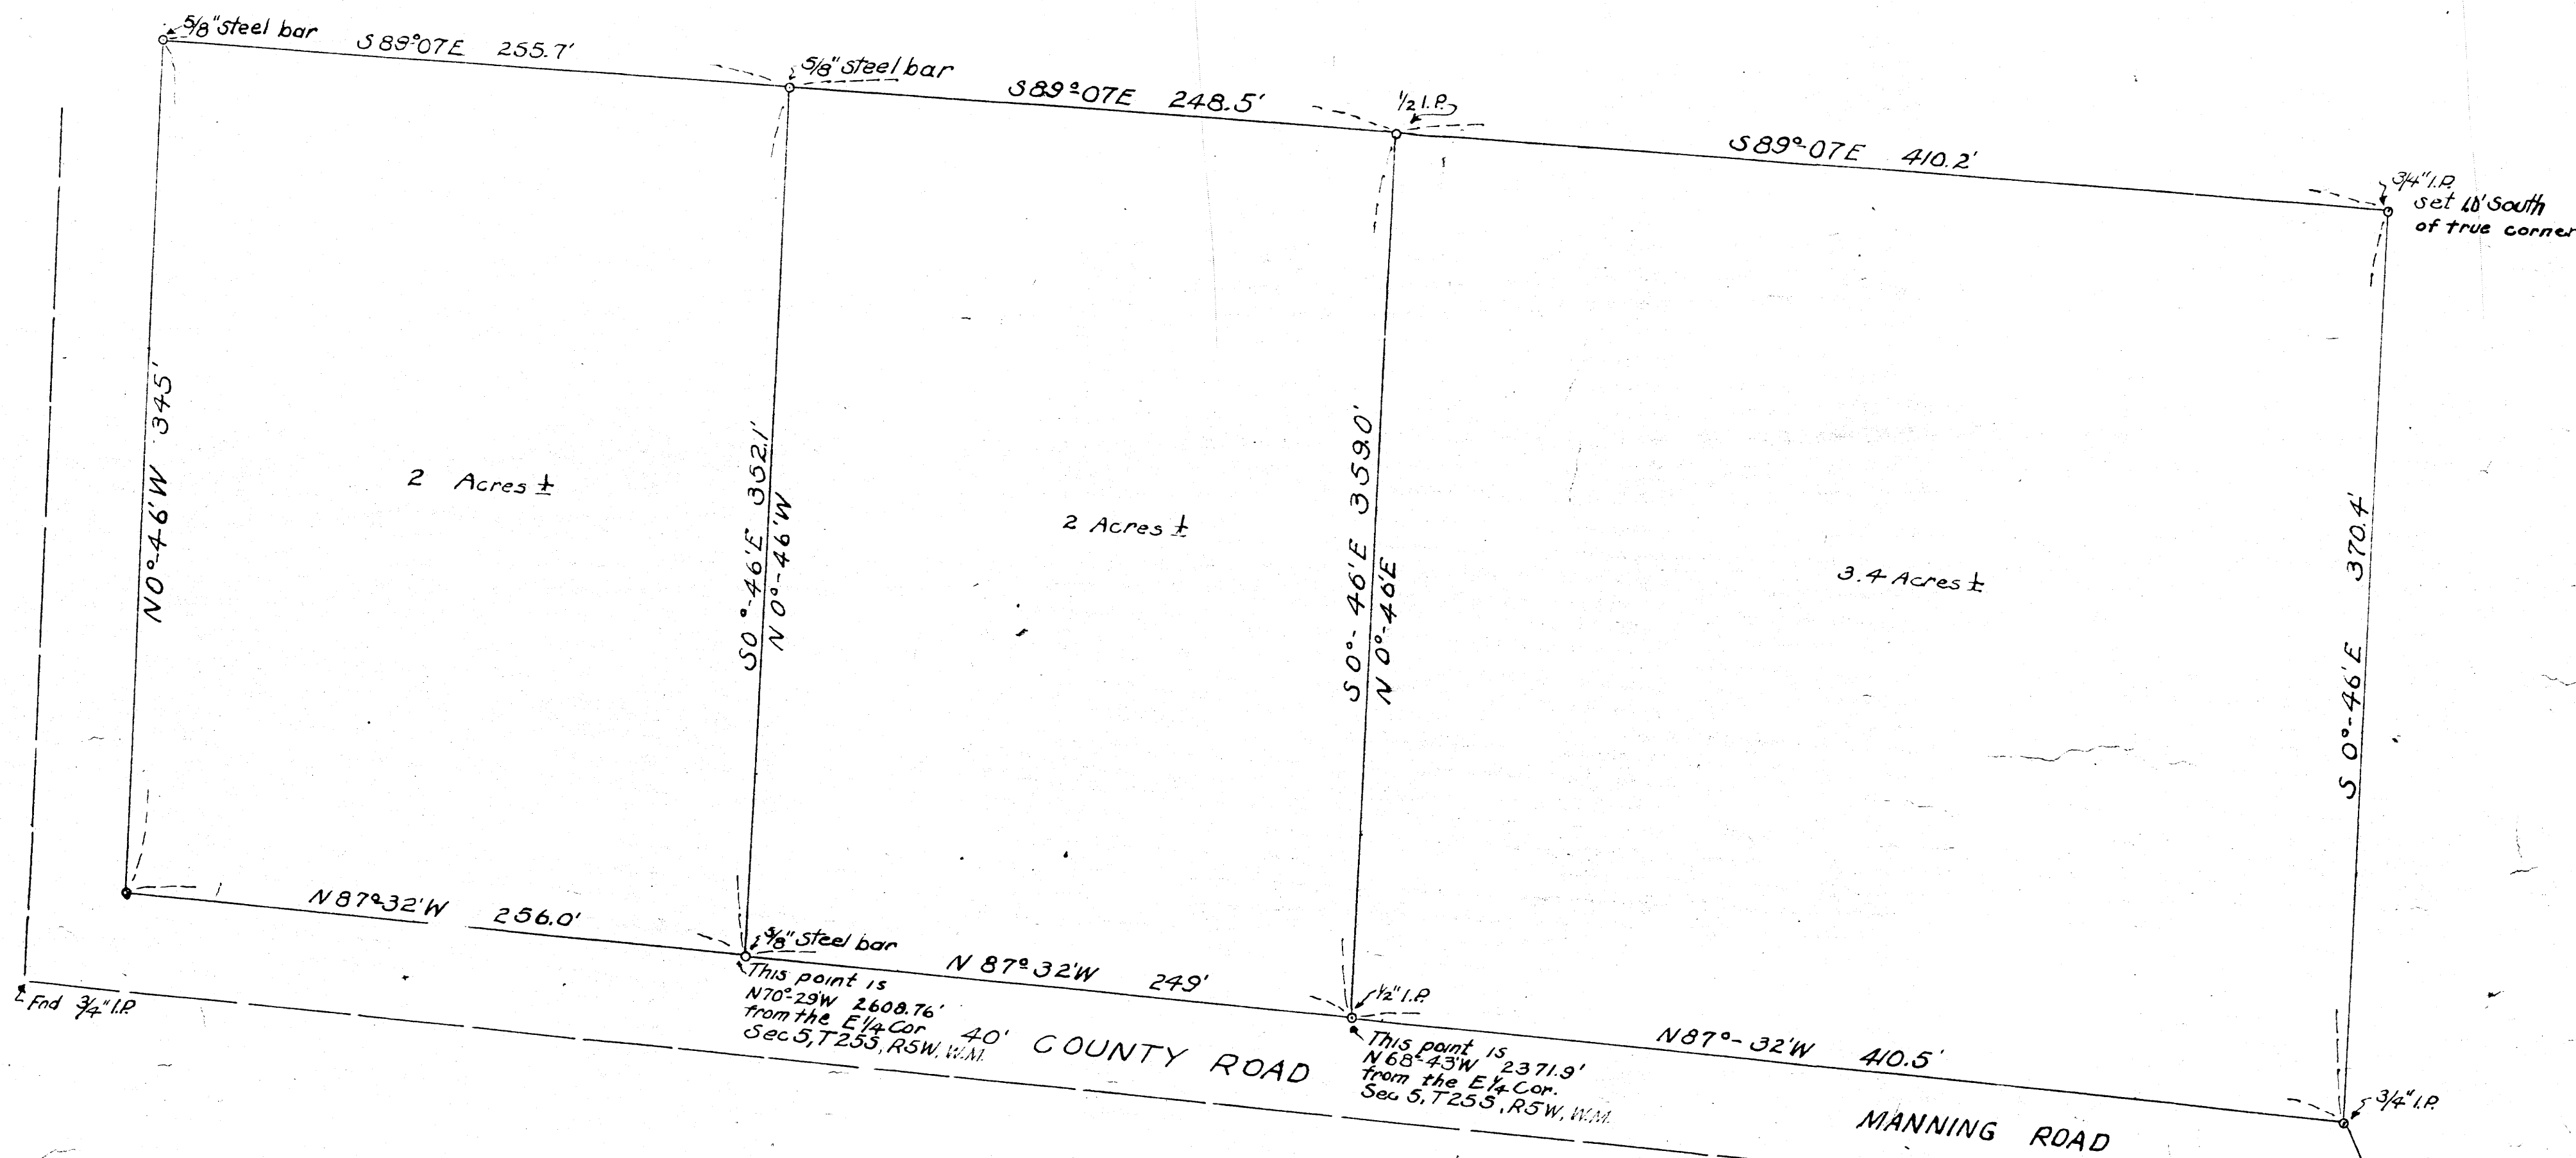

COUNTY SURVEYORS FILE DATA
 DO NOT REMOVE FROM OFFICE
 THIS COPY MADE FROM A XEROX 2510
 DATE 11-17-88

PARCELS SOLD BY ALFRED HAND
 IN SW 1/4, NE 1/4 SEC 5 T25S, R5W, W.M.

DOUGLAS COUNTY, ORE
 MAY 1988
 Scale 1"=50'

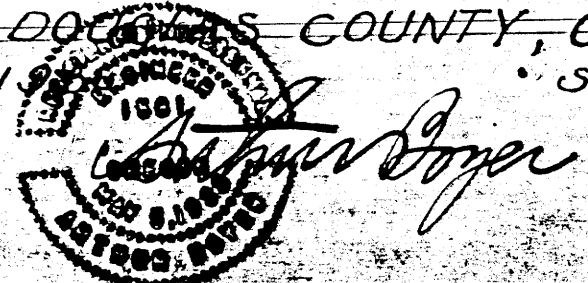

FILED
 RECEIVED
 JUL 4 1956
 COUNTY SURVEYOR
 DOUGLAS COUNTY, ORE.
 JMB

M 2-72