

COUNTY SURVEYORS FILE DATA
DO NOT REMOVE FROM OFFICE


SURVEY OF A PORTION OF
NEWELL C. WOOD PROPERTY
IN LOT 8, SEC. 3, T30S, R4W, W.M.

SCALE 1"=100'

DEC. 17, 1955

R. M. THOMPSON

Robert M. Thompson

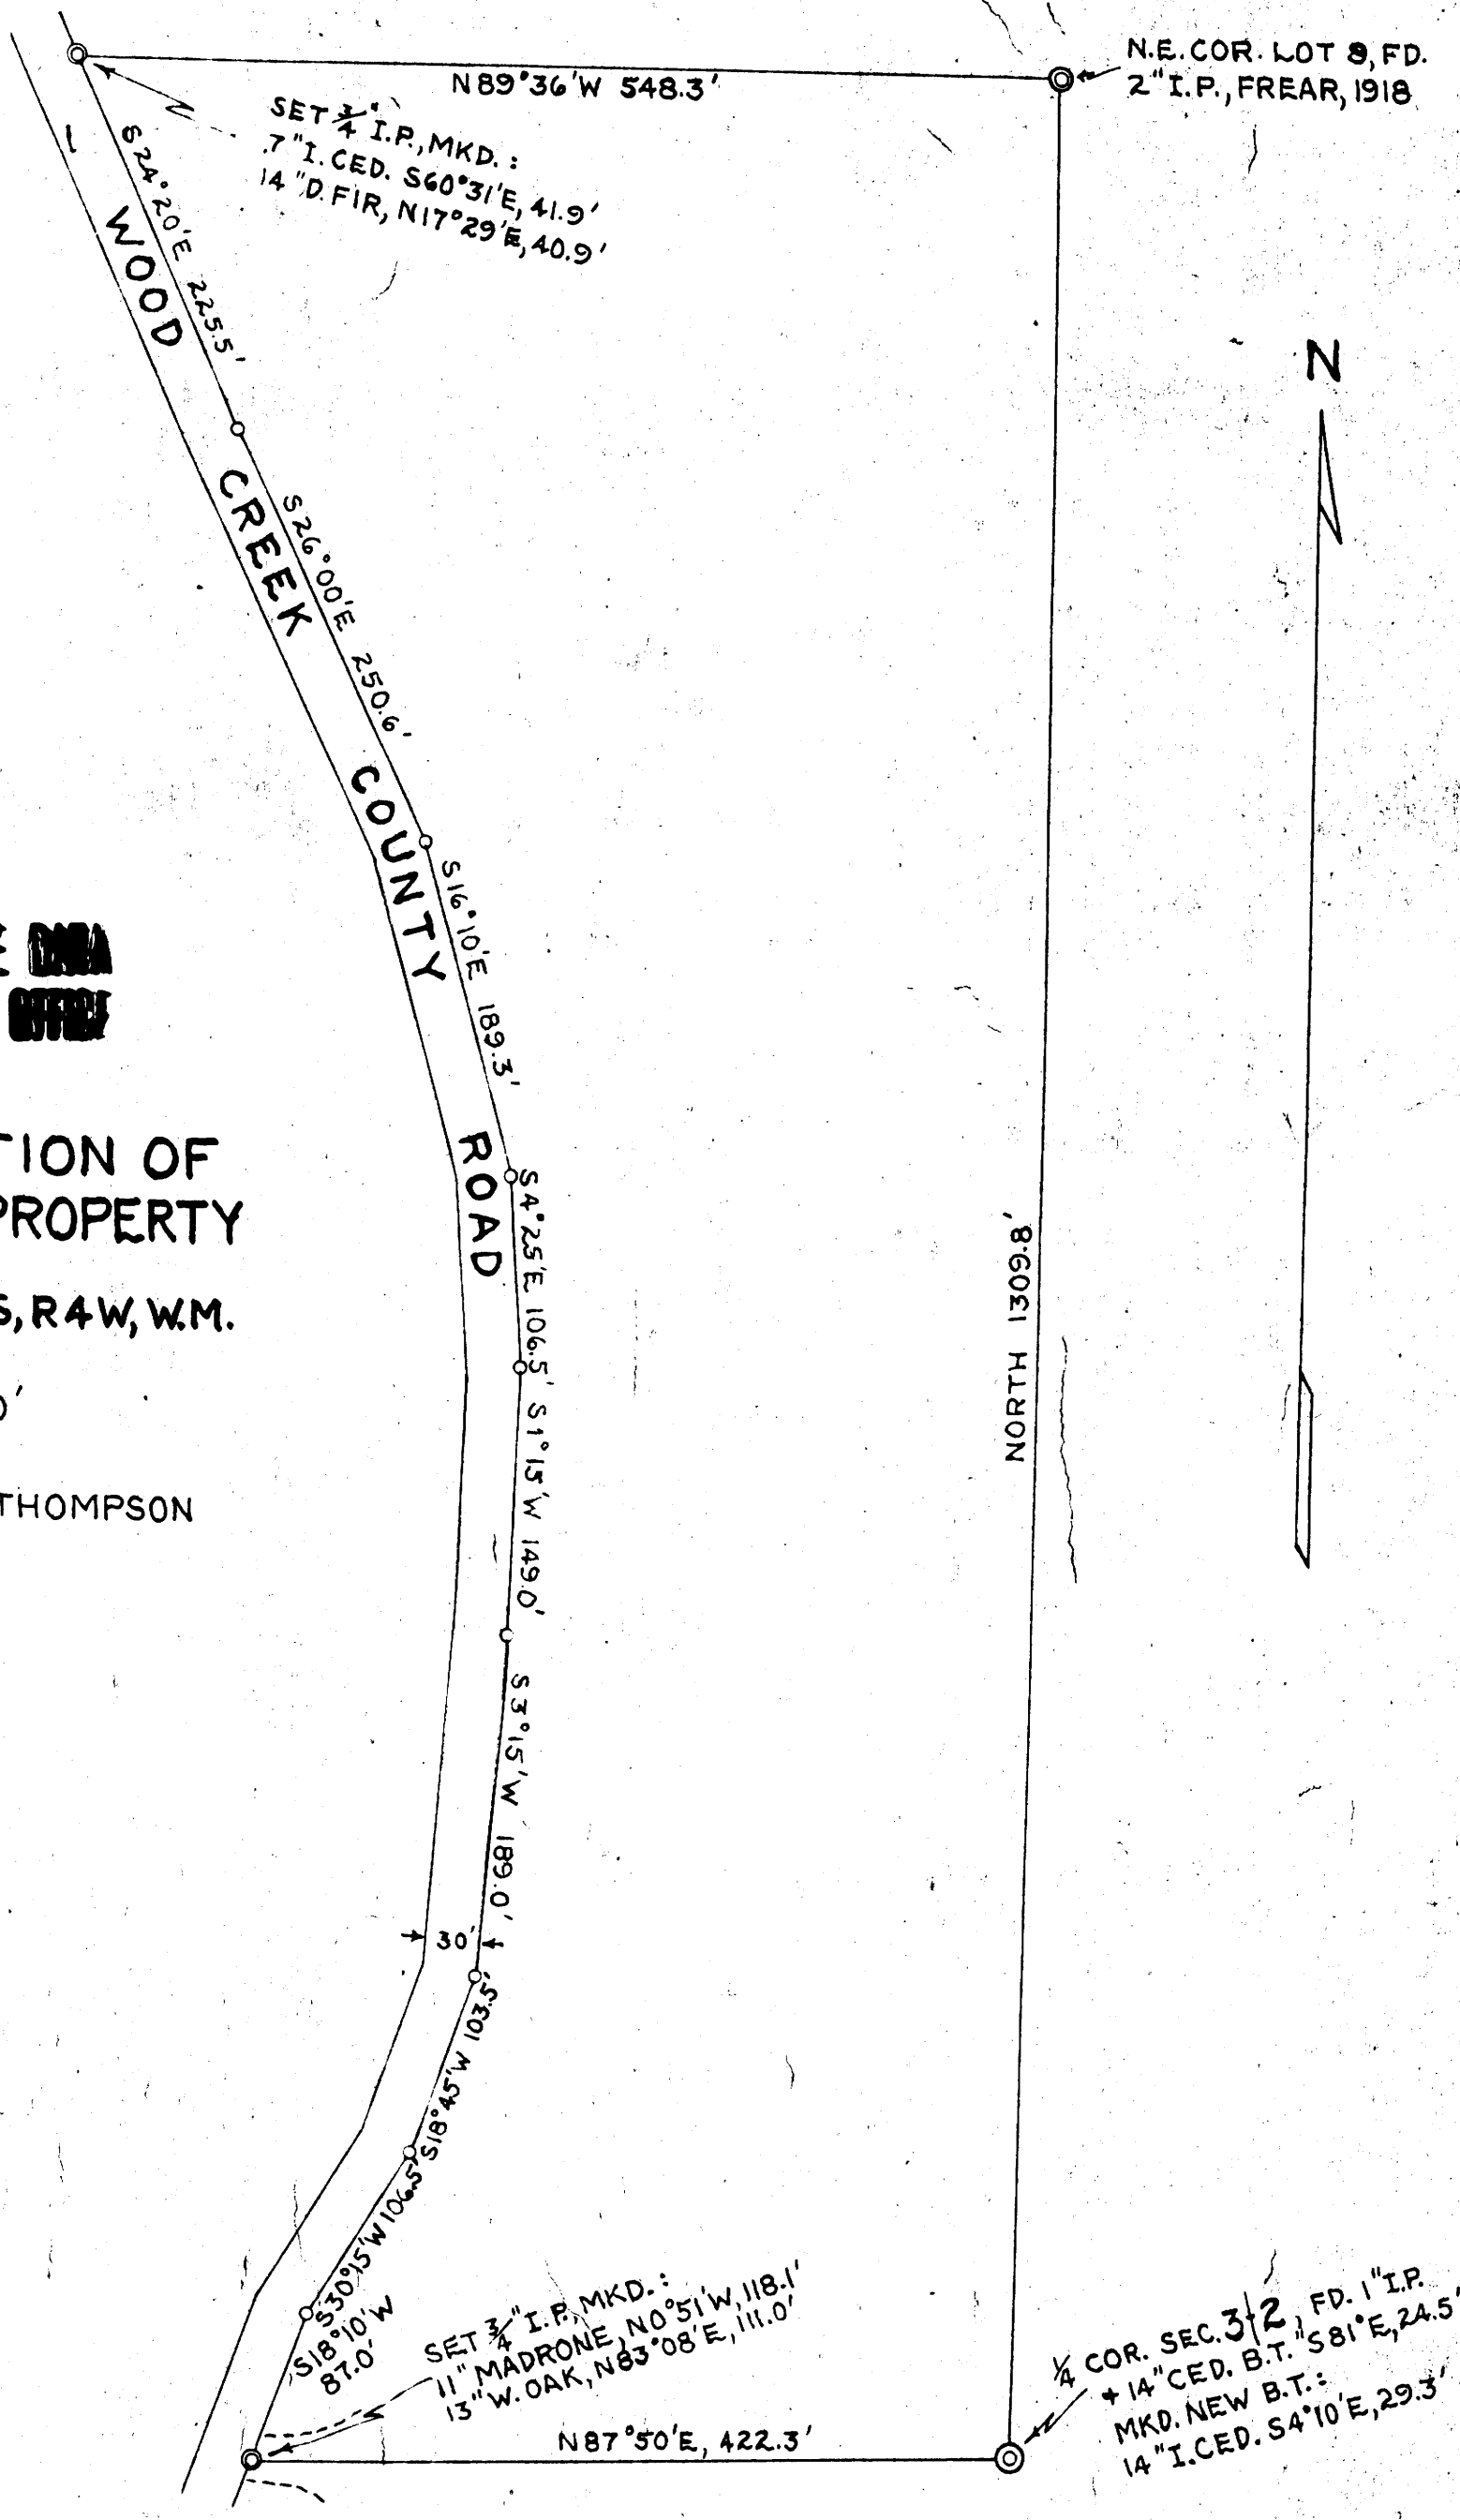

SNYDER
V 206, P373, DEEDS

THIS COPY MADE FROM
A XEROX 2510
DATE 1-9-89

C.S. File No. 42/171
MAP FILE M3-114