


WEAVER D. L. C. NO. 42

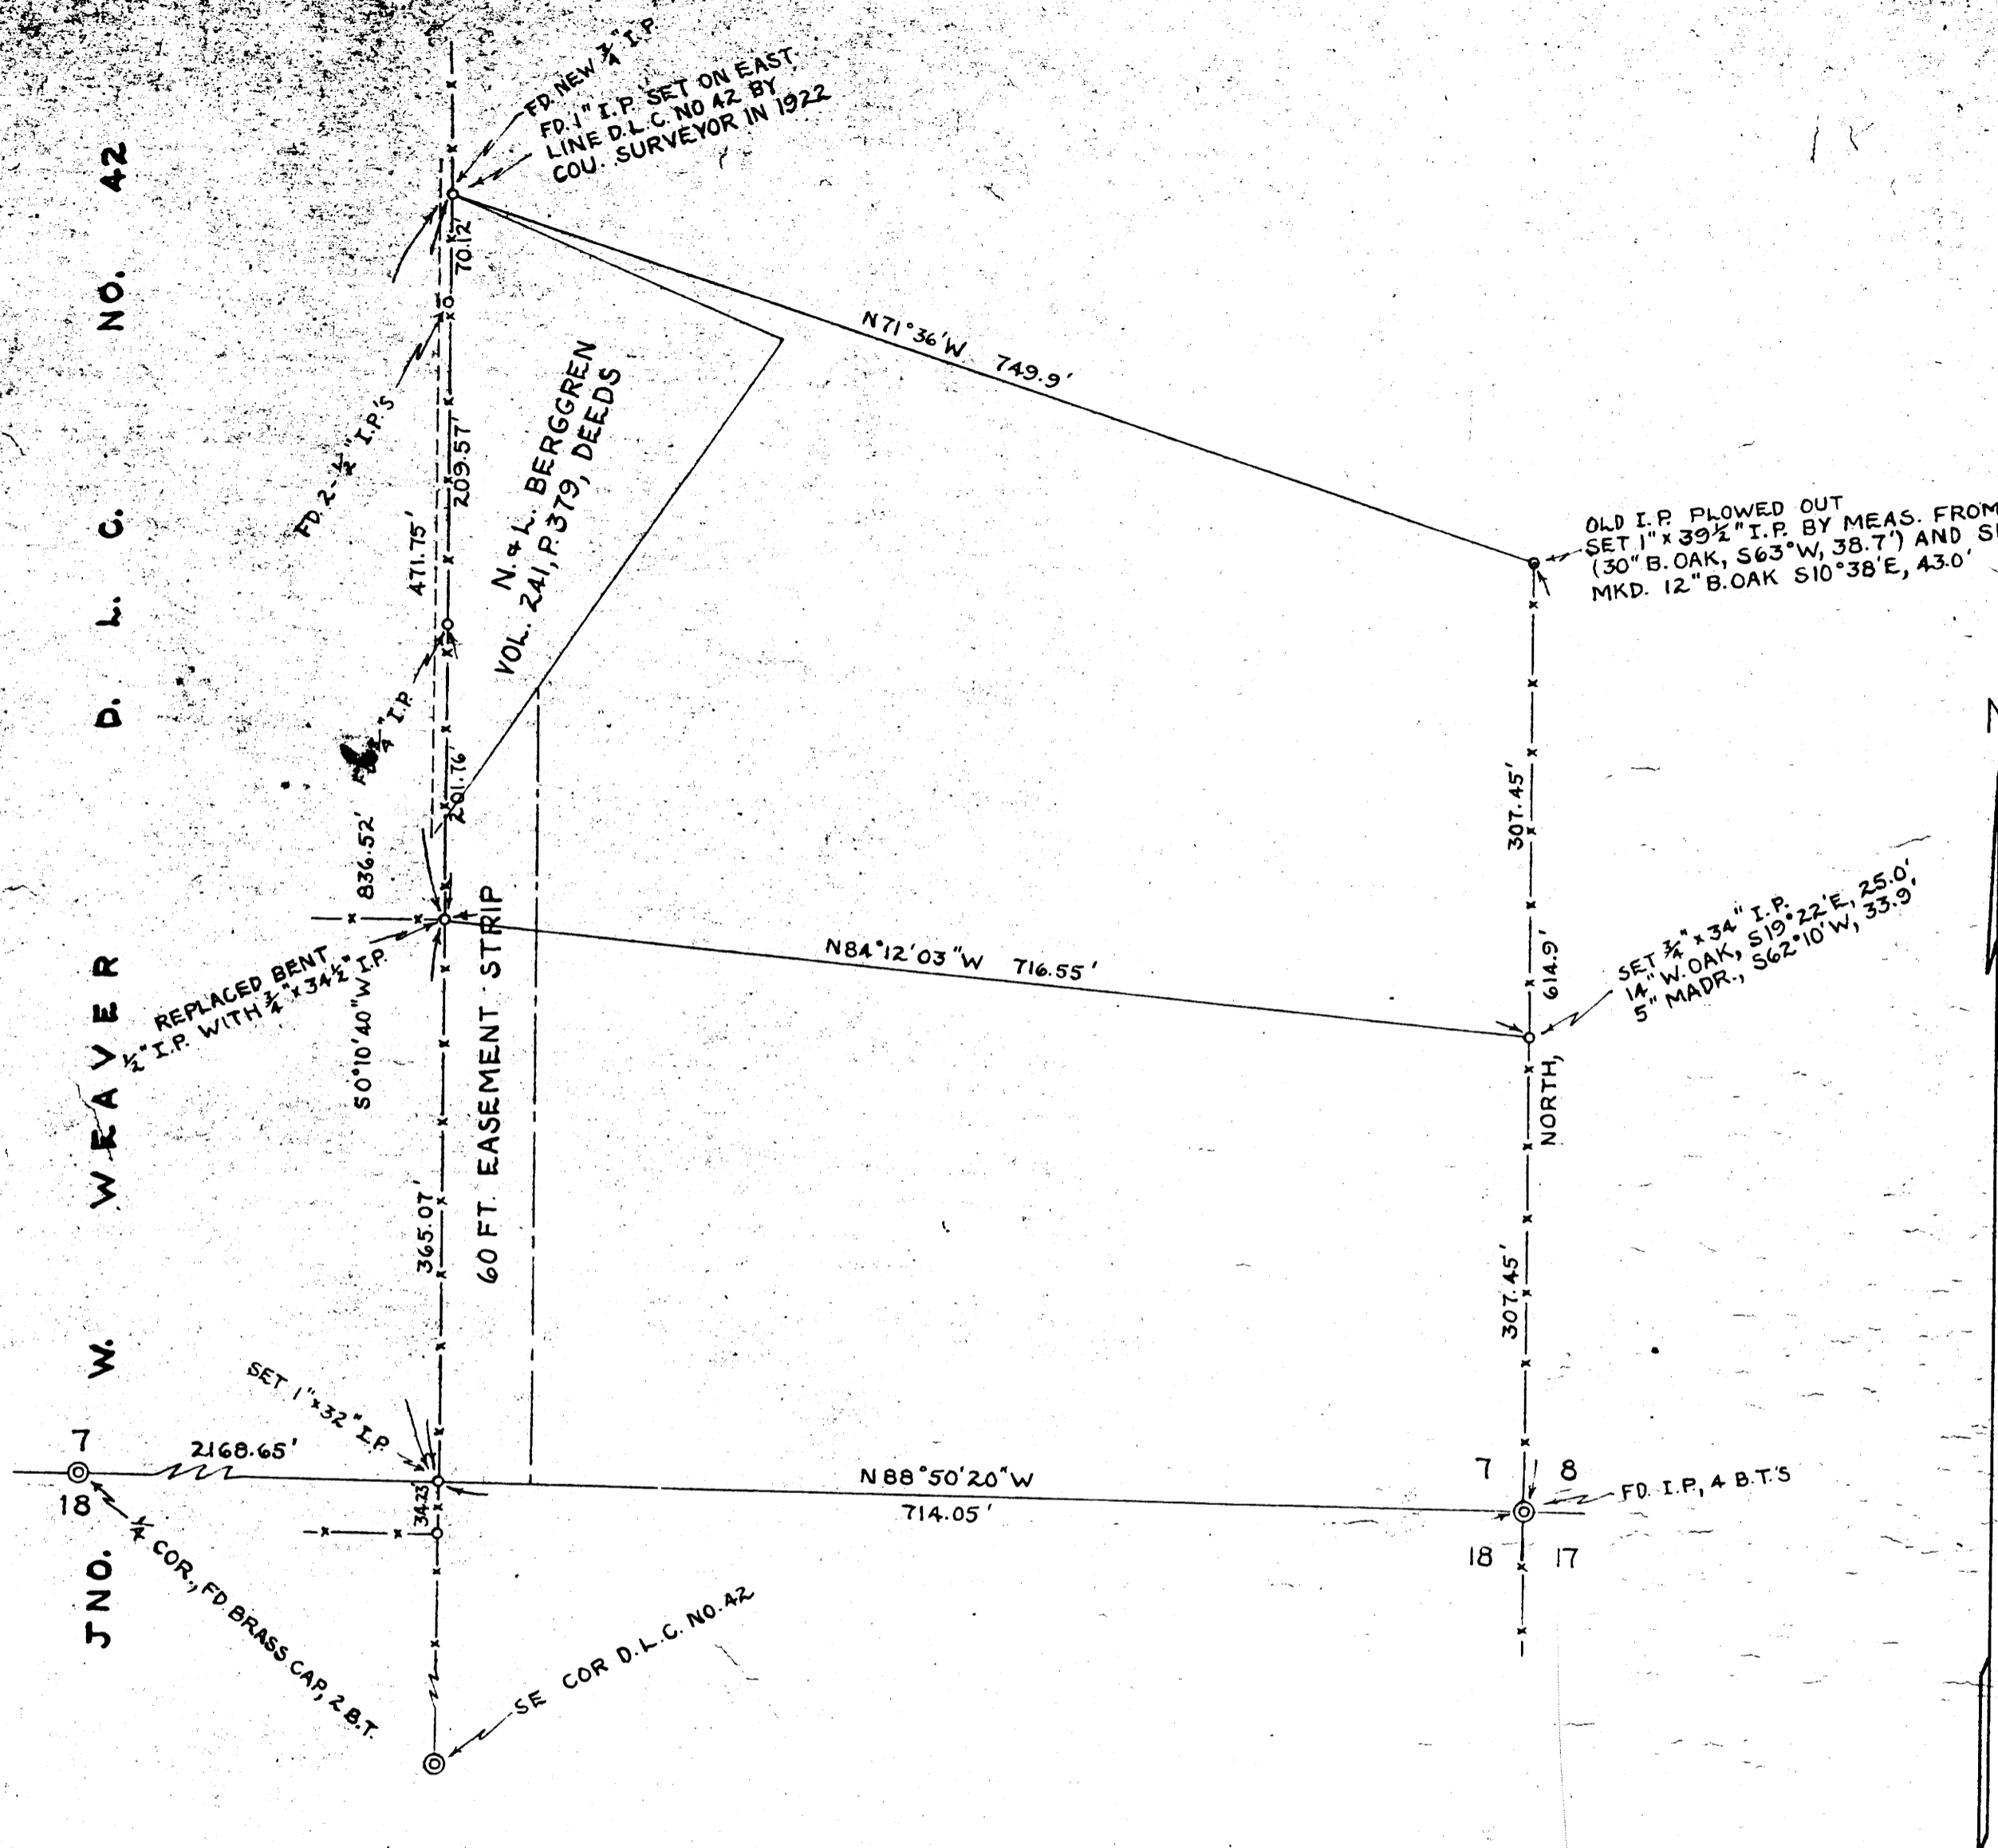

SURVEY TO SPLIT PORTION OF LOT 6, SEC. 7, T30S R5W, W.M. FOR WM. P. WEAVER

SCALE: 1 IN. = 100 FEET

MARCH, 1955

R. M. THOMPSON

Robert M. Thompson  
COUNTY SURVEYORS FILE DATA  
DO NOT REMOVE FROM OFFICE

THIS COPY MADE FROM  
A XEROX 2510  
DATE 1-9-89

C.S. File No. 41/371  
MAP FILE M3-1/16