


THIS COPY MADE FROM
A XEROX 2510
DATE 5-24-89

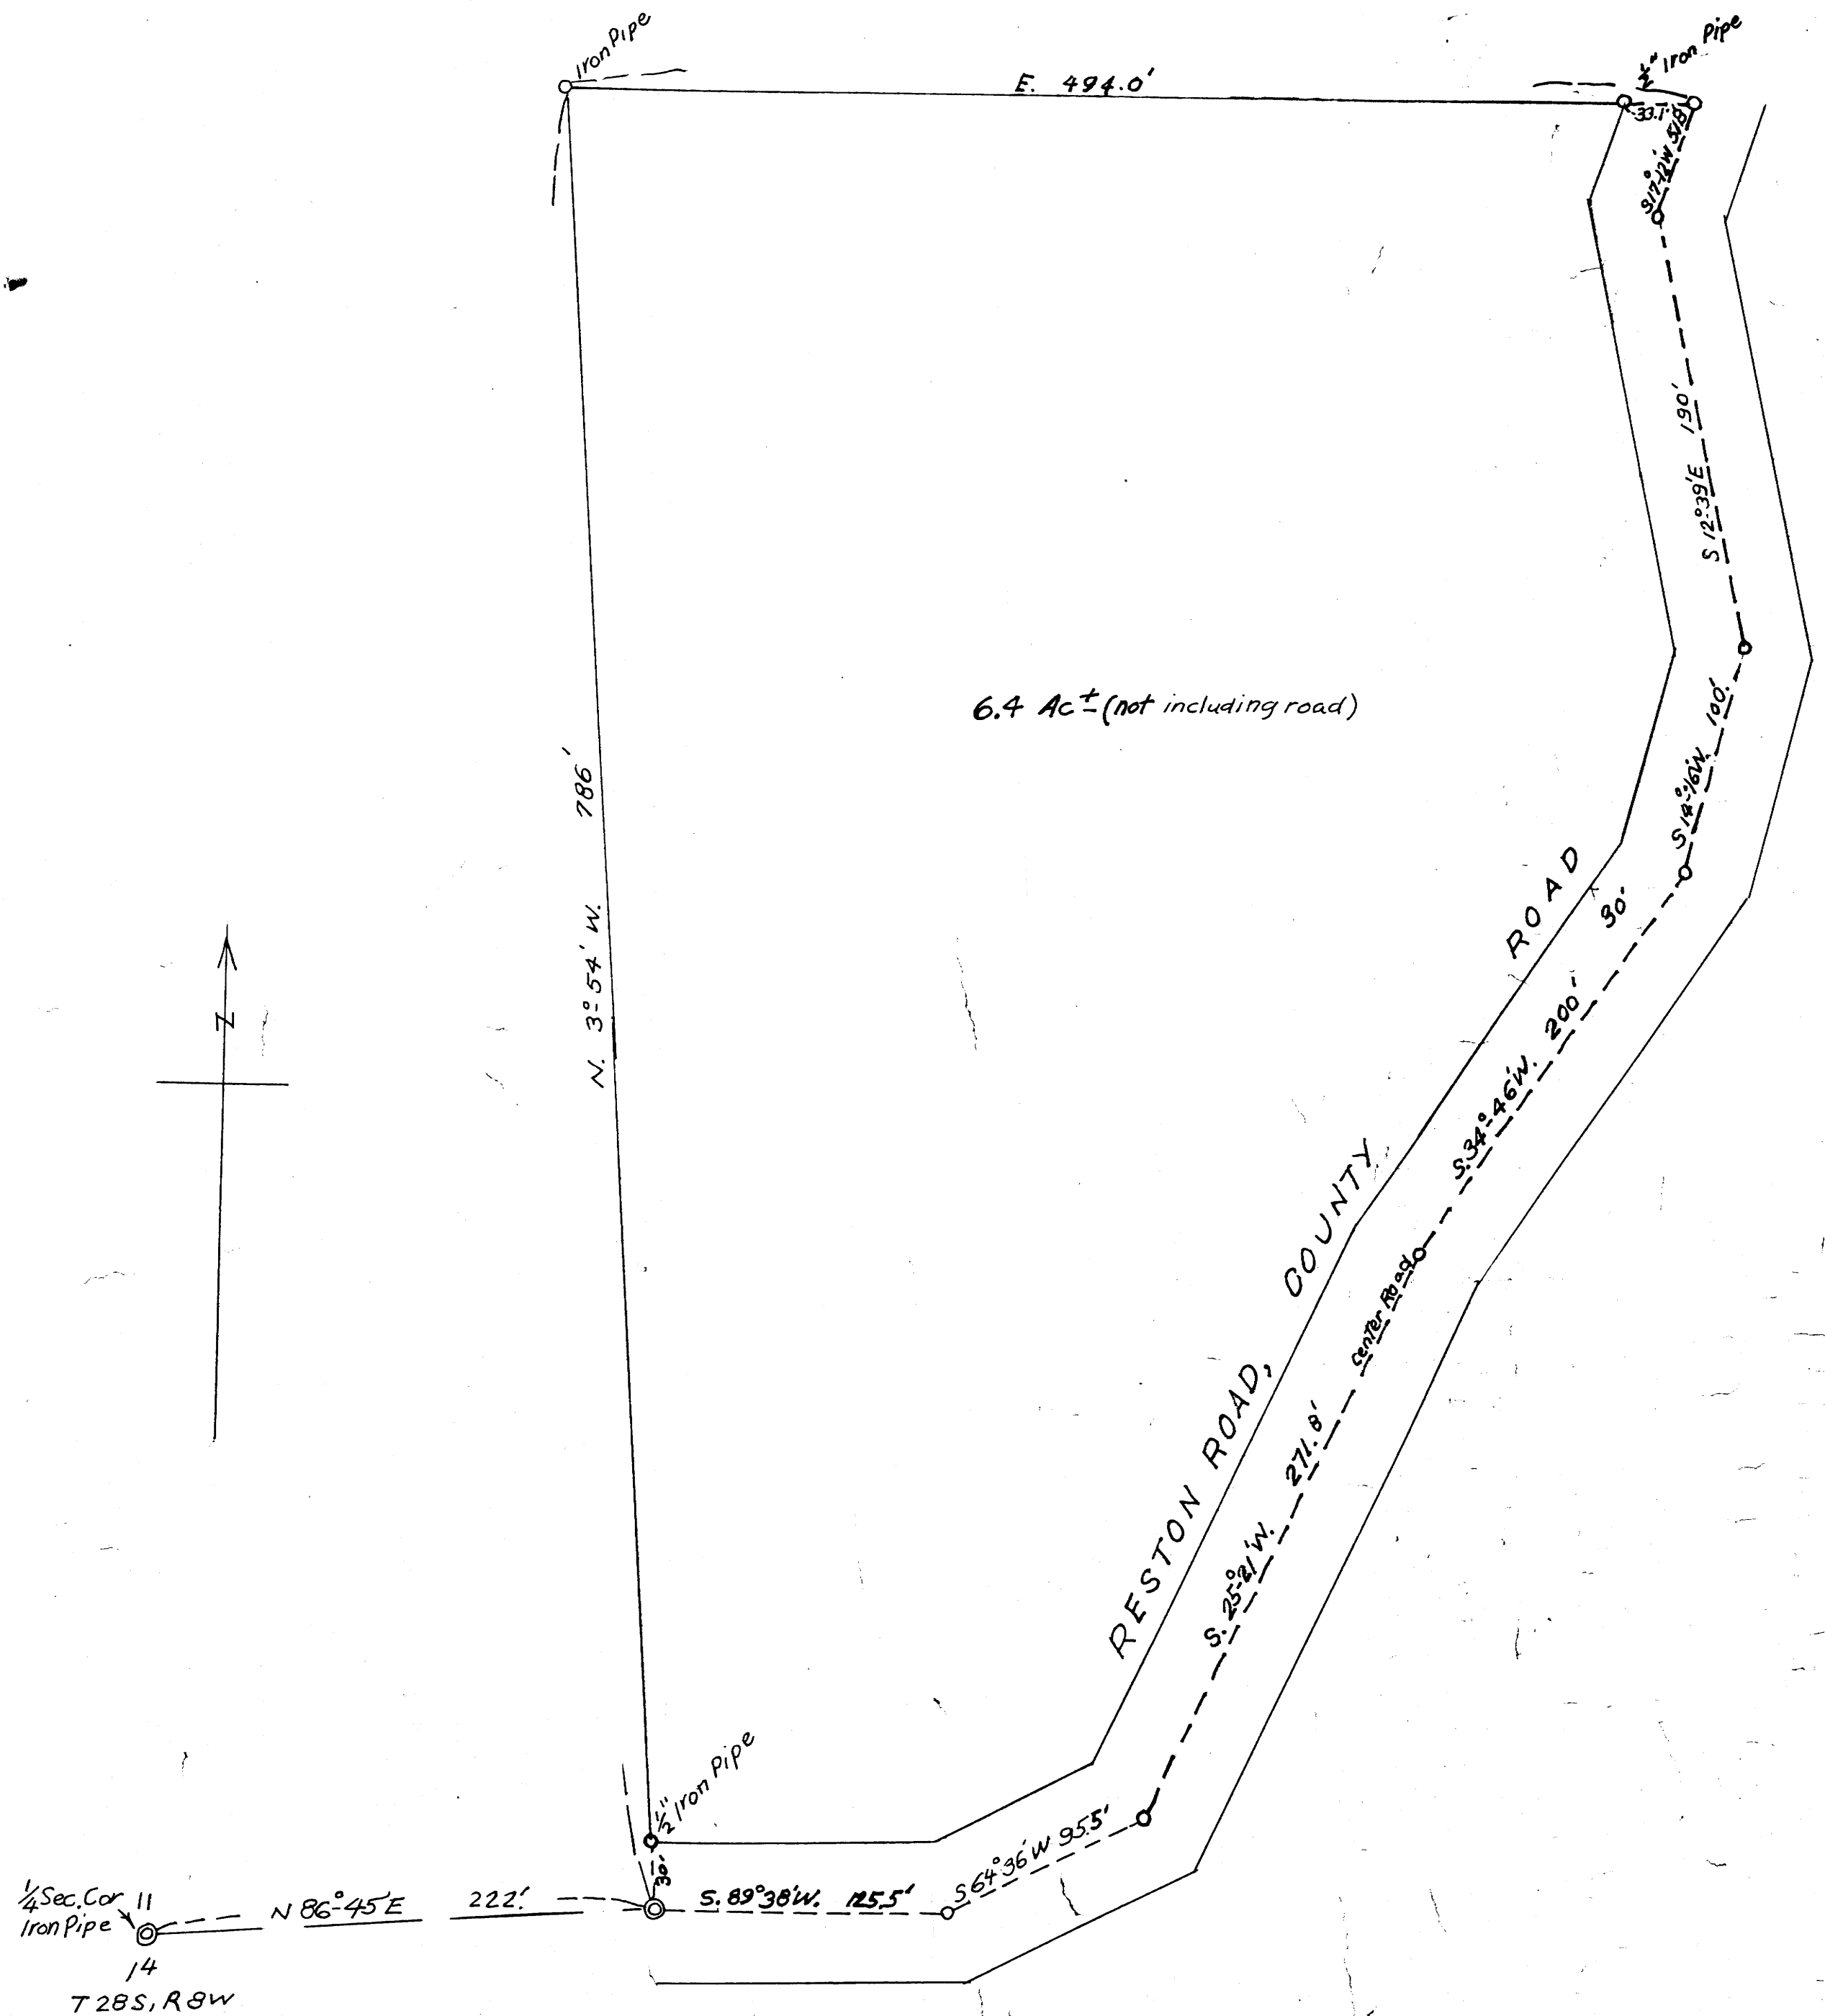

COUNTY SURVEYORS FILE DATA
(S) NOT REMOVE FROM OFFICE

ARCHIE
 "HUGH" WILLIS TO ~~ROY~~ WILLIS
 PROPERTY AT ABANDONED
 RESTON PUBLIC SCHOOL SITE
 IN SEC. 11, T. 28 S., R. 8 W., WIL. MER
 JUNE 1956

Archie Willis
 COUNTY SURVEYOR
 DOUGLAS COUNTY, ORE.

1" = 60 FT.

FILED
 RECEIVED
 OCT 31 1956
 COUNTY SURVEYOR
 DOUGLAS COUNTY, ORE.