

City of Canyonville
Sewerage Disposable
Site 2.95 Ac. Total.
1.54 Ac. on Flat

Note - 1/2" I.P. Set by R.M. Thompson
9" Fir N. 49° 49' W. 118
17" Fir S. 77° 48' E. 147


COUNTY SURVEYORS FILE DATA
DO NOT REMOVE FROM OFFICE

COUNTY SURVEYOR'S OFFICE
DOUGLAS COUNTY, OREGON.
SURVEY FOR
C.S. PRUDEN SEC. 27, T. 30 S., R. 5 W. W.M.
GEO. J. WENDEROTH, DEPUTY. DEC. 1955 & 1956.
Scale 1" = 100'

REGISTERED
OREGON
LAND SURVEYOR
Geo. J. Wenderoth
MARCH 10, 1944
George J. Wenderoth
5



Note - Assumed Bearing from
Survey of C.S. Collins 1947 and
R.M. Thompson 1955

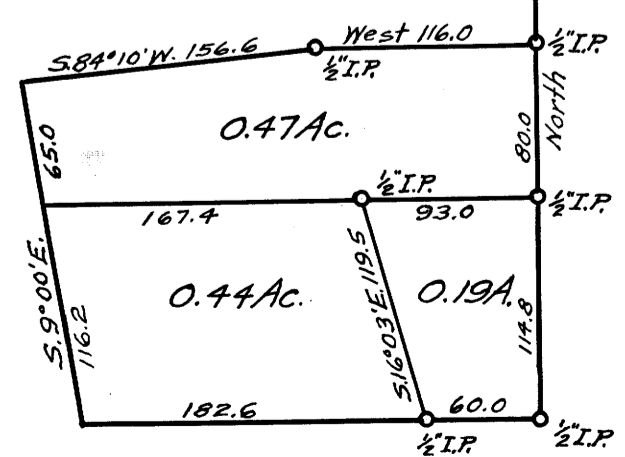

NOTE - FOR ADDITIONAL SURVEYS SEE
M 15 - 36 COUNTY SURVEYORS
OFFICE

FILED
RECEIVED
DEC 10 1956
COUNTY SURVEYOR
DOUGLAS COUNTY, ORE.