


G. A. HANSEN
PART OF LOTS 3 & 6
TOWN OF WILBUR
SECTION 18, T.26S.R.5W.
AUGUST 1956 1"=50'

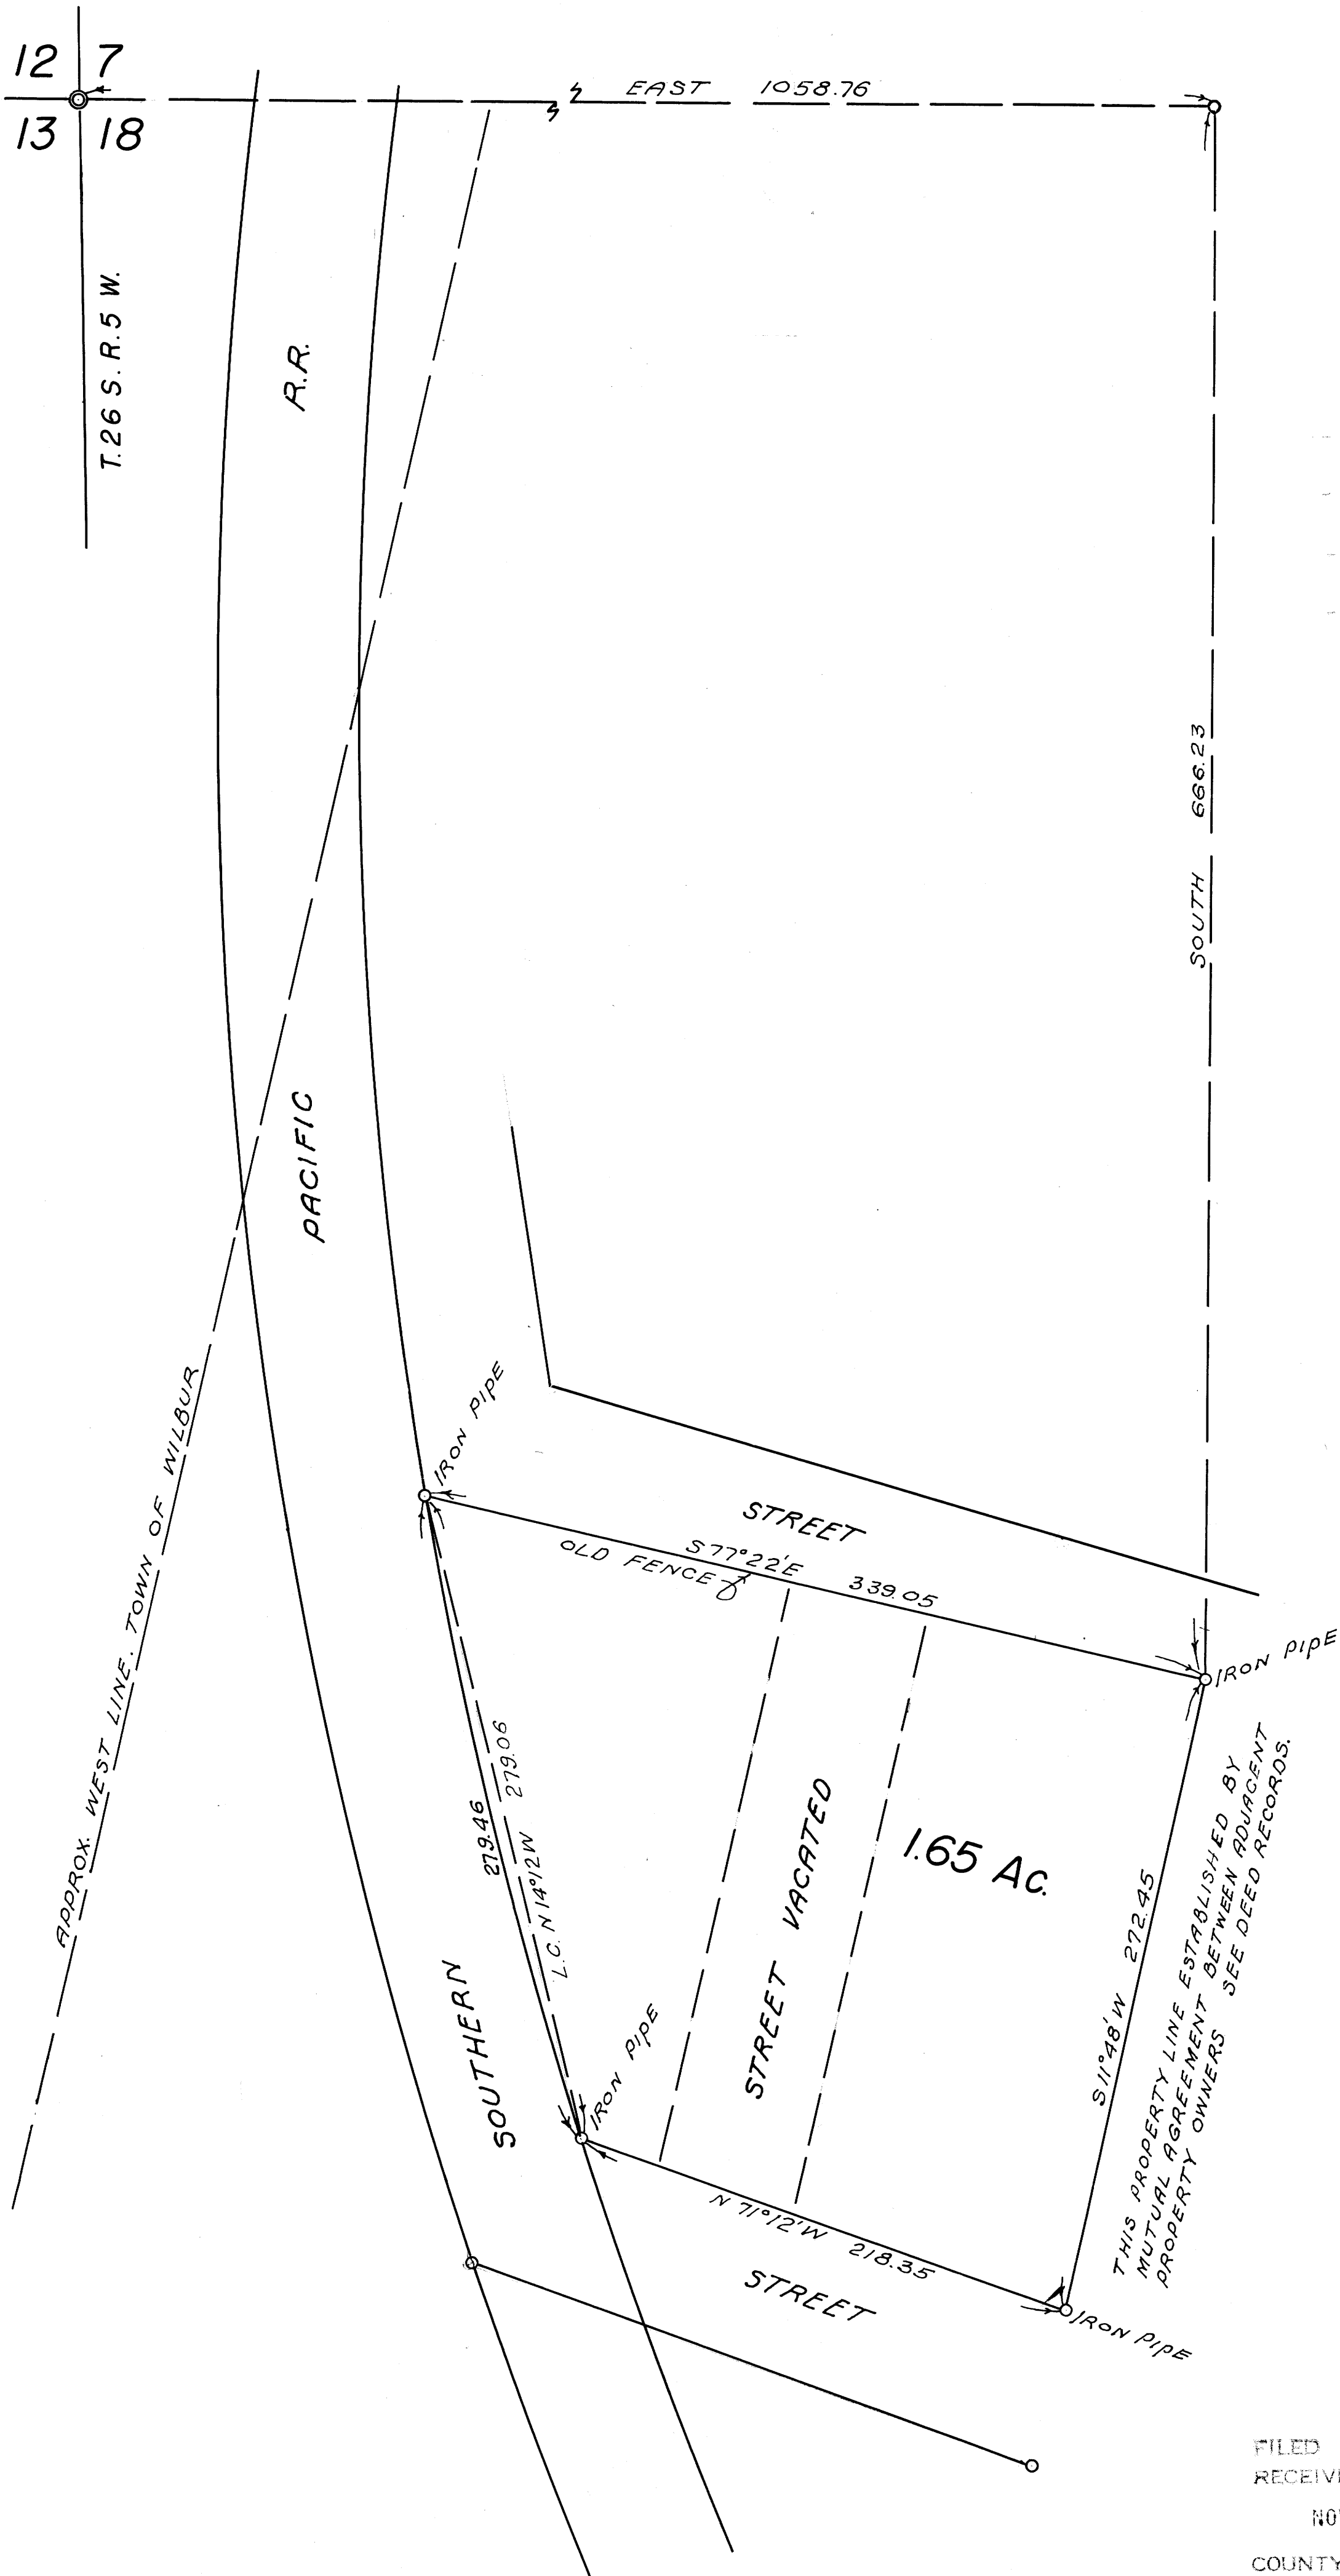

FILED
RECEIVED

NOV 26 1956

COUNTY SURVEYOR
DOUGLAS COUNTY, ORE.