


S 89° 32' E
9102.1

19 20
30 29

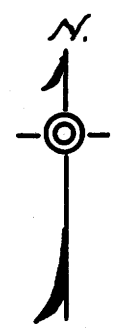

COUNTY SURVEYORS FILE DATA
DO NOT REMOVE FROM OFFICE

MAP

SECTION 30, T. 25 S., R. 14 W., W. M.

Showing length and bearing of exterior boundary lines of Lots 3, 4, 5, 6, 7, 8, 13, 14, 15, 16, 17, & 18.

⊙ Original corners found
○ Corners established
True lines run & blazed are shown solid, others random only.

Scale 1" = 600'

Dec. 10, 1956

U. H. ...

FILED
RECEIVED

DEC 12 1956

COUNTY SURVEYOR
DOUGLAS COUNTY, ORE.

C. S. File No. 42/203
MAP FILE M3 145