
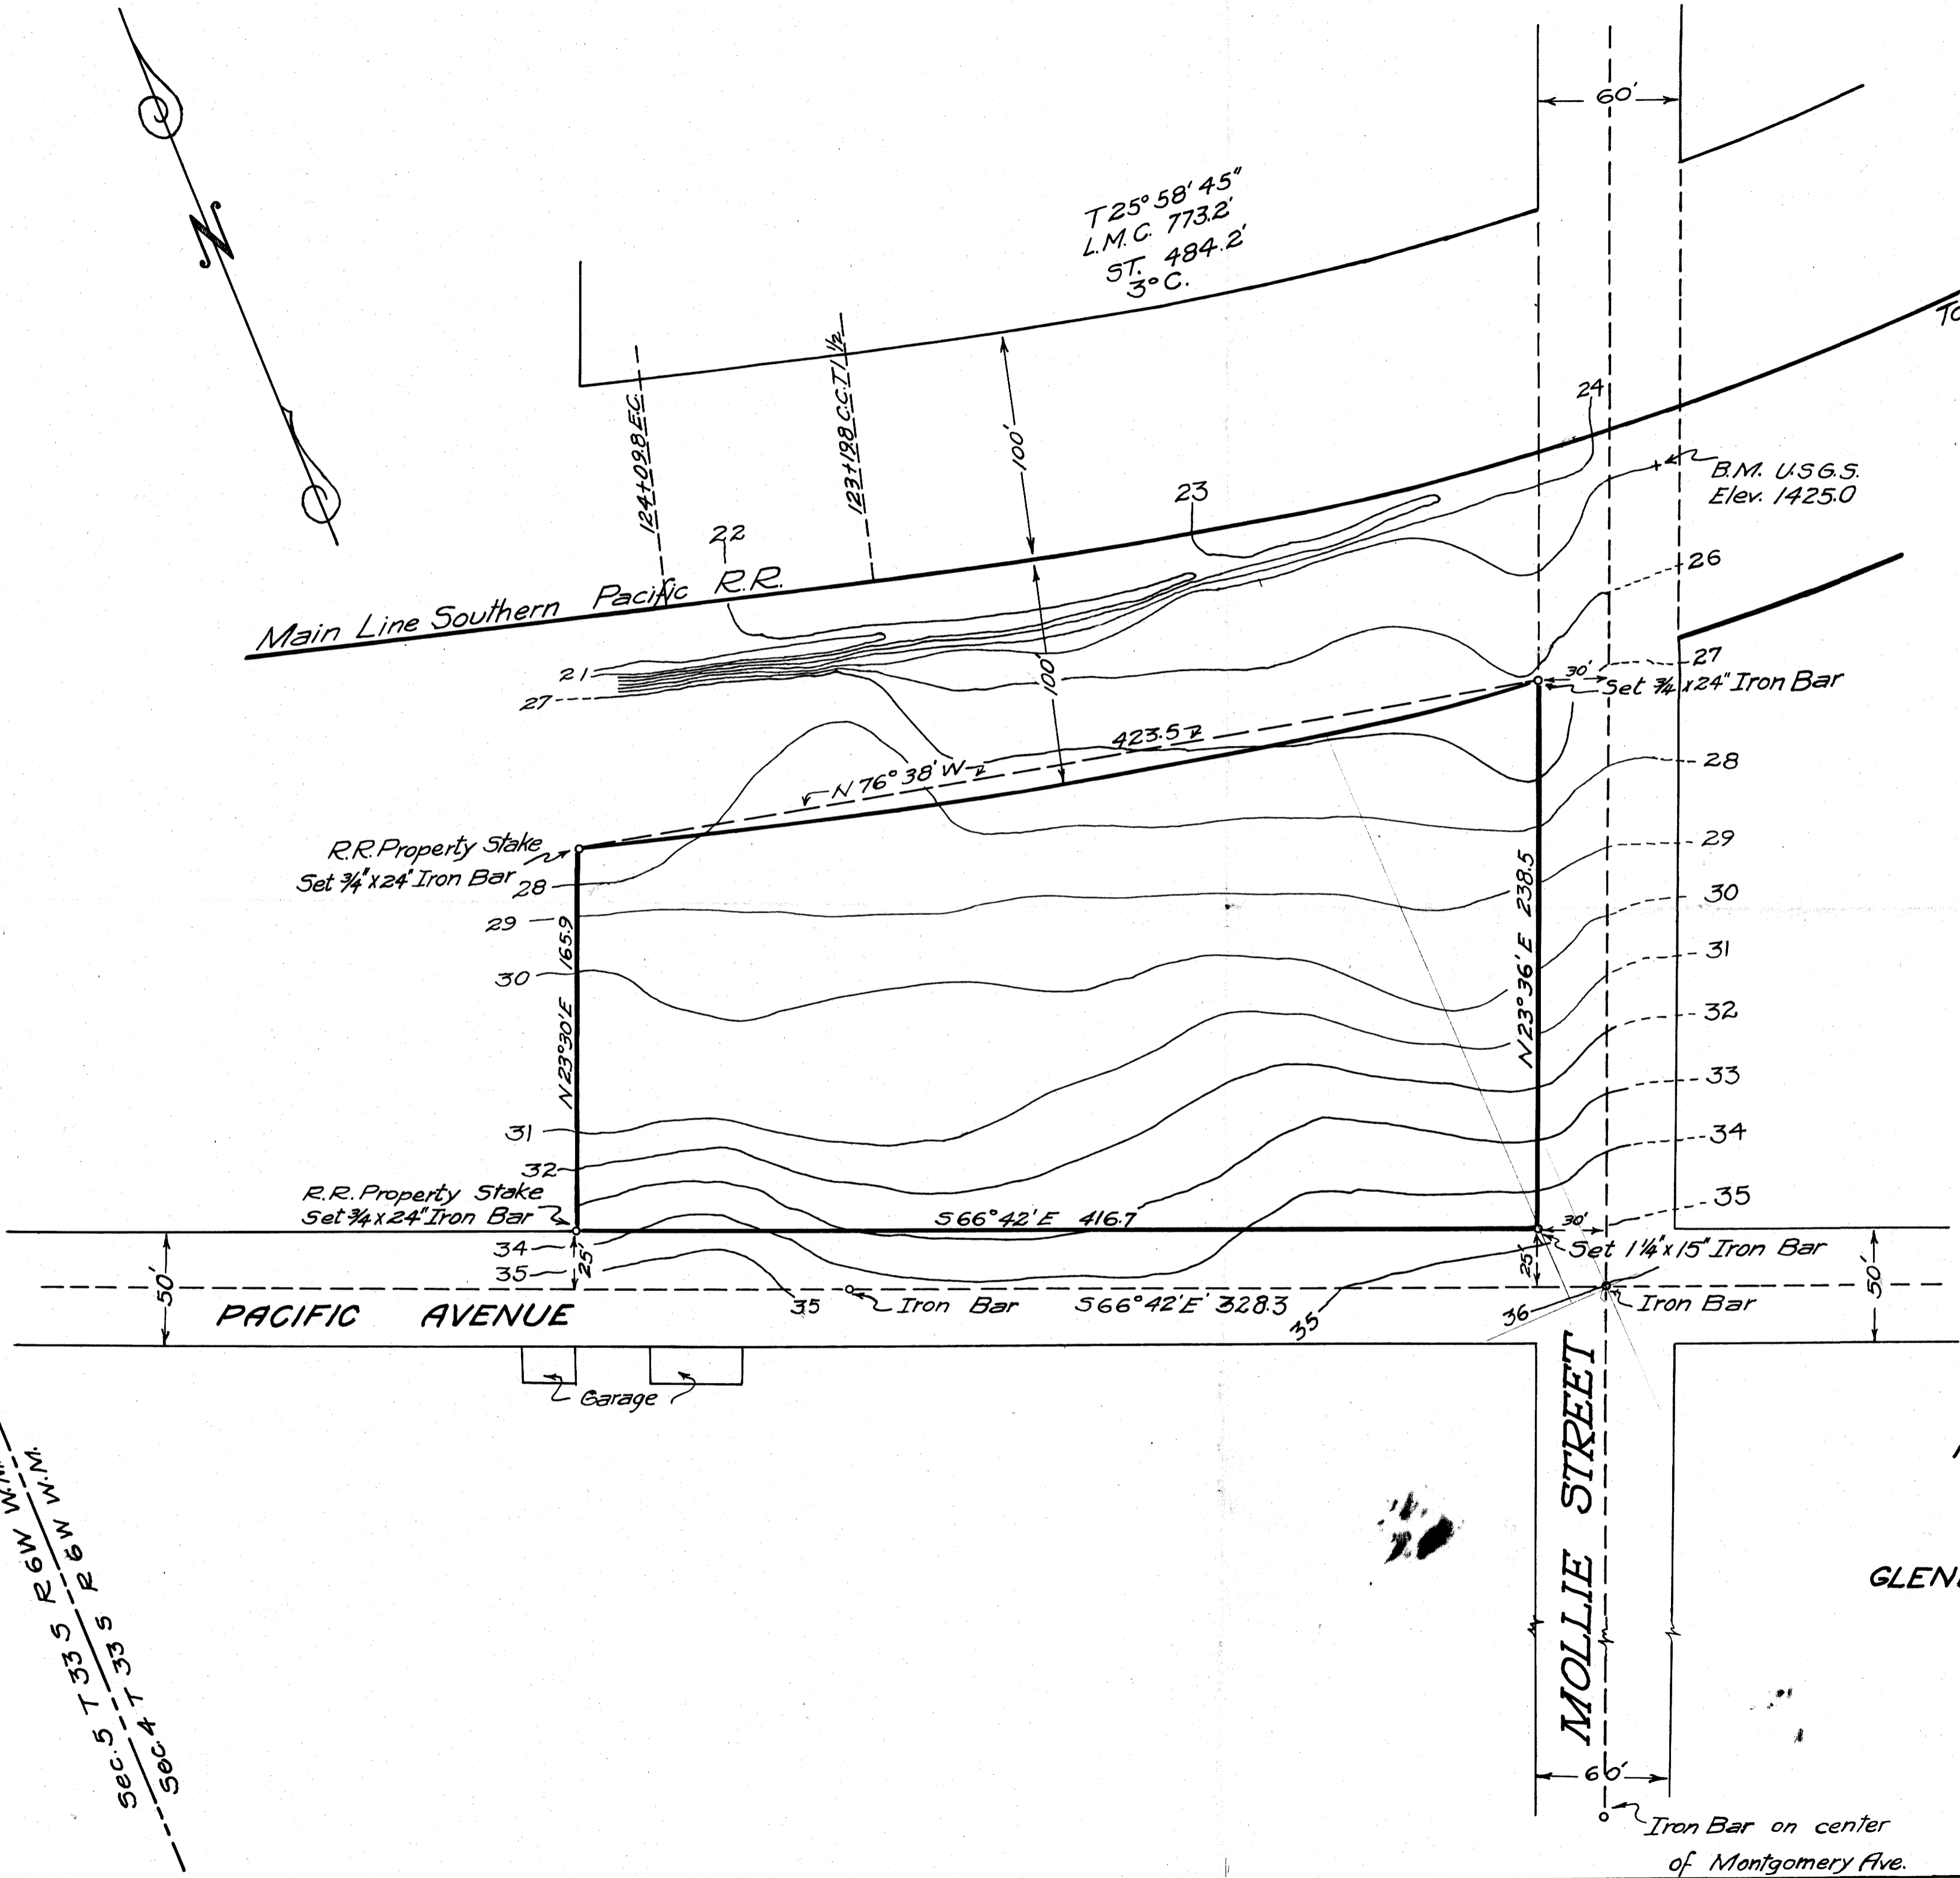


C.S. File No. 22/22
M.B. 65

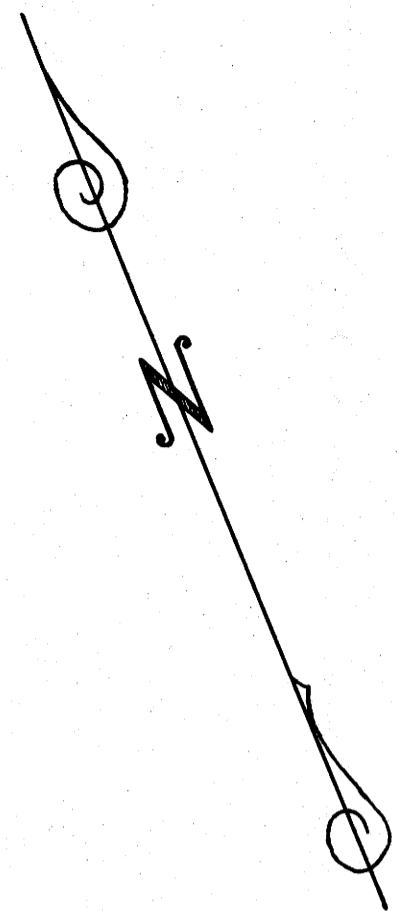

**COUNTY SURVEYORS FILE DATA
DO NOT REMOVE FROM OFFICE**

MAP OF TRACT FOR
UNION OIL CO.
GLENDALE - DOUGLAS CO. OREGON
Sec. 4 T 33 S R 6 W W.M.
H.L. Eppstein, County Surveyor
Scale 1" = 50'
January 17-1929

Drawn M.C.B.
County Surveyors File 22/22

MAP FILE M 3 - 65
Sec. 5 T 33 S R 6 W W.M.
Sec. 4 T 33 S R 6 W W.M.

MOLLIE STREET

Iron Bar on center
of Montgomery Ave.