


FILED  
RECEIVED

JAN 30 1957

COUNTY SURVEYOR  
DOUGLAS COUNTY, ORE.

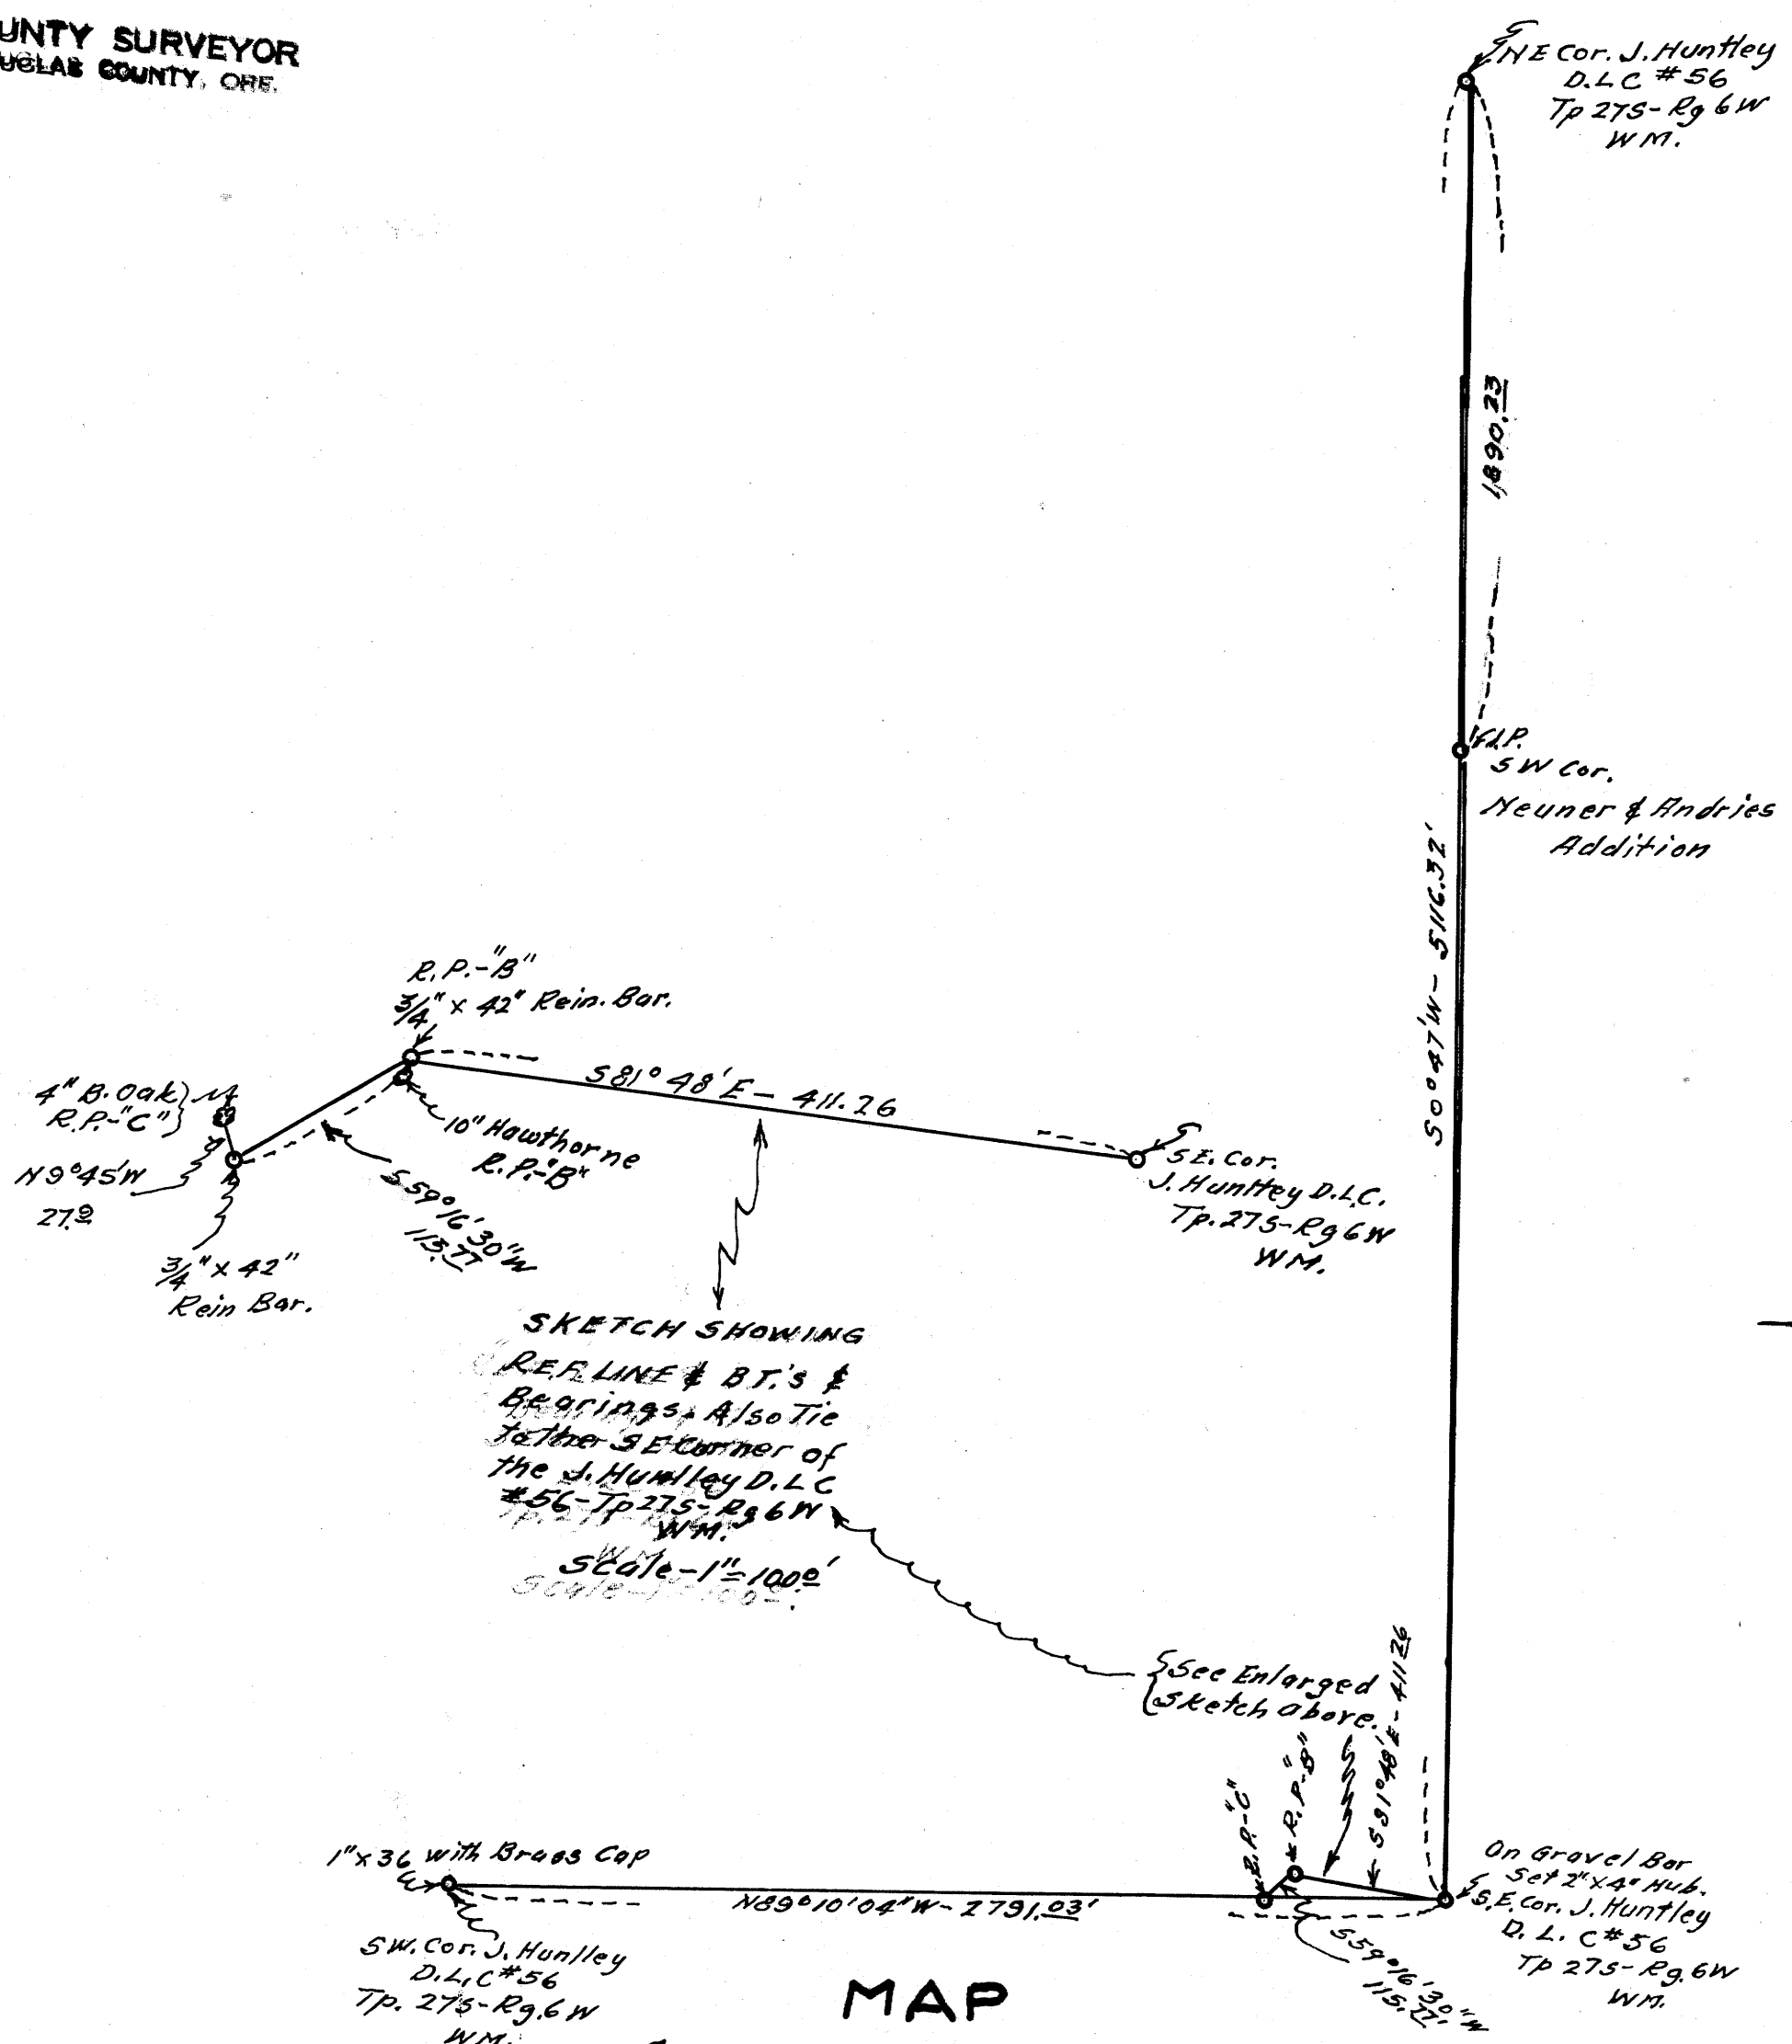

SKETCH SHOWING  
REF. LINE & BT.'S &  
BEARINGS. Also Tie  
to the SE. Corner of  
the J. Huntley D.L.C.  
#56 - Tp. 27S - Rg. 6W  
T. 27S - R. 6W  
Scale - 1" = 100'

**MAP**  
SHOWING LOCATION  
OF  
SE. Cor. J. HUNTLEY  
D.L.C. No. 56.  
Tp 27S - Rg. 6W W.M.  
SURVEYED FOR  
J. R McALLISTER  
CONTRACTOR.  
Scale 1" = 500' August 1956

