


Scale 1" = 10'

Note:

Black-Property Lines  
Red-Lines Used or Proposed.  
Green Lines Buildings

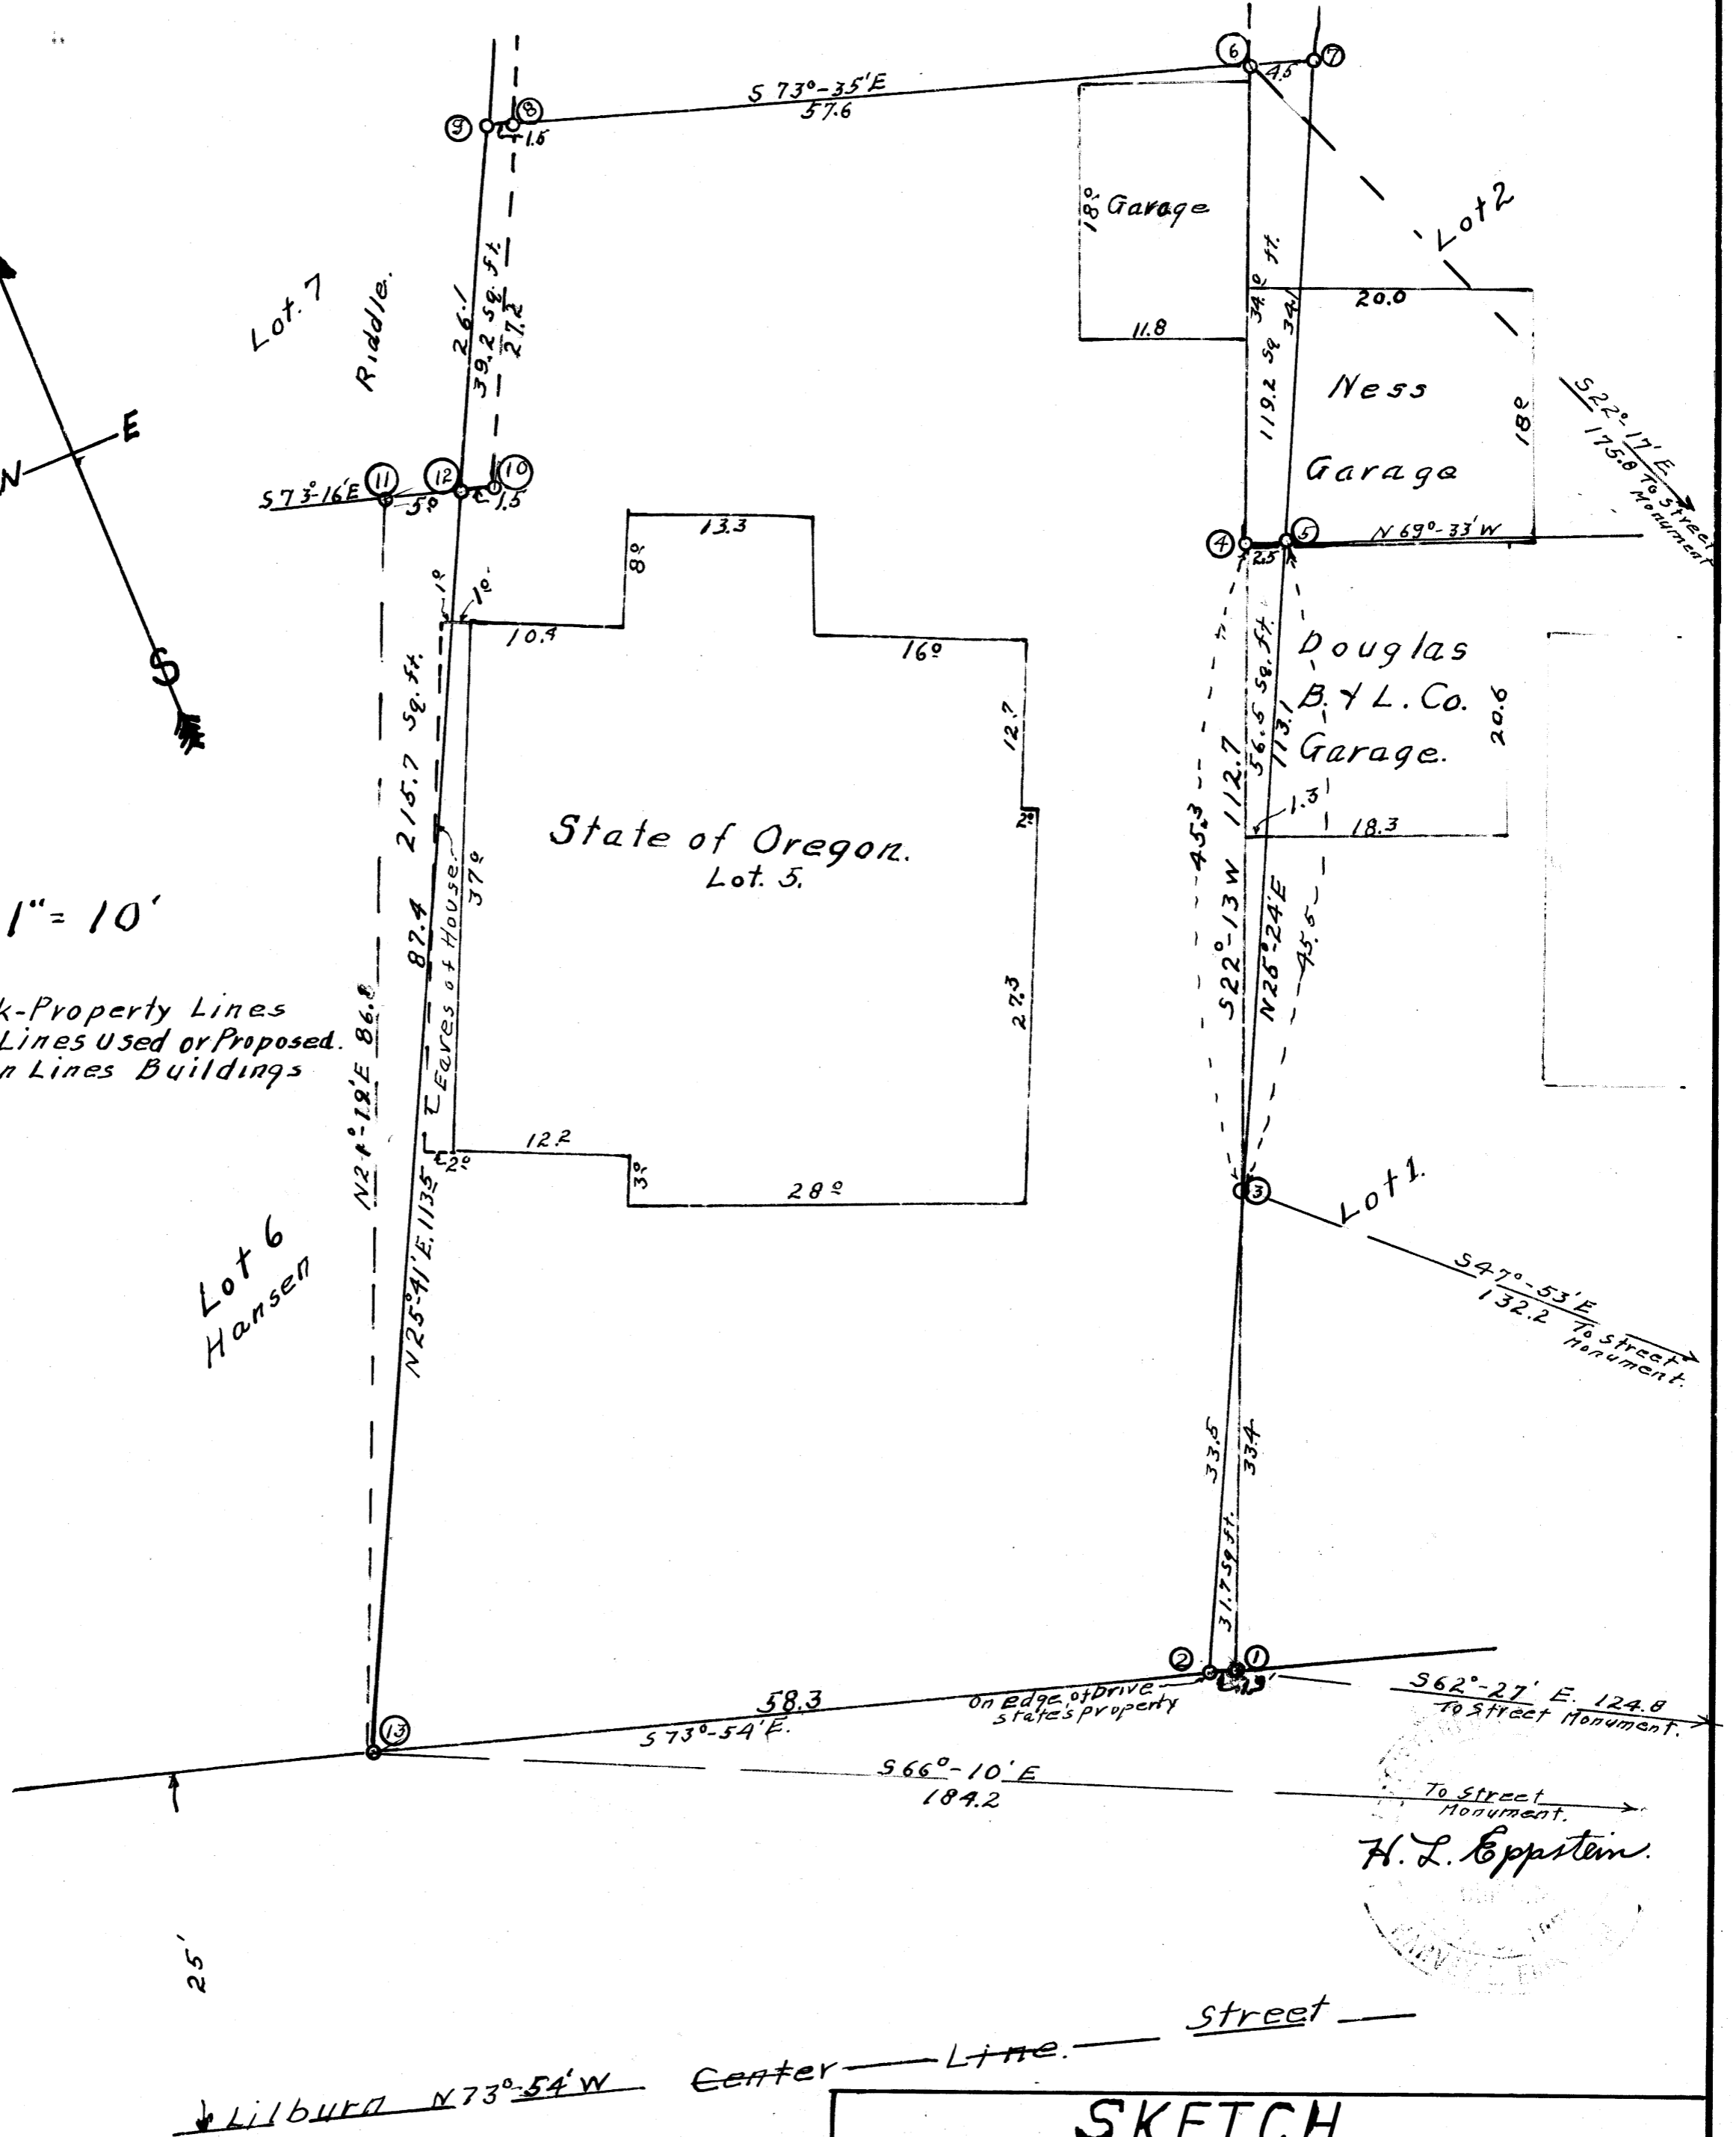

Lot 6  
Hansen

Lot 7

Riddle.

State of Oregon.  
Lot 5.

Douglas  
B.Y.L. Co.  
Garage.

Ness  
Garage

18' Garage

Lot 1

Lot 2

H. L. Eppstein.

Liburd N 73° 54' W Center Line Street

SKETCH  
of  
Lot 5, Block B.  
Laurel Wood Addition  
Roseburg, Oregon.  
Showing Building Location  
H. L. Eppstein, Co. Surveyor. Apr. 4, 1939

COUNTY SURVEYORS FILE  
DO NOT REMOVE FROM FILE