

COUNTY SURVEYORS FILE DATA
DO NOT REMOVE FROM OFFICE


7 8
18 17
FOUND BRASS CAP
2000.12'

COUNTY SURVEYOR'S OFFICE
DOUGLAS COUNTY, OREGON

SURVEY FOR DEED DESCRIPTION
SECTION 18, T26S., R3W, W.M.

FRED M. DARBY COUNTY SURVEYOR
SURVEYED FEB. 13, 1957 BY
JAMES W. BYRON-DEPUTY SCALE 1" = 100'
SURVEYED FOR ADRIAN STANDLEY

James W. Byron
DEPUTY COUNTY SURVEYOR

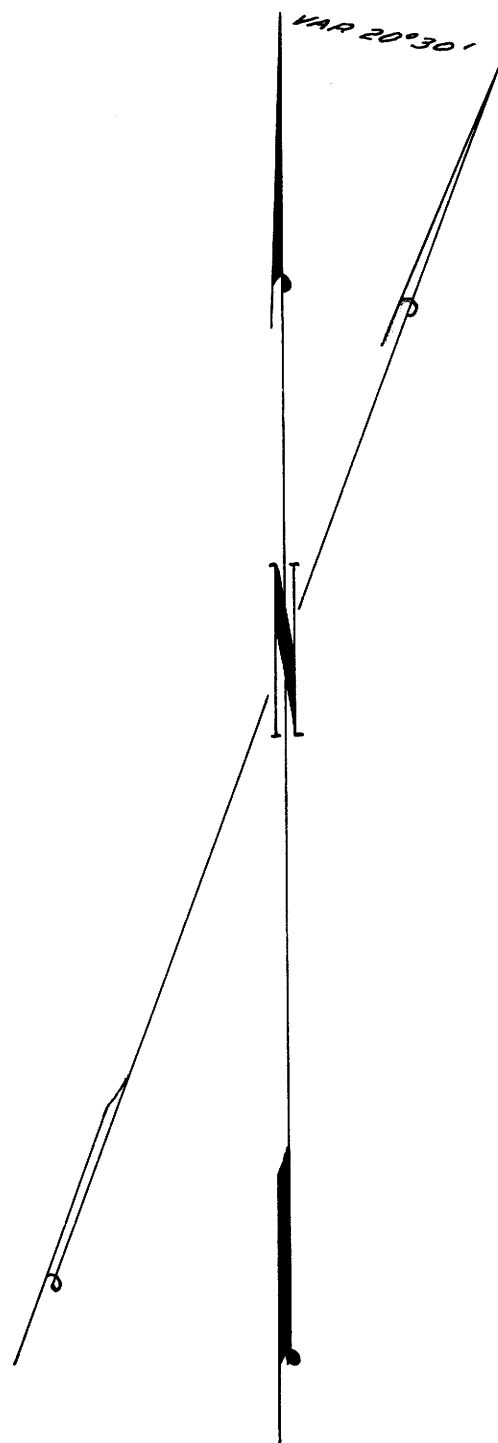

NOTE:
BASES OF BEARINGS 50°23'N
ALONG SECTION LINE (C.S. FILE 46/154)

