

MAP FILE M4 148

This Pt. 760' N & 203' E. of U.S.G.L.O. Cor set for N.W. Cor. Sec. 12

Found 20' Fir Tree Scribed on S. Face T23S R6W L52

W. 2553.5' OLD FENCE

Found 3" Iron Pipe 4x4 Post, Scribed 1/4 S 7/16 Govt. yellow tag at Fence Corner

NW Cor Sec 12

Evidence for setting this corner was probably a smooth faced cedar stump which bore no markings (to the N.E) of pipe-stump. No evidence for BT could be found on stump.

Found Pipe by U.S. Gen. Land of's 78' W. of Cor. Set for S.W. Cor. SEC 12 - 1943

2693.6

5091.2

No evidence of 1/4 Cor could be found along line running N45.

W. 2814' to Point on Line bet. U.S.G.L.O. Corners

Found Cor. Previously Set for Center Sec. 18 E of line South of N 1/4 Cor

41 chs N of Cor 1/4 orig notes

31 chs W of Cor 9/16 orig notes

1538

Found Pipe by U.S.G.L.O. for SW. Cor Sec. 12 - 1943

No evidence of orig corner found

Approx. Locn. U.S. G. L. O. Cor. which has been lost or destroyed by logging operations at corner

Yellow tag on tree stump. Marked 745' E of 1/4 Cor. 12 (Dist prob. paced) before cor pipe was destroyed




THIS COPY MADE FROM A XEROX 2510 DATE 2-9-89

FILED RECEIVED FEB 26 1957 COUNTY SURVEYOR DOUGLAS COUNTY, ORE. JMD

W 1/2 SEC. 12, T.23S; R.6 W; W.M. FOR TWO BROTHERS LUMBER CO; (PHILLIPS BROS) YONCALLA ORE. FEB. 1957 1"=400 ft.

COUNTY SURVEYORS FILE DATA DO NOT REMOVE FROM OFFICE

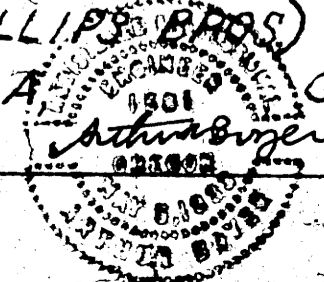

MAP FILE M4 148