


COUNTY SURVEYORS FILE DATA
DO NOT REMOVE FROM OFFICE

COUNTY SURVEYOR'S OFFICE
DOUGLAS COUNTY, OREGON

SURVEY TO SET LOT CORNERS
BLOCK I, BROWN'S ADD. TO R. R. ADD.,
TO - OAKLAND

FRED M. DARBY COUNTY SURVEYOR
SURVEYED MAR. 18, 1957 BY
JAMES W. BYRON - DEPUTY SCALE 1" = 100'
SURVEYED FOR E.L. McDONALD

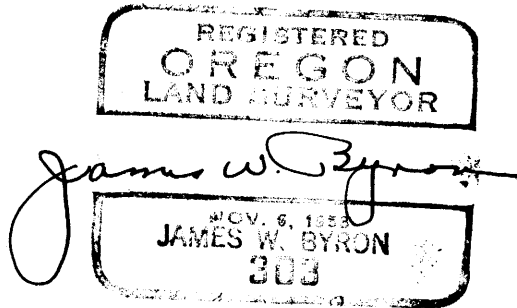

NOTE:
BEARINGS SHOWN ARE TRUE, AS BASED ON
THE PLAT OF "MARTIN HEIGHTS," REC IN
VOL. 9, PAGE 30.

