

N.E. CORNER LOT 153  
SUNNYDALE ORCHARDS  
9 10  
16 15  
T. 22 S. R. 6 W.



COUNTY SURVEYORS FILE #  
DO NOT REMOVE FROM BOOK

FRANKLIN P. CUNNINGHAM

DRAIN

MARCH 1955

1"=100'

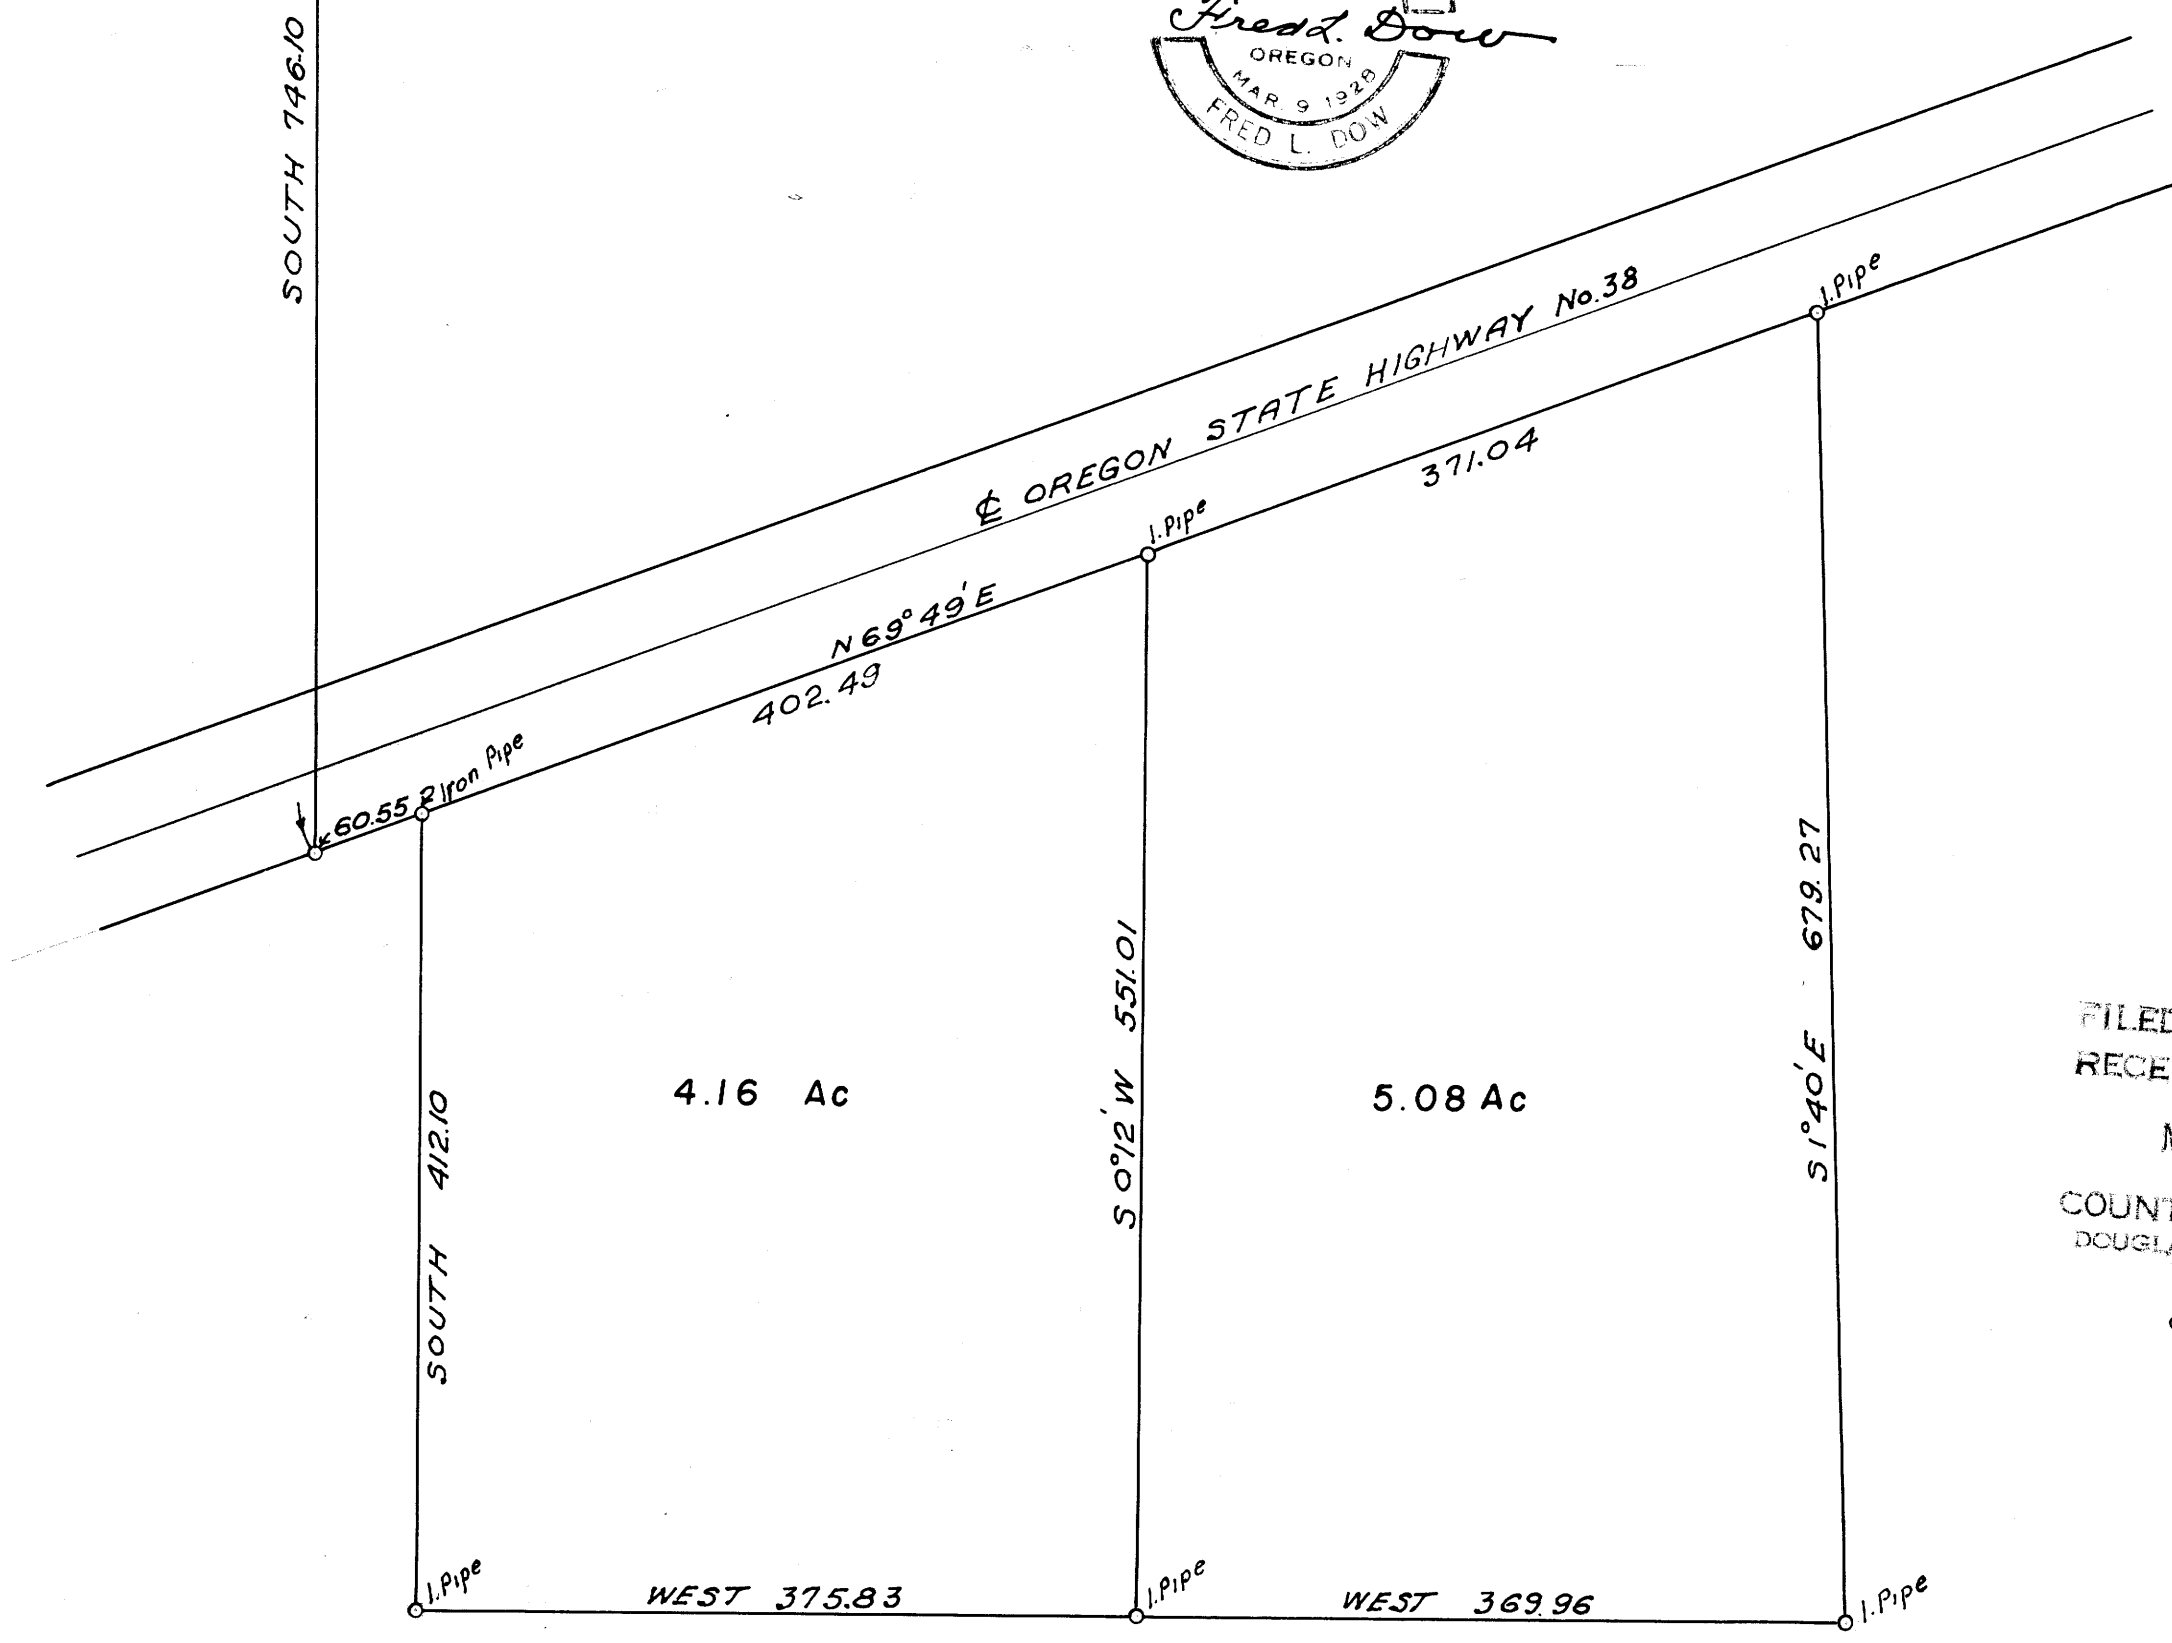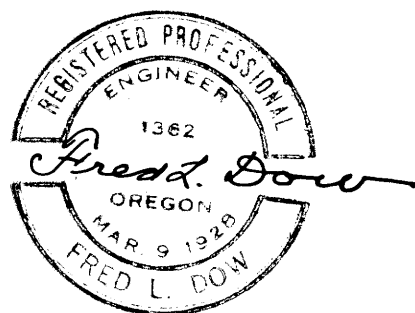

FILED  
RECEIVED  
MAR 25 1957  
COUNTY SURVEYOR  
DOUGLAS COUNTY, ORE.  
*FMD*