

A. C. Smith July 1956
MAP FILE M5 127
CS 47/98

SECTION 10, T.32S., R.5W.

COUNTY SURVEYORS FILE DATA
DO NOT REMOVE FROM OFFICE


FILED
RECEIVED

JUN 5 1957

COUNTY SURVEYOR
DOUGLAS COUNTY, ORE.

THIS COPY MADE FROM
A XEROX 2510

DATE 2-16-89

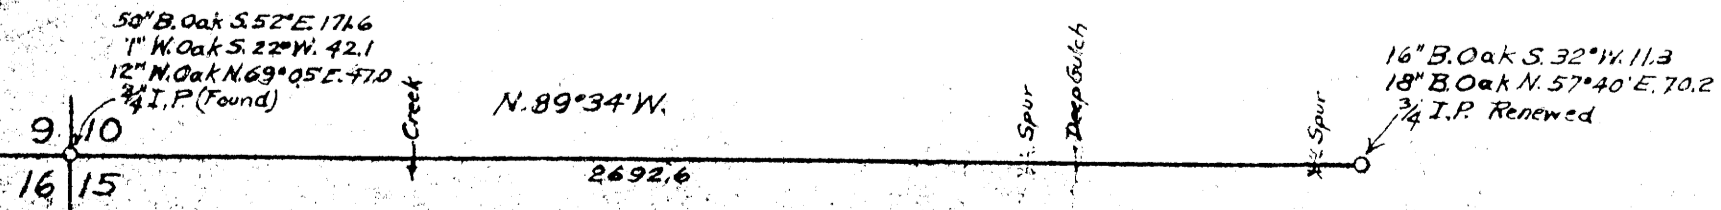

MAP FILE M5 127
C. S. File No. 47/98