


98-54
1/60 3712 5'2



NOTE:
BASE OF BEARING N62°03'W
ALONG E OF OAK STREET. SEE
C.S. FILE 39/124

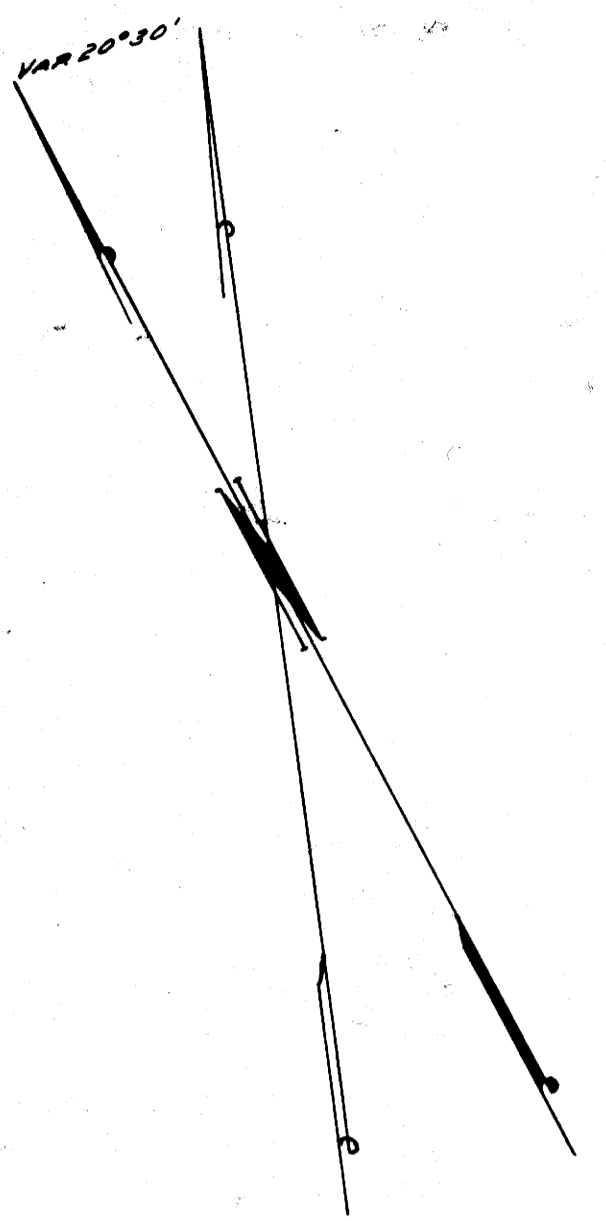

COUNTY SURVEYOR'S OFFICE
DOUGLAS COUNTY, OREGON

SURVEY OF LOT 8, BLOCK 29
ROSEBURG OREGON

FRED M. DARBY COUNTY SURVEYOR
SURVEYED JULY 30, 1957 BY
JAMES W. BYRON - DEPUTY SCALE 1" = 50'
SURVEYED FOR FRED LOCKWOOD

REGISTERED
JULY 30 1957
JAMES W. BYRON
DEPUTY SURVEYOR
303

COUNTY SURVEYORS FILE
DO NOT REMOVE FROM OFFICE

CS FILE FOLDER

CONTAINS

MORE

INFORMATION