


COUNTY SURVEYORS FILE DATA  
DO NOT REMOVE FROM OFFICE

MAP FILE MS 16


HENRY R. COOK  
SUTHERLIN OREGON  
SECTION 20, T. 25 S. R. 5 W.

SCALE 1" = 50'

MAY 1954

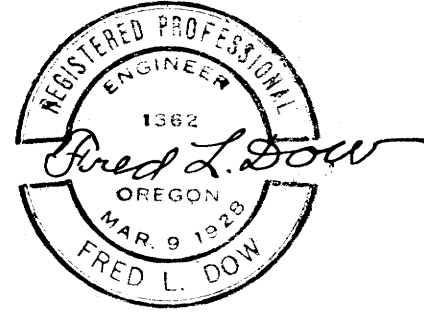

NOTE:-  
Townsite of Sutherlin bearings  
used on this survey

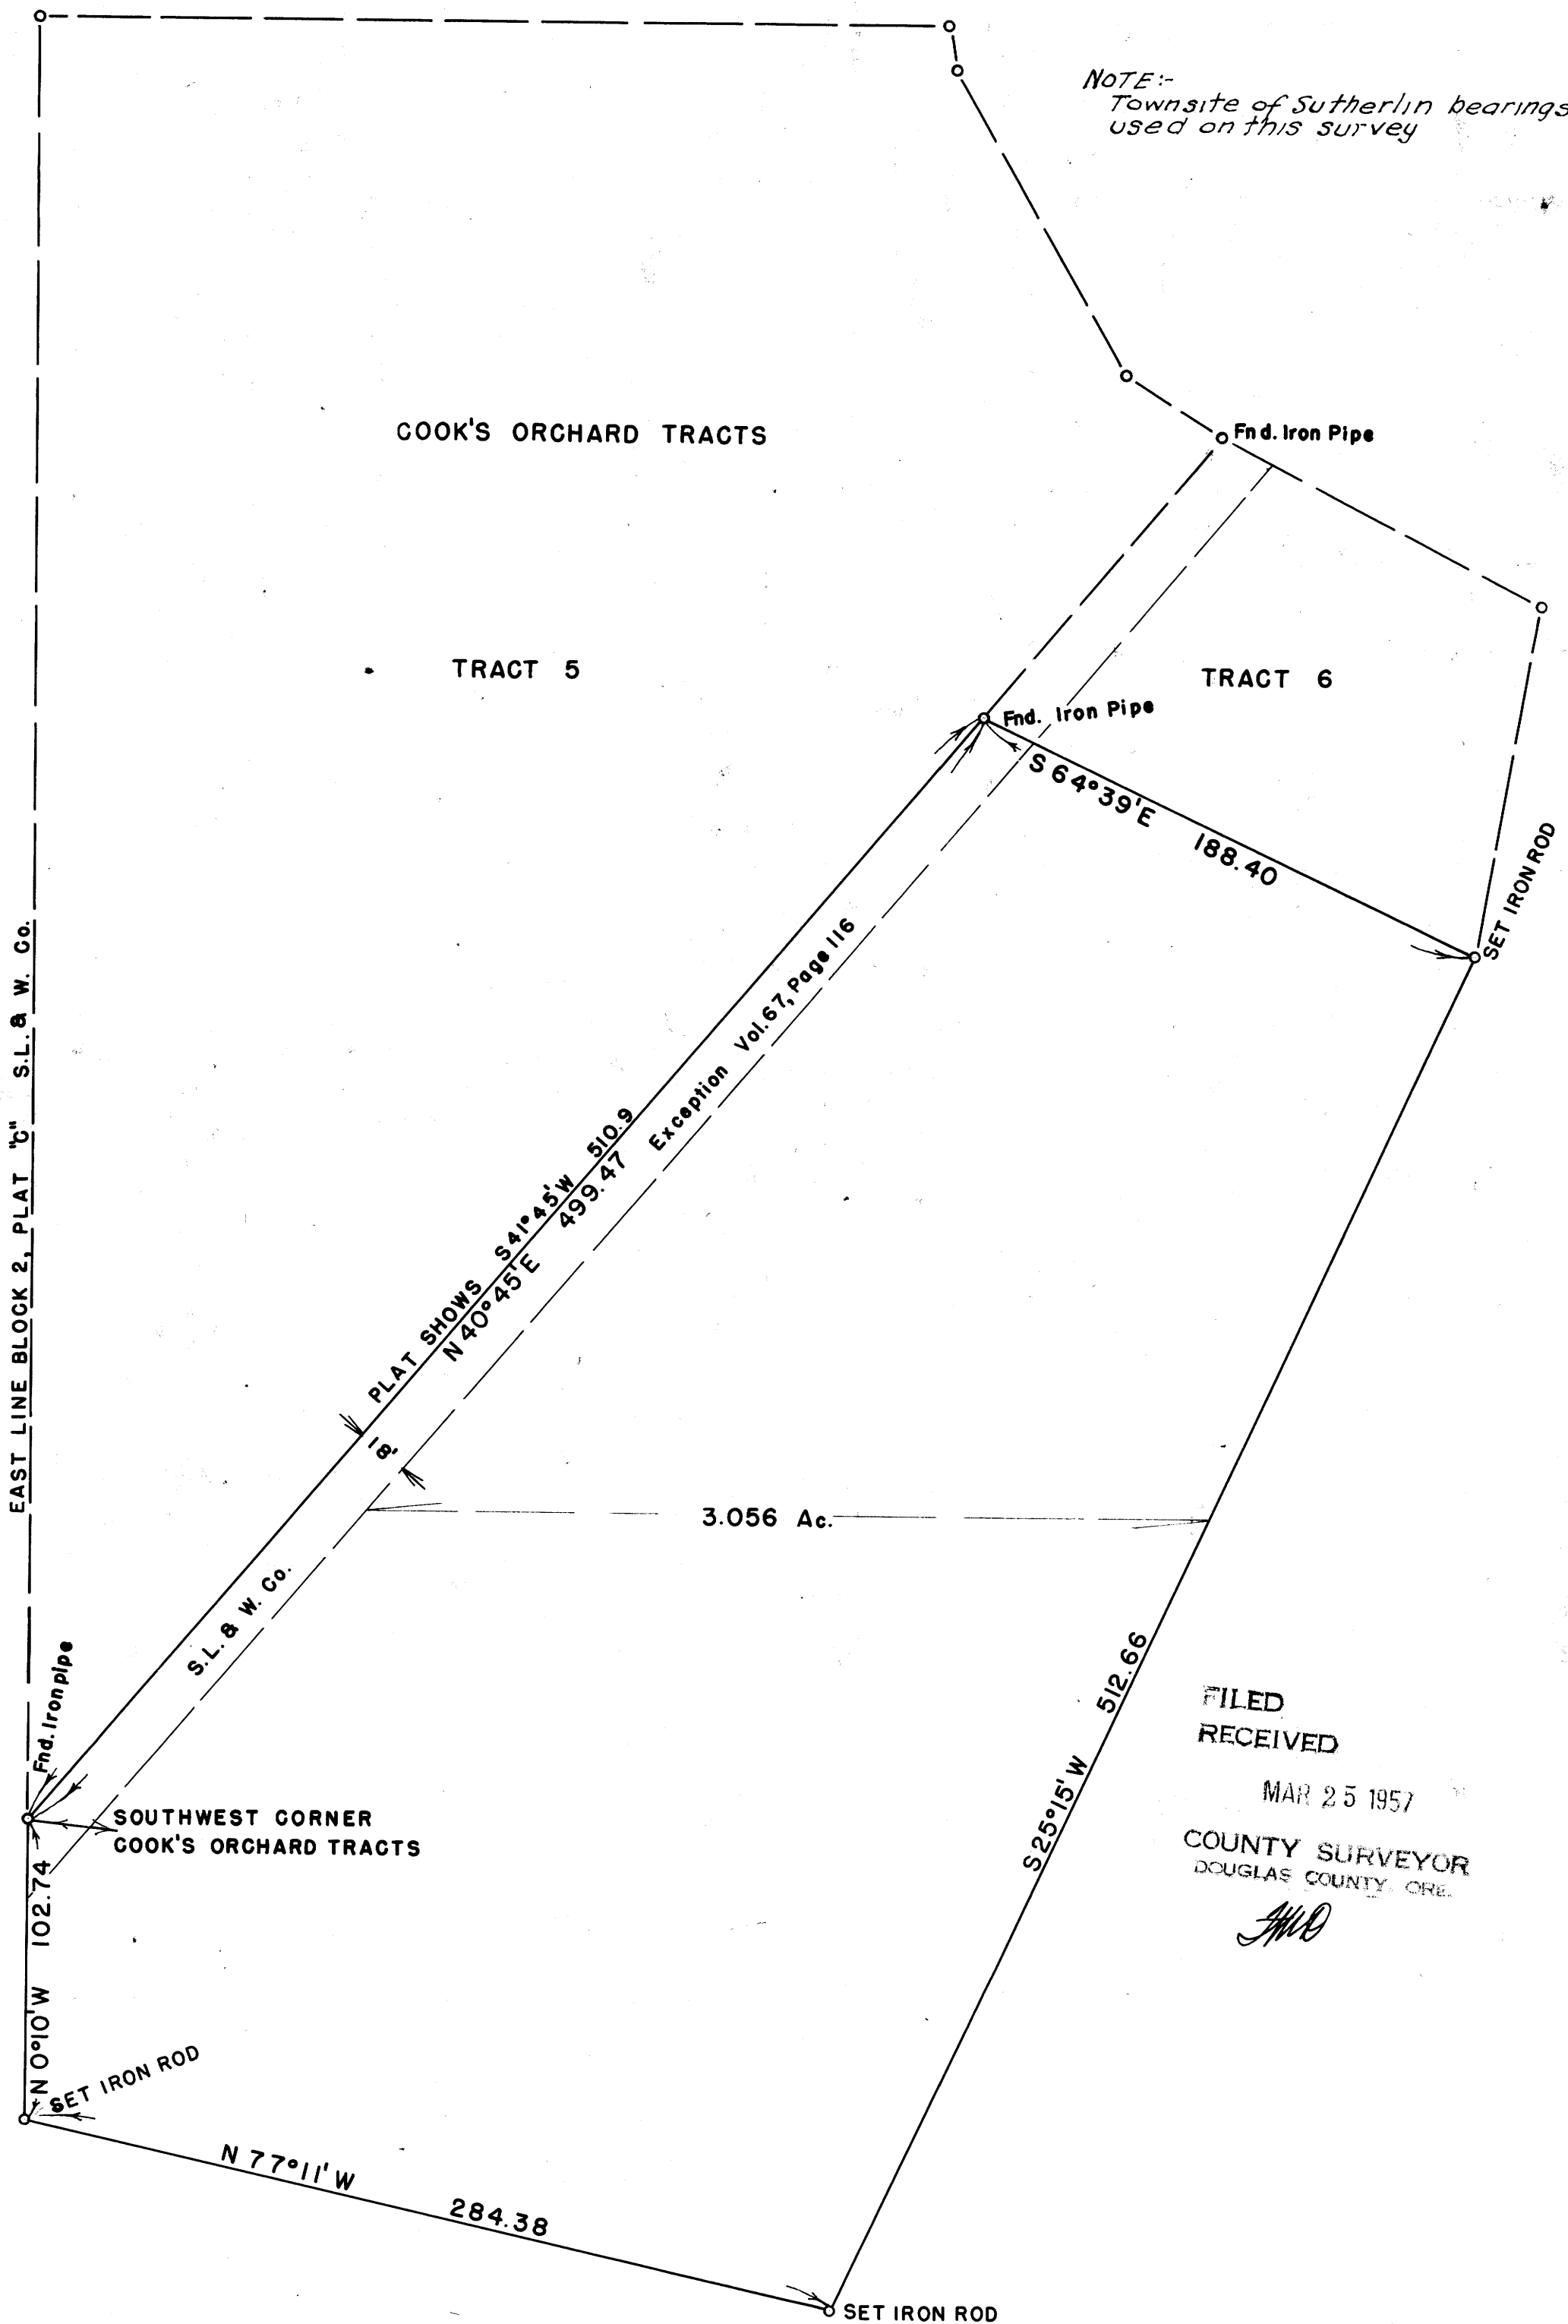

FILED  
RECEIVED  
MAR 25 1957  
COUNTY SURVEYOR  
DOUGLAS COUNTY, ORE.  
MD

MAP FILE MS 16