


M 5 - 70
VOL. 3 P. 125
FILE # 5/25
MAP FILE M 5 - 70

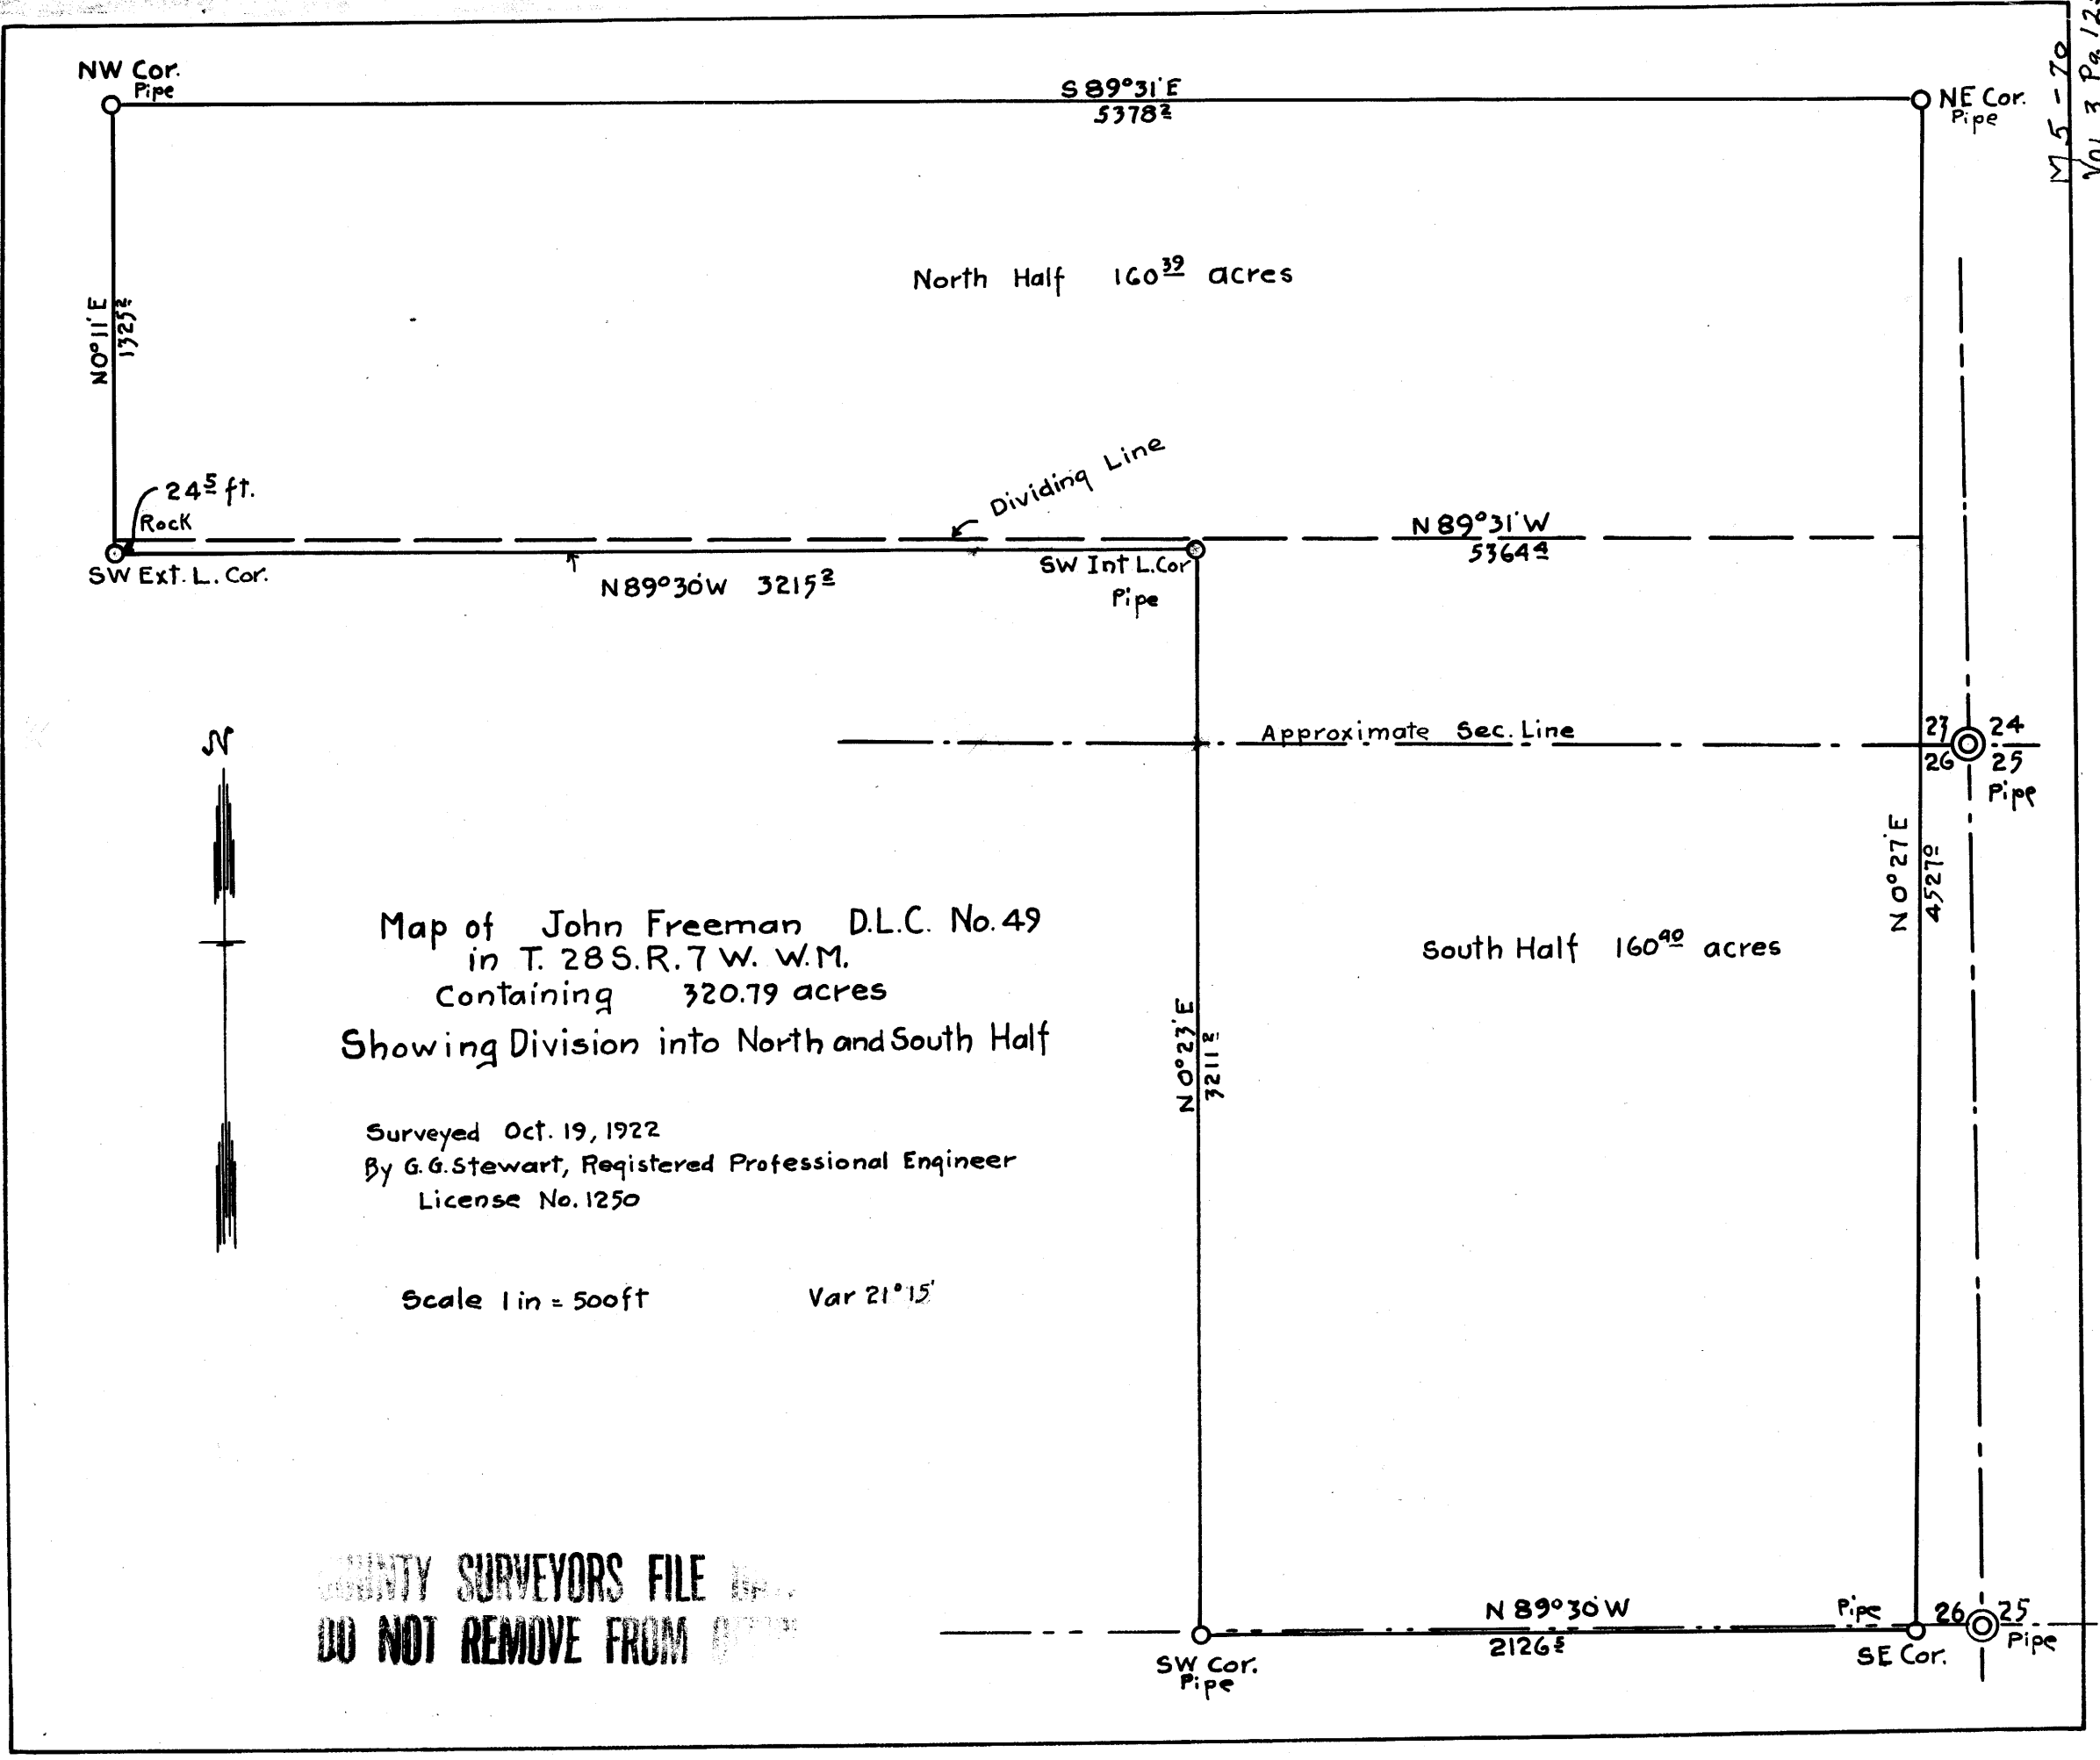

NW Cor. Pipe

S 89° 31' E
5378.2

NE Cor. Pipe

North Half 160.32 acres

N 0° 11' E
1323.2

24 1/2 ft.
Rock

Dividing Line

N 89° 31' W
5364.4

SW Ext. L. Cor.

N 89° 30' W 3215.2

SW Int L. Cor. Pipe

Approximate Sec. Line

27
26
24
25
Pipe

Map of John Freeman D.L.C. No. 49
in T. 28 S. R. 7 W. W.M.
Containing 320.79 acres
Showing Division into North and South Half

South Half 160.90 acres

N 0° 27' E
4527.0

Surveyed Oct. 19, 1922
By G. G. Stewart, Registered Professional Engineer
License No. 1250

N 0° 23' E
3211.2

Scale 1 in = 500 ft Var 21° 15'

COUNTY SURVEYORS FILE
DO NOT REMOVE FROM OFFICE

SW Cor. Pipe

N 89° 30' W
2126.2

Pipe
SE Cor.

26
25
Pipe

MAP FILE M 5 - 70