


42-9W

4504



T. 24 S. R. 2 W.

T. 24 S. R. 3 W.

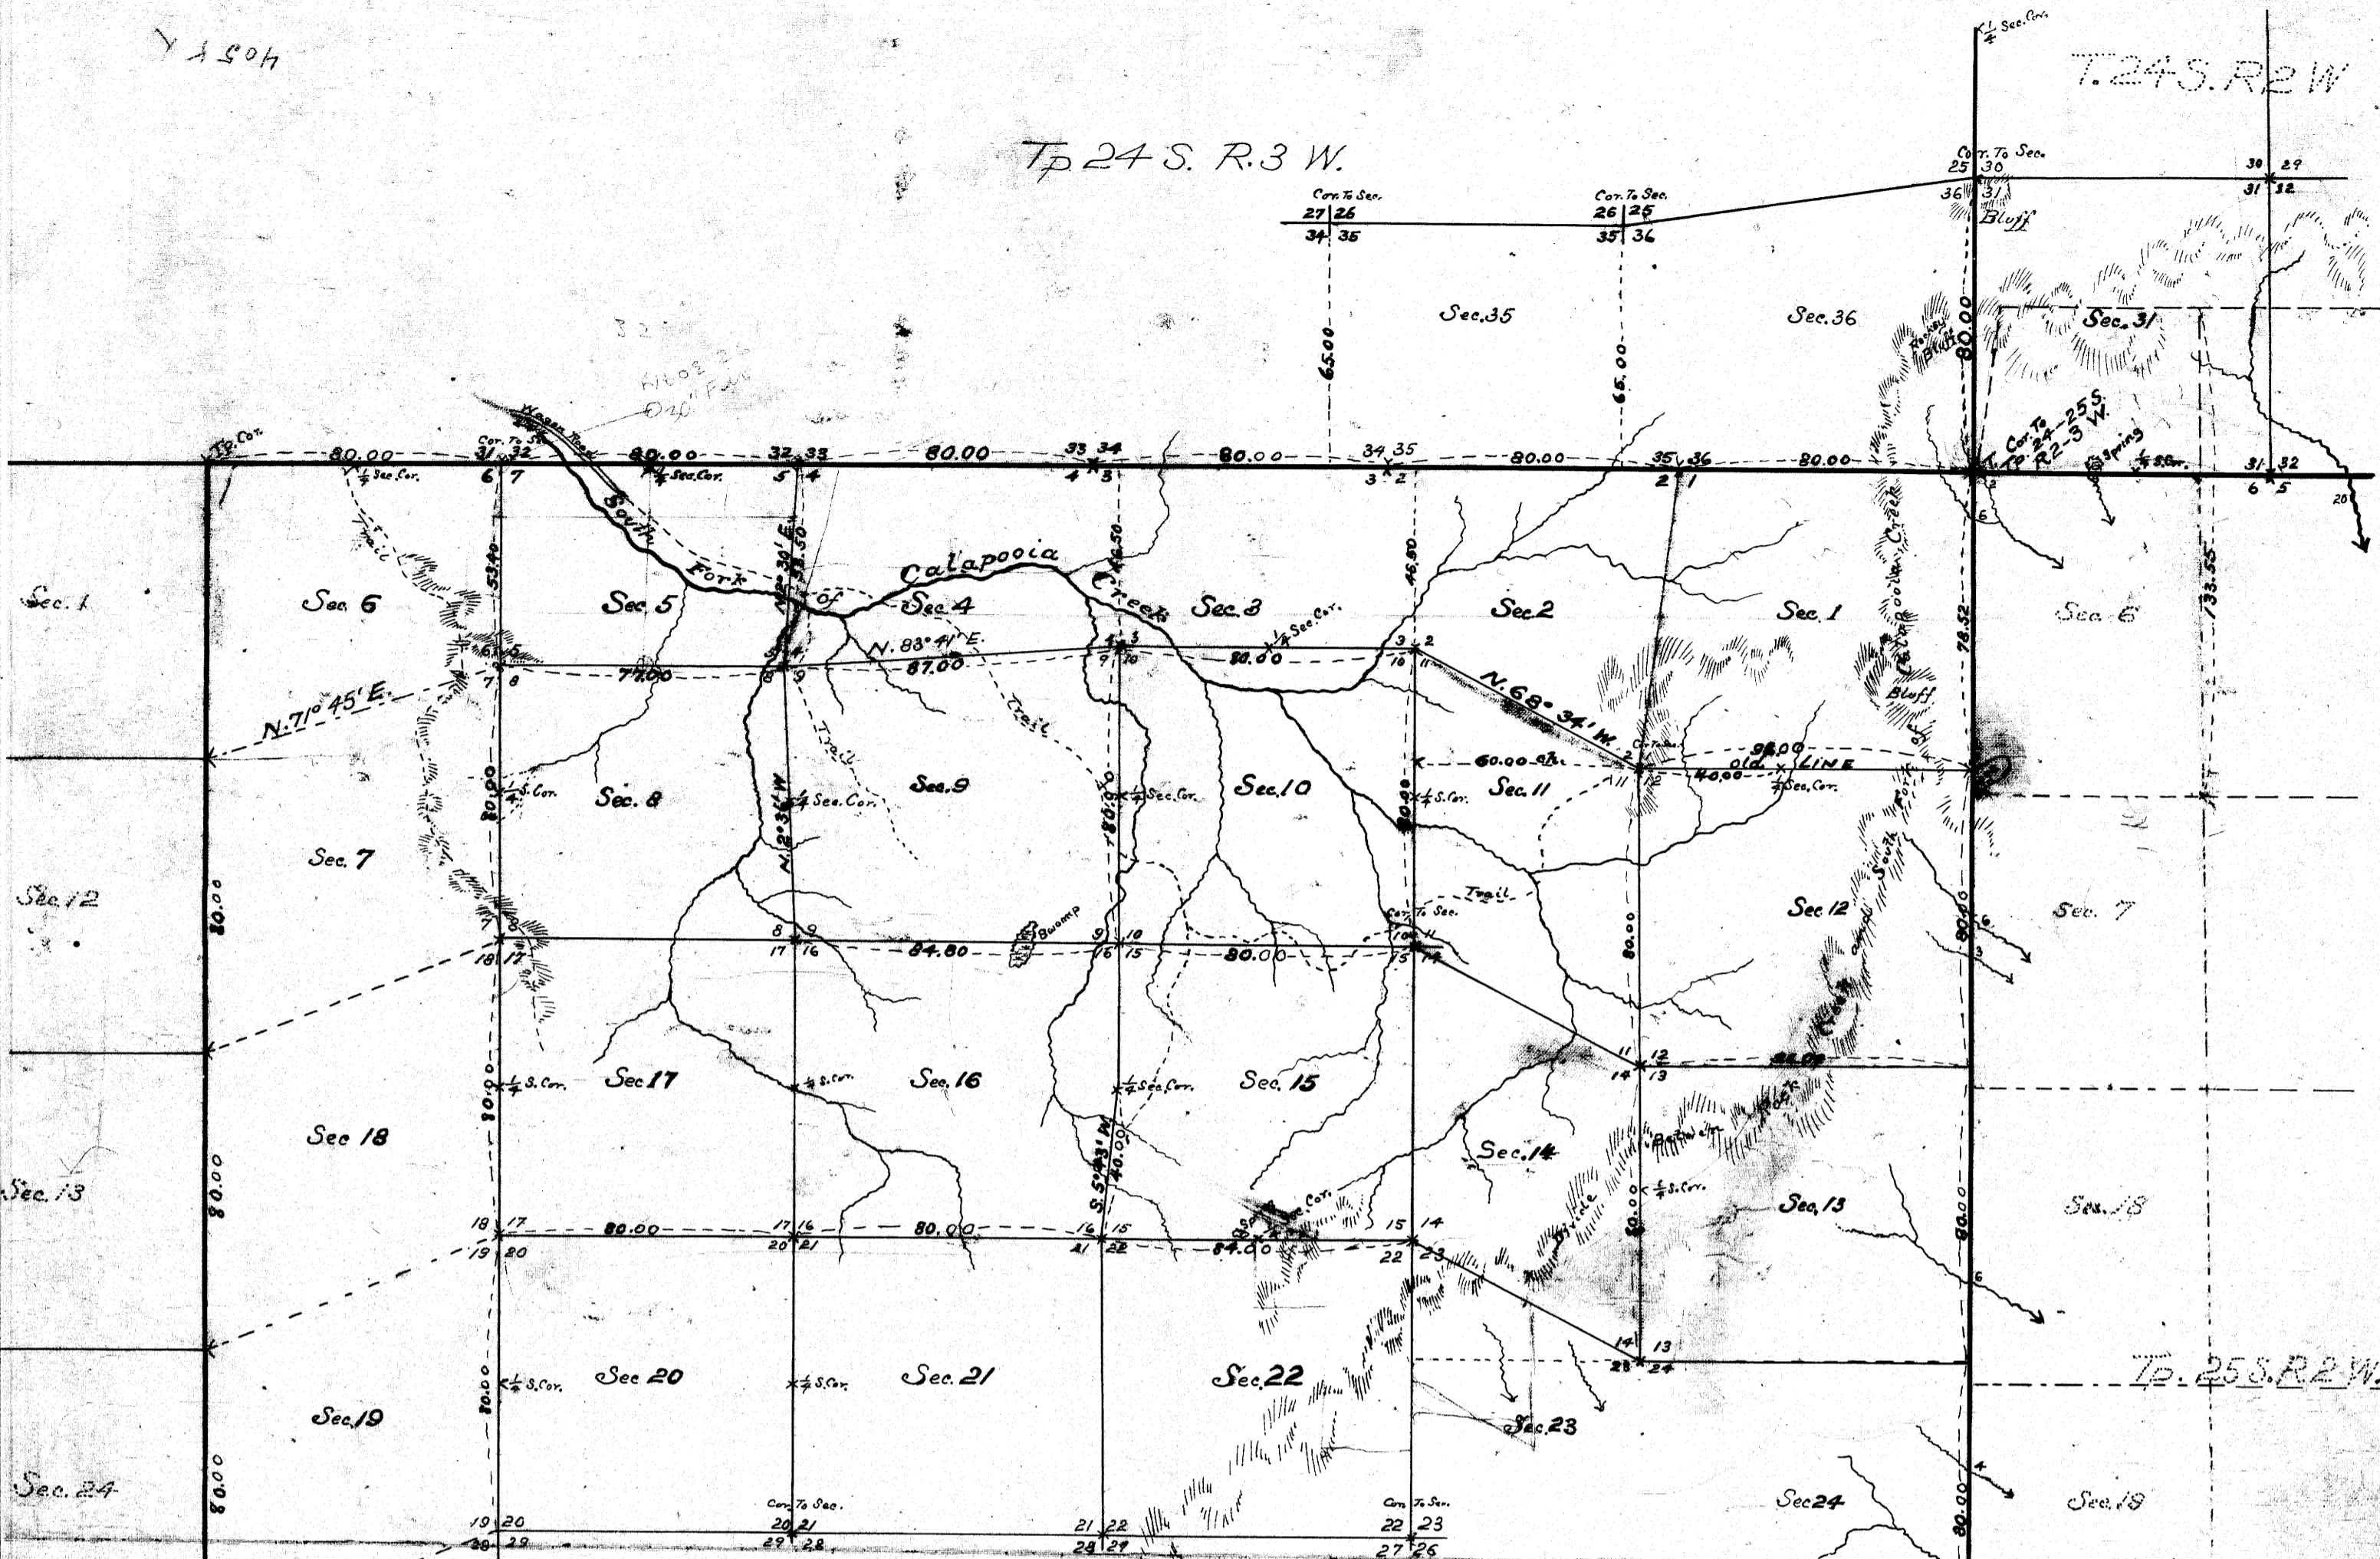

T. 25 S. R. 2 W.

T. 25 S. R. 3 W. (N.M.)

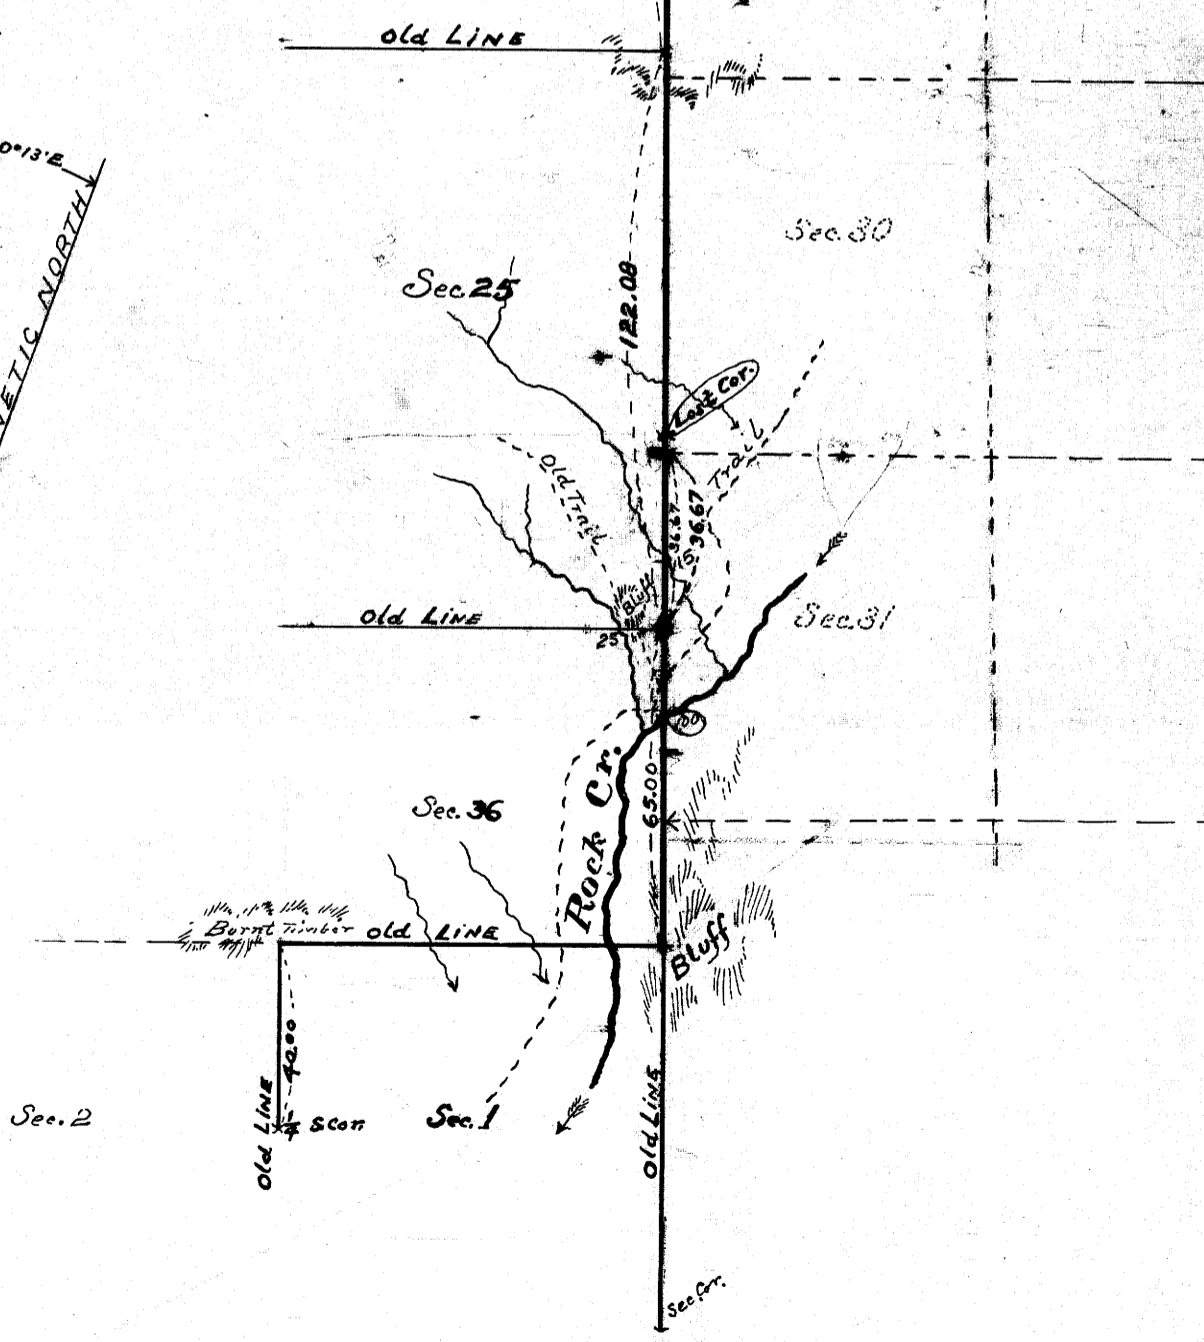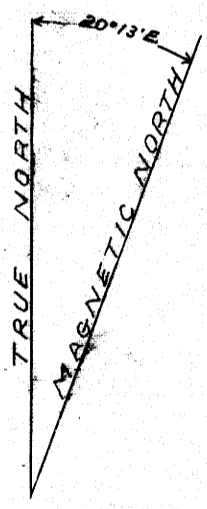

40131

Oscar Edwards
 Co. Surveyor (1906-08)
 Roseburg Ore.

COUNTY SURVEYORS FILE DATA
 DO NOT REMOVE FROM OFFICE

M6-24