


L-9 W
05/14/38

COUNTY SURVEYORS FILE DATA
DO NOT REMOVE FROM OFFICE

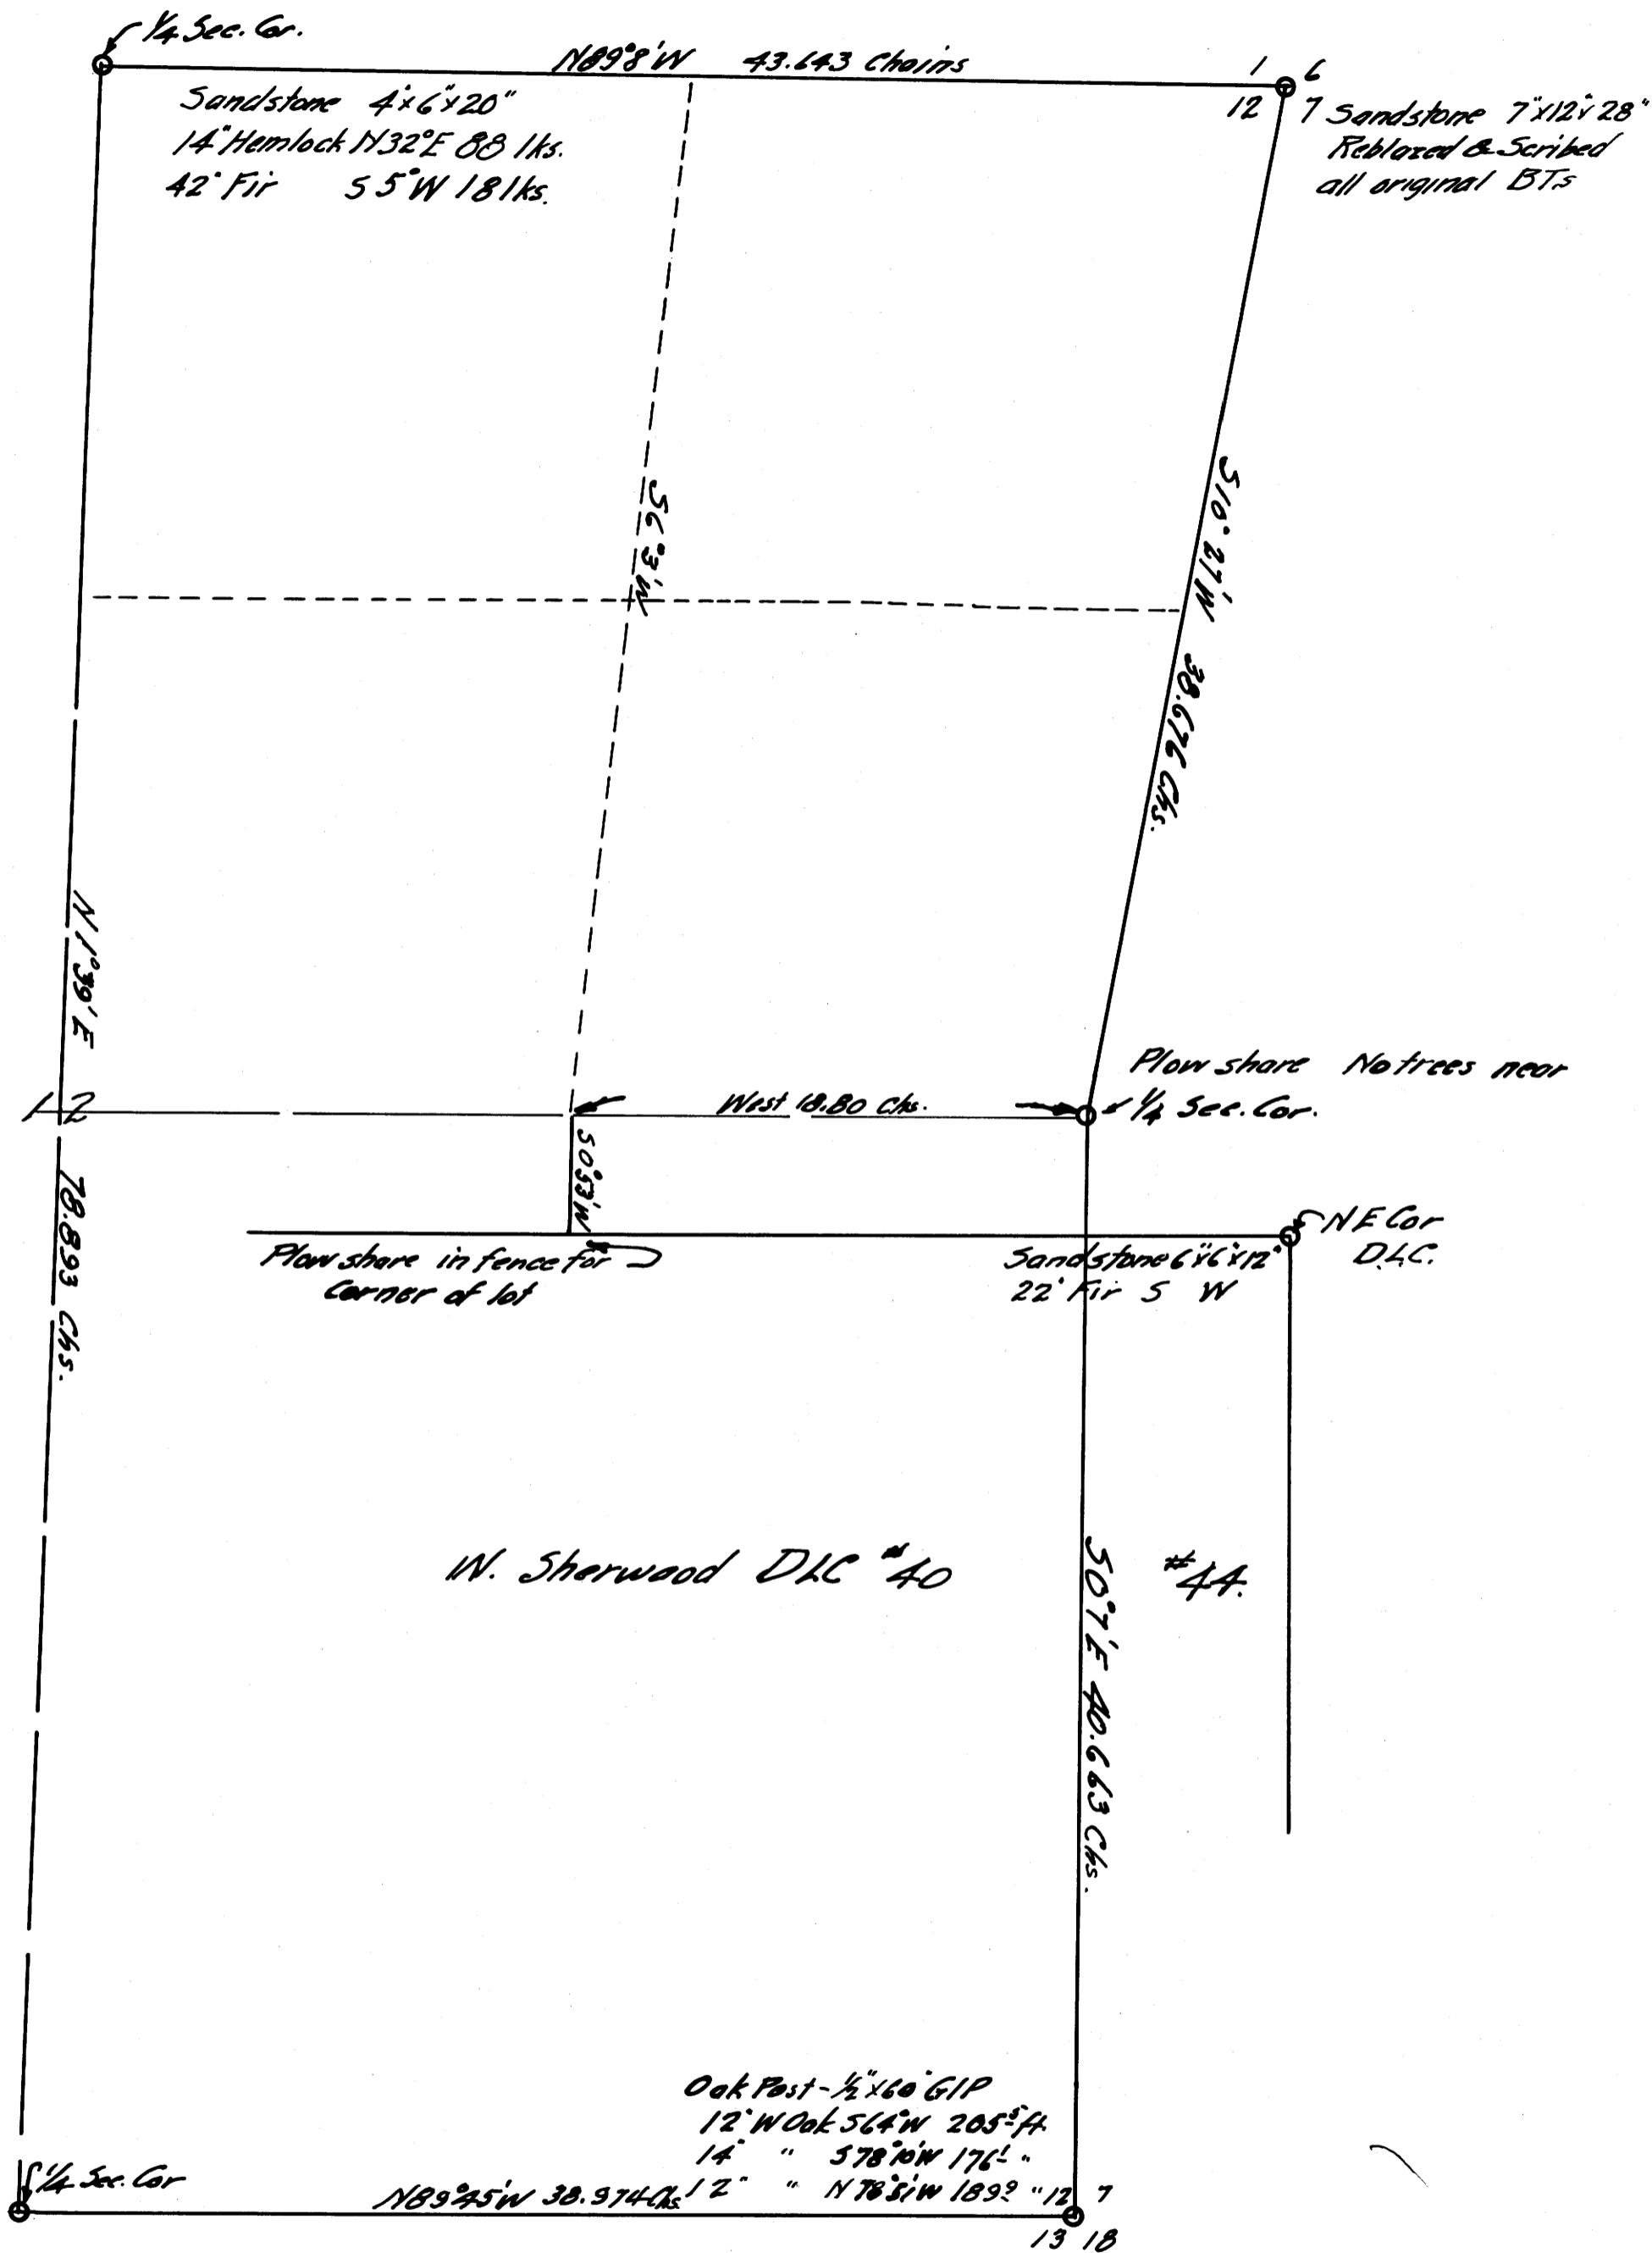

EAST HALF OF
SECTION 12 T225 R 8 W
as surveyed by
BEN. B. IRVING DEPUTY COUNTY SURVEYOR
November and December 1929

SCALE 1 inch = 6 chains

Drawer 55

Vol 4 Pg 4
C.B. FILE 14/38
M 6-7