


COUNTY SURVEYOR'S OFFICE
 DOUGLAS COUNTY OREGON
 SURVEY ^{Sec 24 T 27 S R 6} FOR DEED DESCRIPTION
 BLOCK I, HAMILTON ADD.
 ROSEBURG OREGON
 SURVEYED FOR ROY O. YOUNG, JUNE 29, 1954

BEN B. IRVING COUNTY SURVEYOR
 JAMES W. BYRON DEPUTY

SCALE: 1" = 20'

REGISTERED
 OREGON
 LAND SURVEYOR
James W. Byron
 NOV. 6, 1953
 JAMES W. BYRON
 303

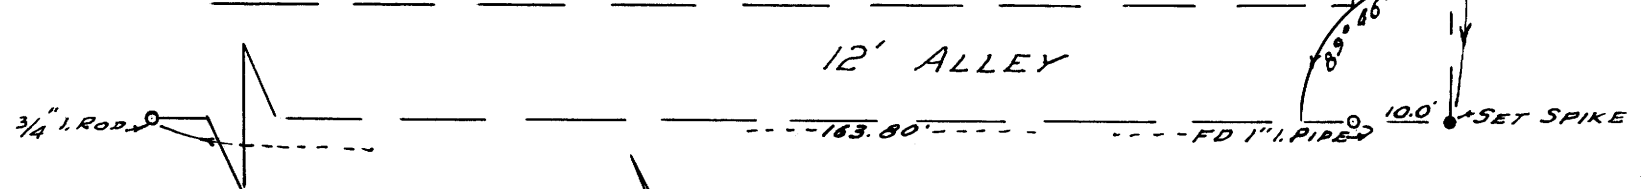

NOTE: BASES OF BEARING S27°09' W
 ALONG THE CENTER LINE OF
 FLINT STREET.

COUNTY SURVEYORS FILE DATA
 DO NOT REMOVE FROM OFFICE