


FOR BALANCE OF BEARING & COORDINATES  
SEE C.S. FILE 47/200

COUNTY SURVEYOR'S OFFICE  
DOUGLAS COUNTY, OREGON

SURVEY TO SET 1/4 CORNER COMM.  
SECTION 24 & 25 T27S, R6W., W.M.

FRED M. DARBY COUNTY SURVEYOR  
SURVEYED JAN 3, 1958 BY  
JAMES W. BYRON - DEPUTY SCALE 1" = 400'  
SURVEYED FOR DOUGLAS COUNTY

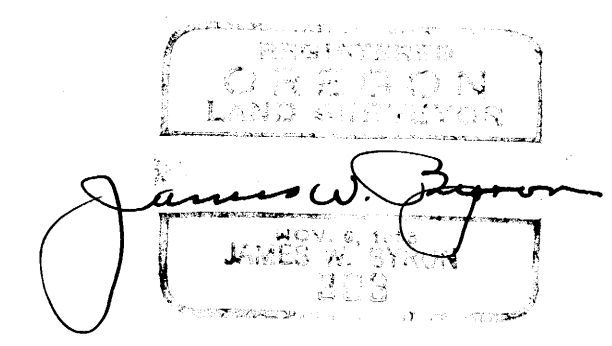

COUNTY SURVEYOR'S FILE NO.  
DO NOT REMOVE FROM OFFICE

CS FILE FOLDER

CONTAINS

MORE

INFORMATION