


Survey for Deed Description
Sect. 13, T.22 S., R.6 W. W.M. Lot. 2
Scale 1" = 100'
Jan. 1958

SEE Vol. 3, Page 285 County Surveyor's Record for Proposition N.T.S.E.

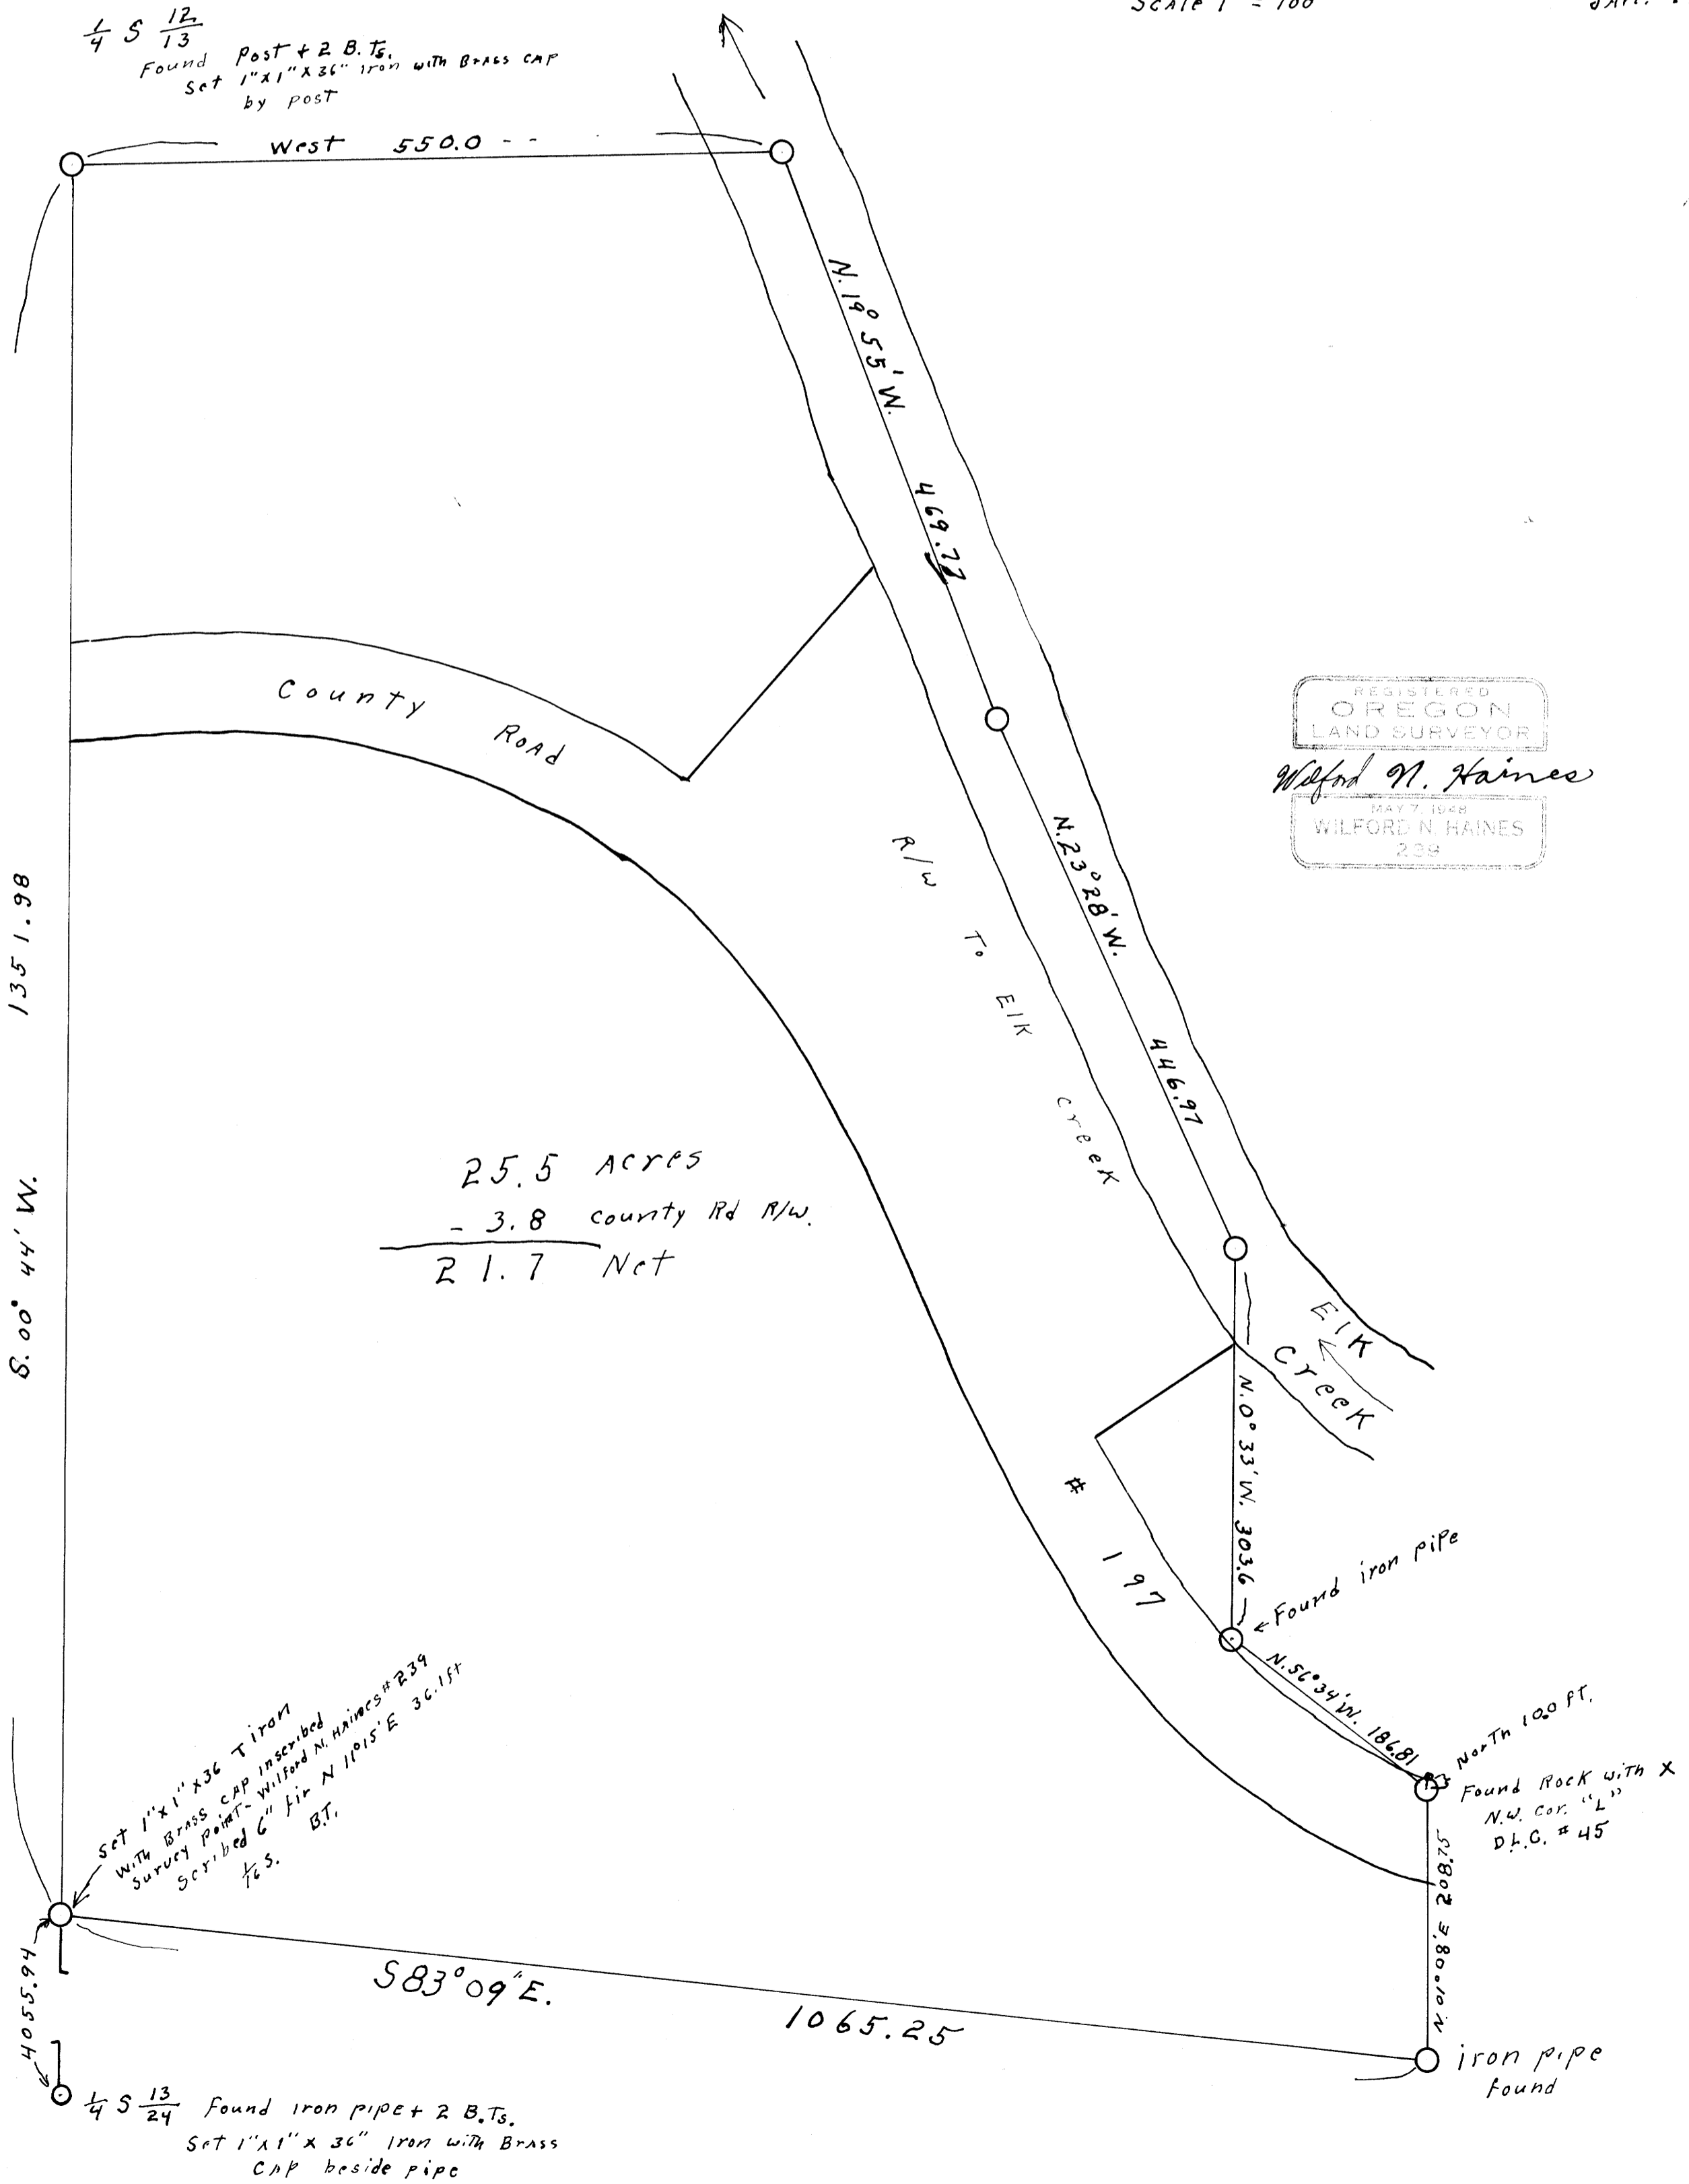

FILED
RECEIVED

JAN 27 1958

COUNTY SURVEYOR
DEUELAS COUNTY, ORE