


JAMES G. CLARK D.L.C. No. 51

JOSEPH ROBERTS D.L.C. No. 59

JACKSON REYNOLDS D.L.C. No. 58

JOHN FREDERICK HAYS
VOL. 106, PAGE 432
DEED RECORDS

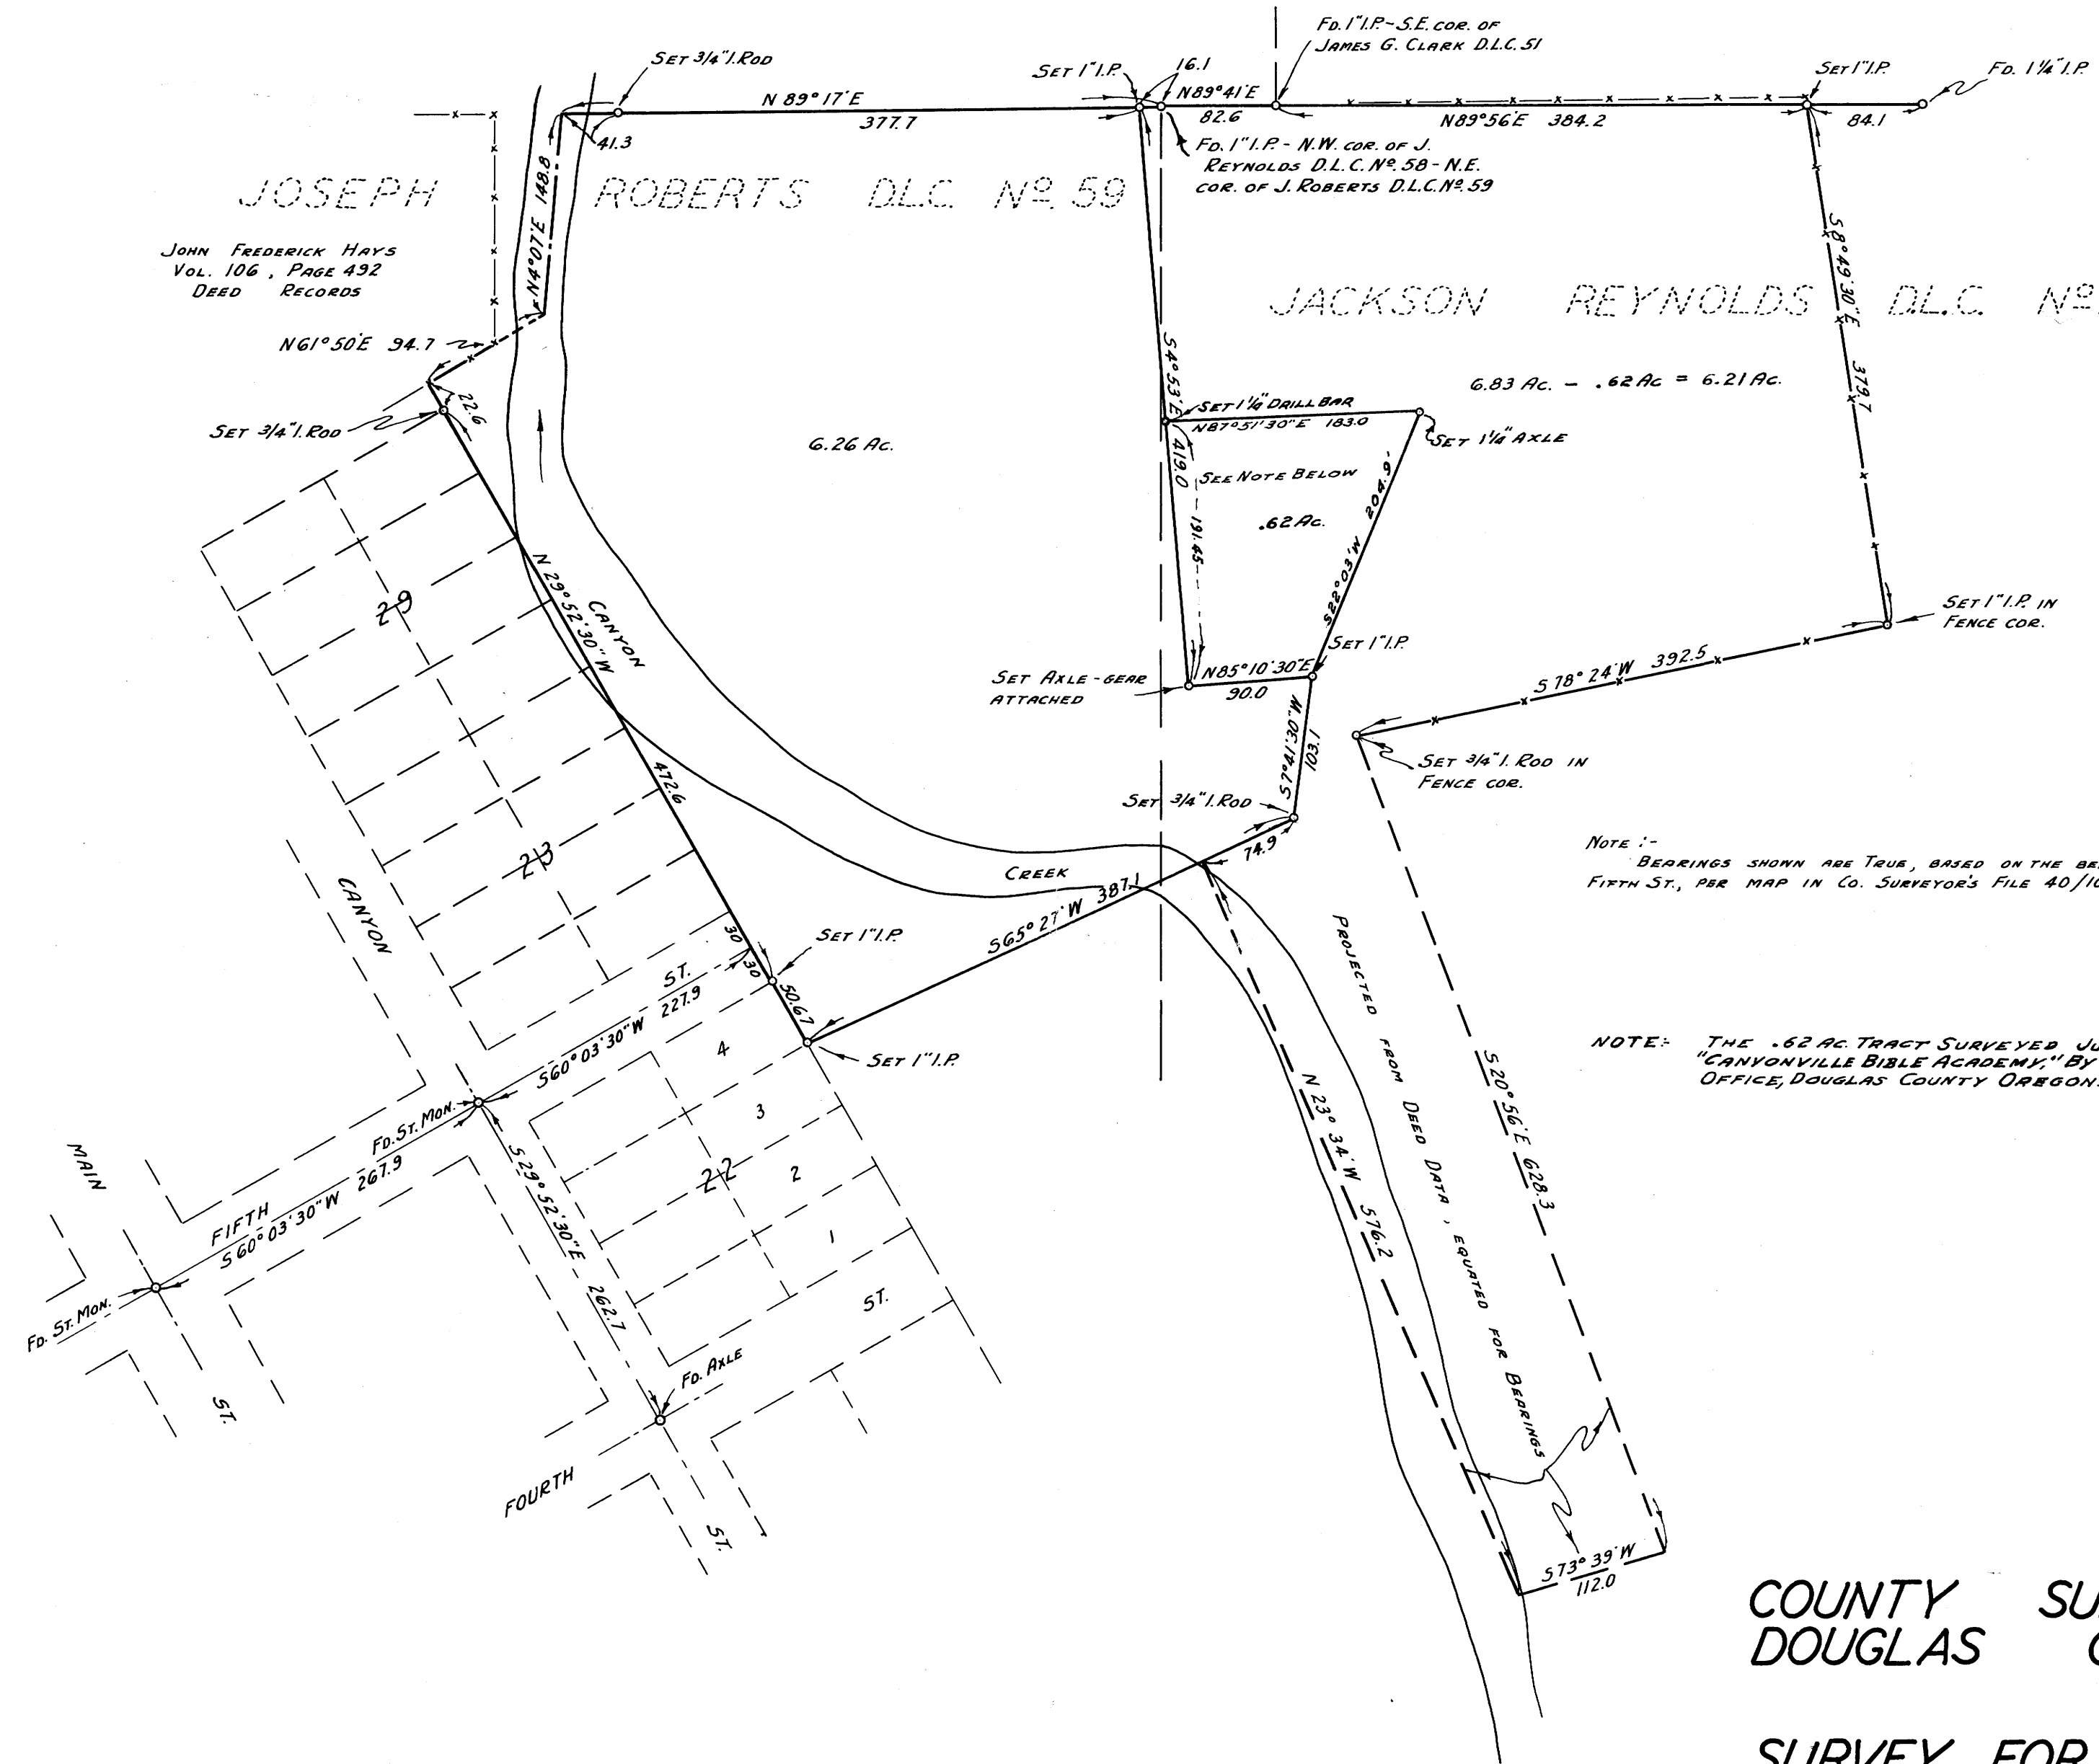

NOTE: - BEARINGS SHOWN ARE TRUE, BASED ON THE BEARING SHOWN ON THE S. OF FIFTH ST., PER MAP IN CO. SURVEYOR'S FILE 40/104.


NOTE: THE .62 AC. TRACT SURVEYED JULY 30, 1954 FOR "CANYONVILLE BIBLE ACADEMY," BY THE COUNTY SURVEYOR'S OFFICE, DOUGLAS COUNTY OREGON.

COUNTY SURVEYOR'S OFFICE
DOUGLAS COUNTY, OREGON

SURVEY FOR DEED DESCRIPTIONS, IN D.L.C. No. 58, 59, SEC. 27, T30S, R5W.W.M.

Ben B. Irving

BEN B. IRVING COUNTY SURVEYOR
SURVEYED DEC., 1952. SCALE 1" = 100'
ALSO SEE SURVEY DATED JULY 30, 1954
SURVEY MADE FOR CANYONVILLE BIBLE ACDMY.

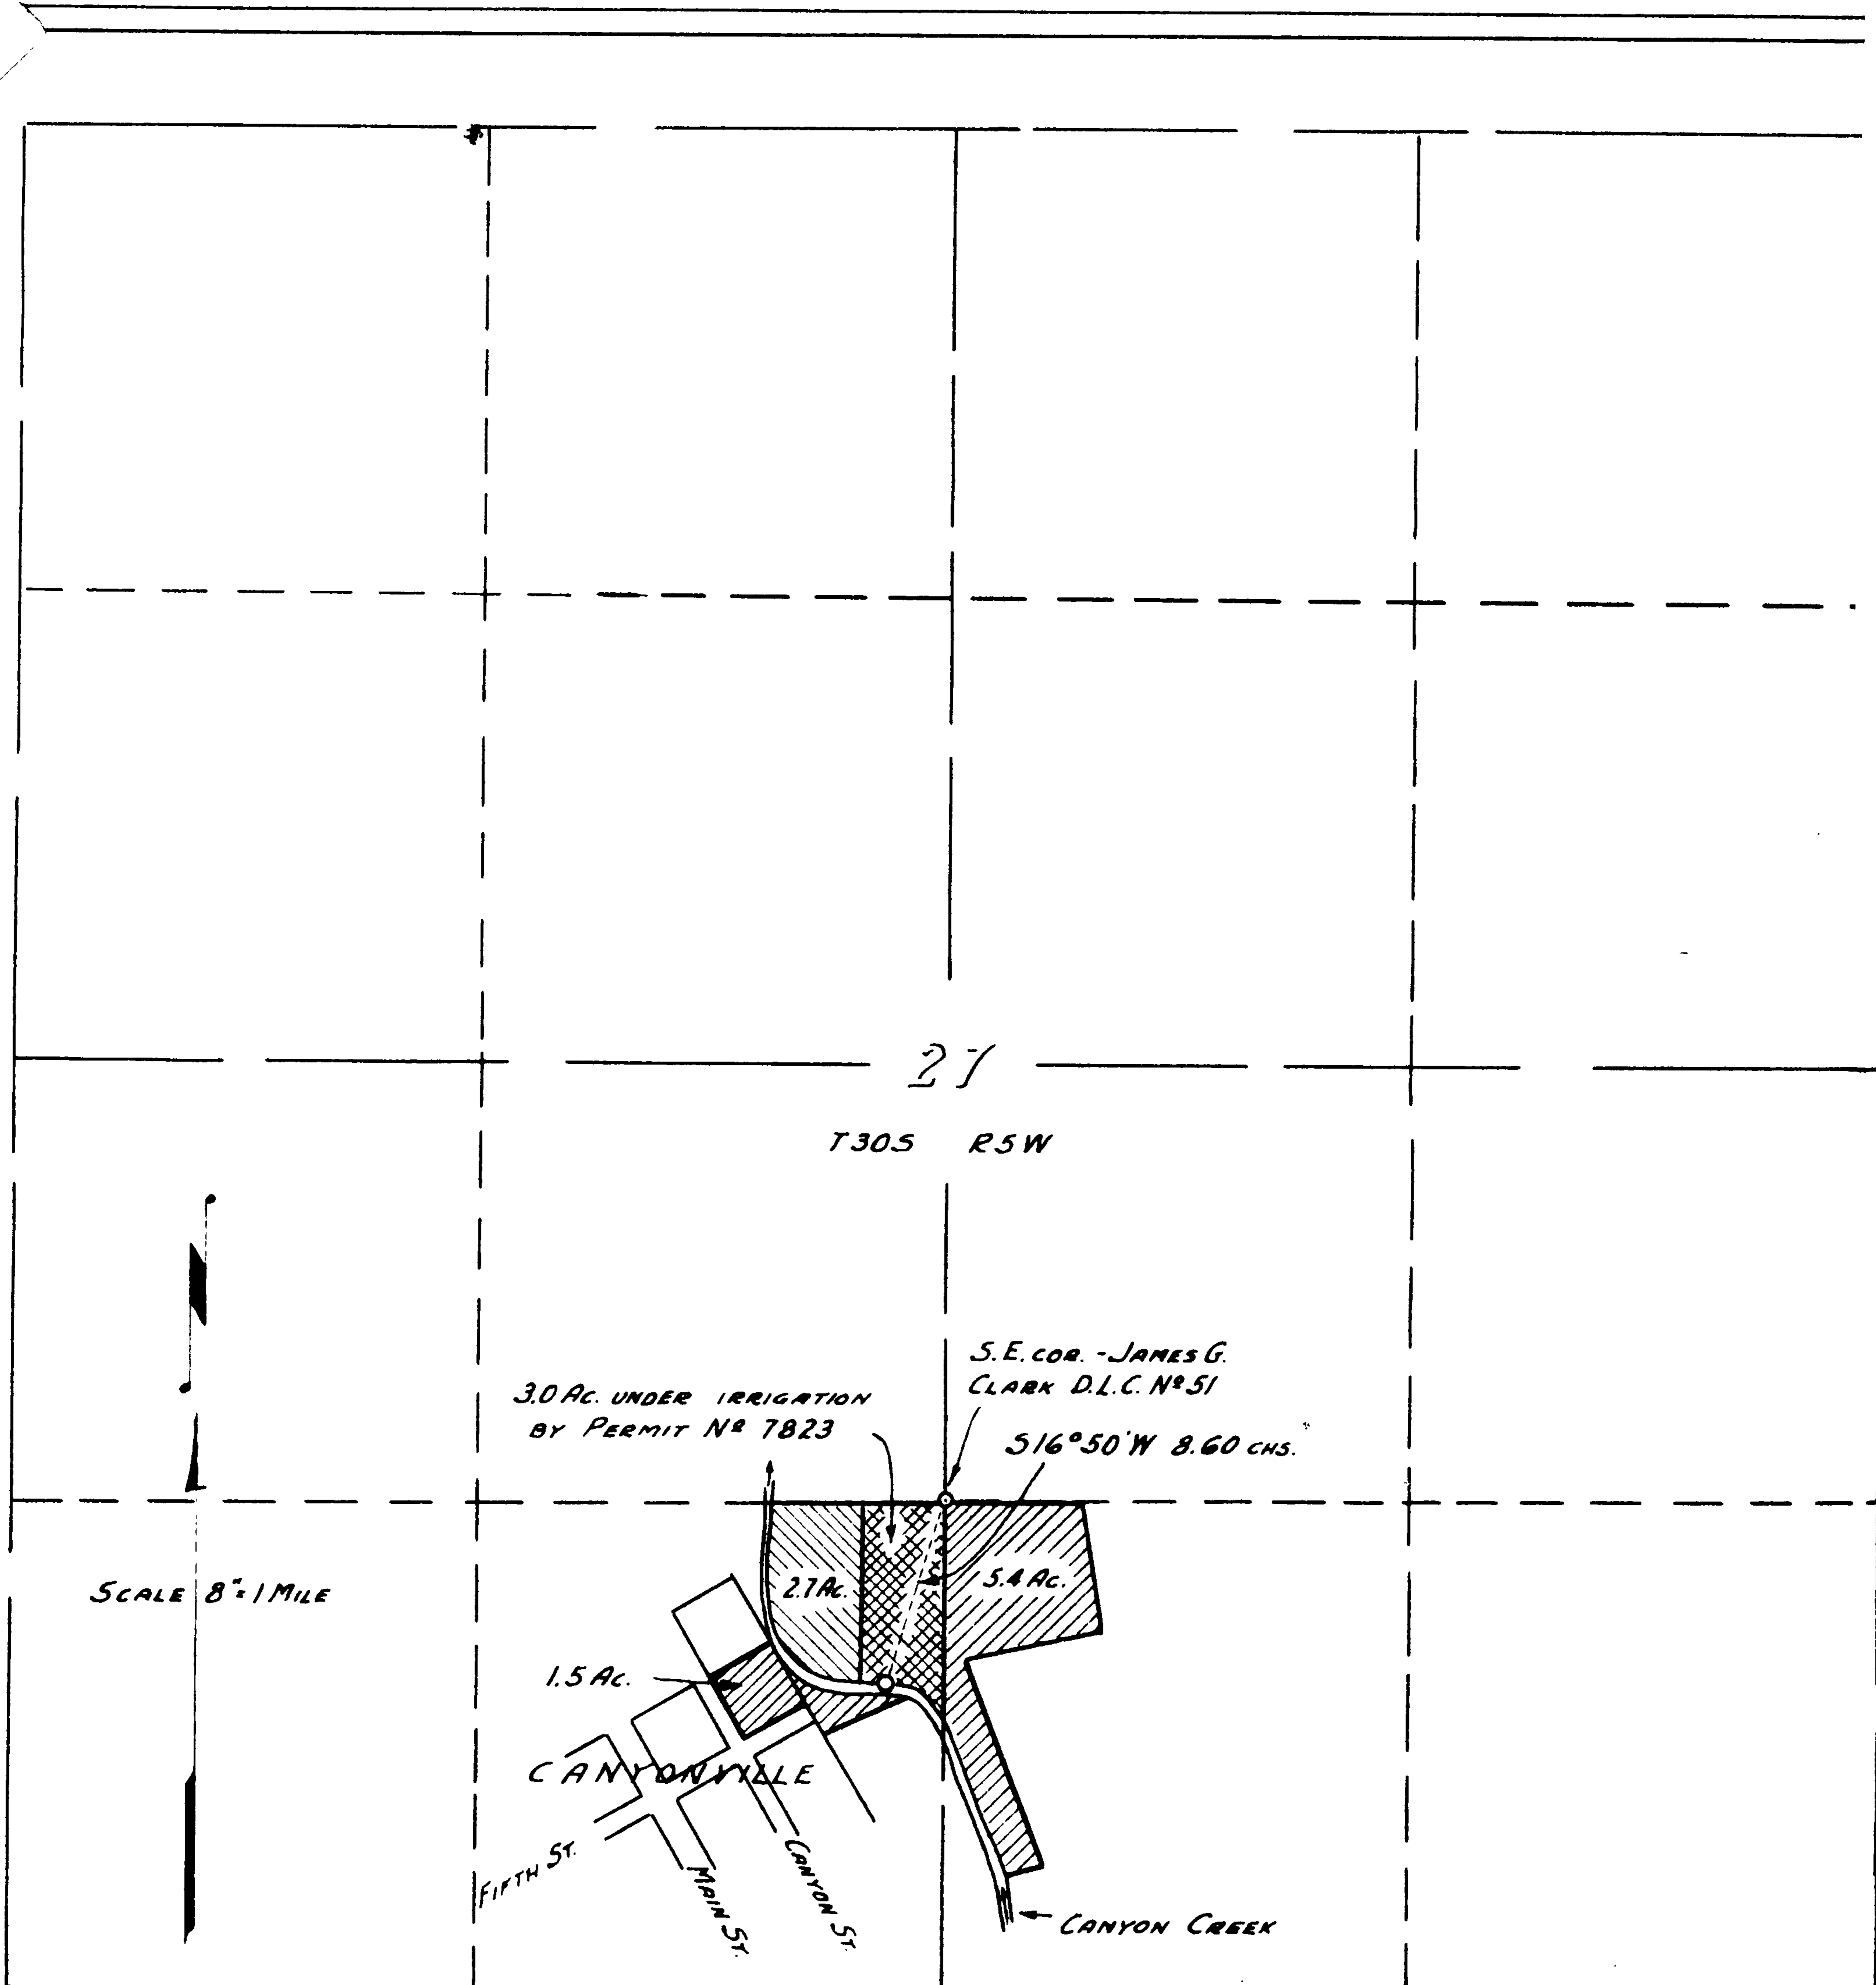

NOTE:-
 THIS MAP PREPARED FROM SURVEY BY THIS OFFICE,
 AND DATA SHOWN ON MAP OF PERMIT NO. 7823, FURNISHED
 BY THE APPLICANT.



SUPPLEMENTAL
 WATER RIGHT
 FOR
 CANYONVILLE BIBLE ACADEMY
 SECTION 27. T30S R5W W.M

OFFICE OF
 BEN. B. IRVING
 COUNTY SURVEYOR DOUGLAS COUNTY
 ROSEBURG OREGON

CS FILE FOLDER

CONTAINS

MORE

INFORMATION