
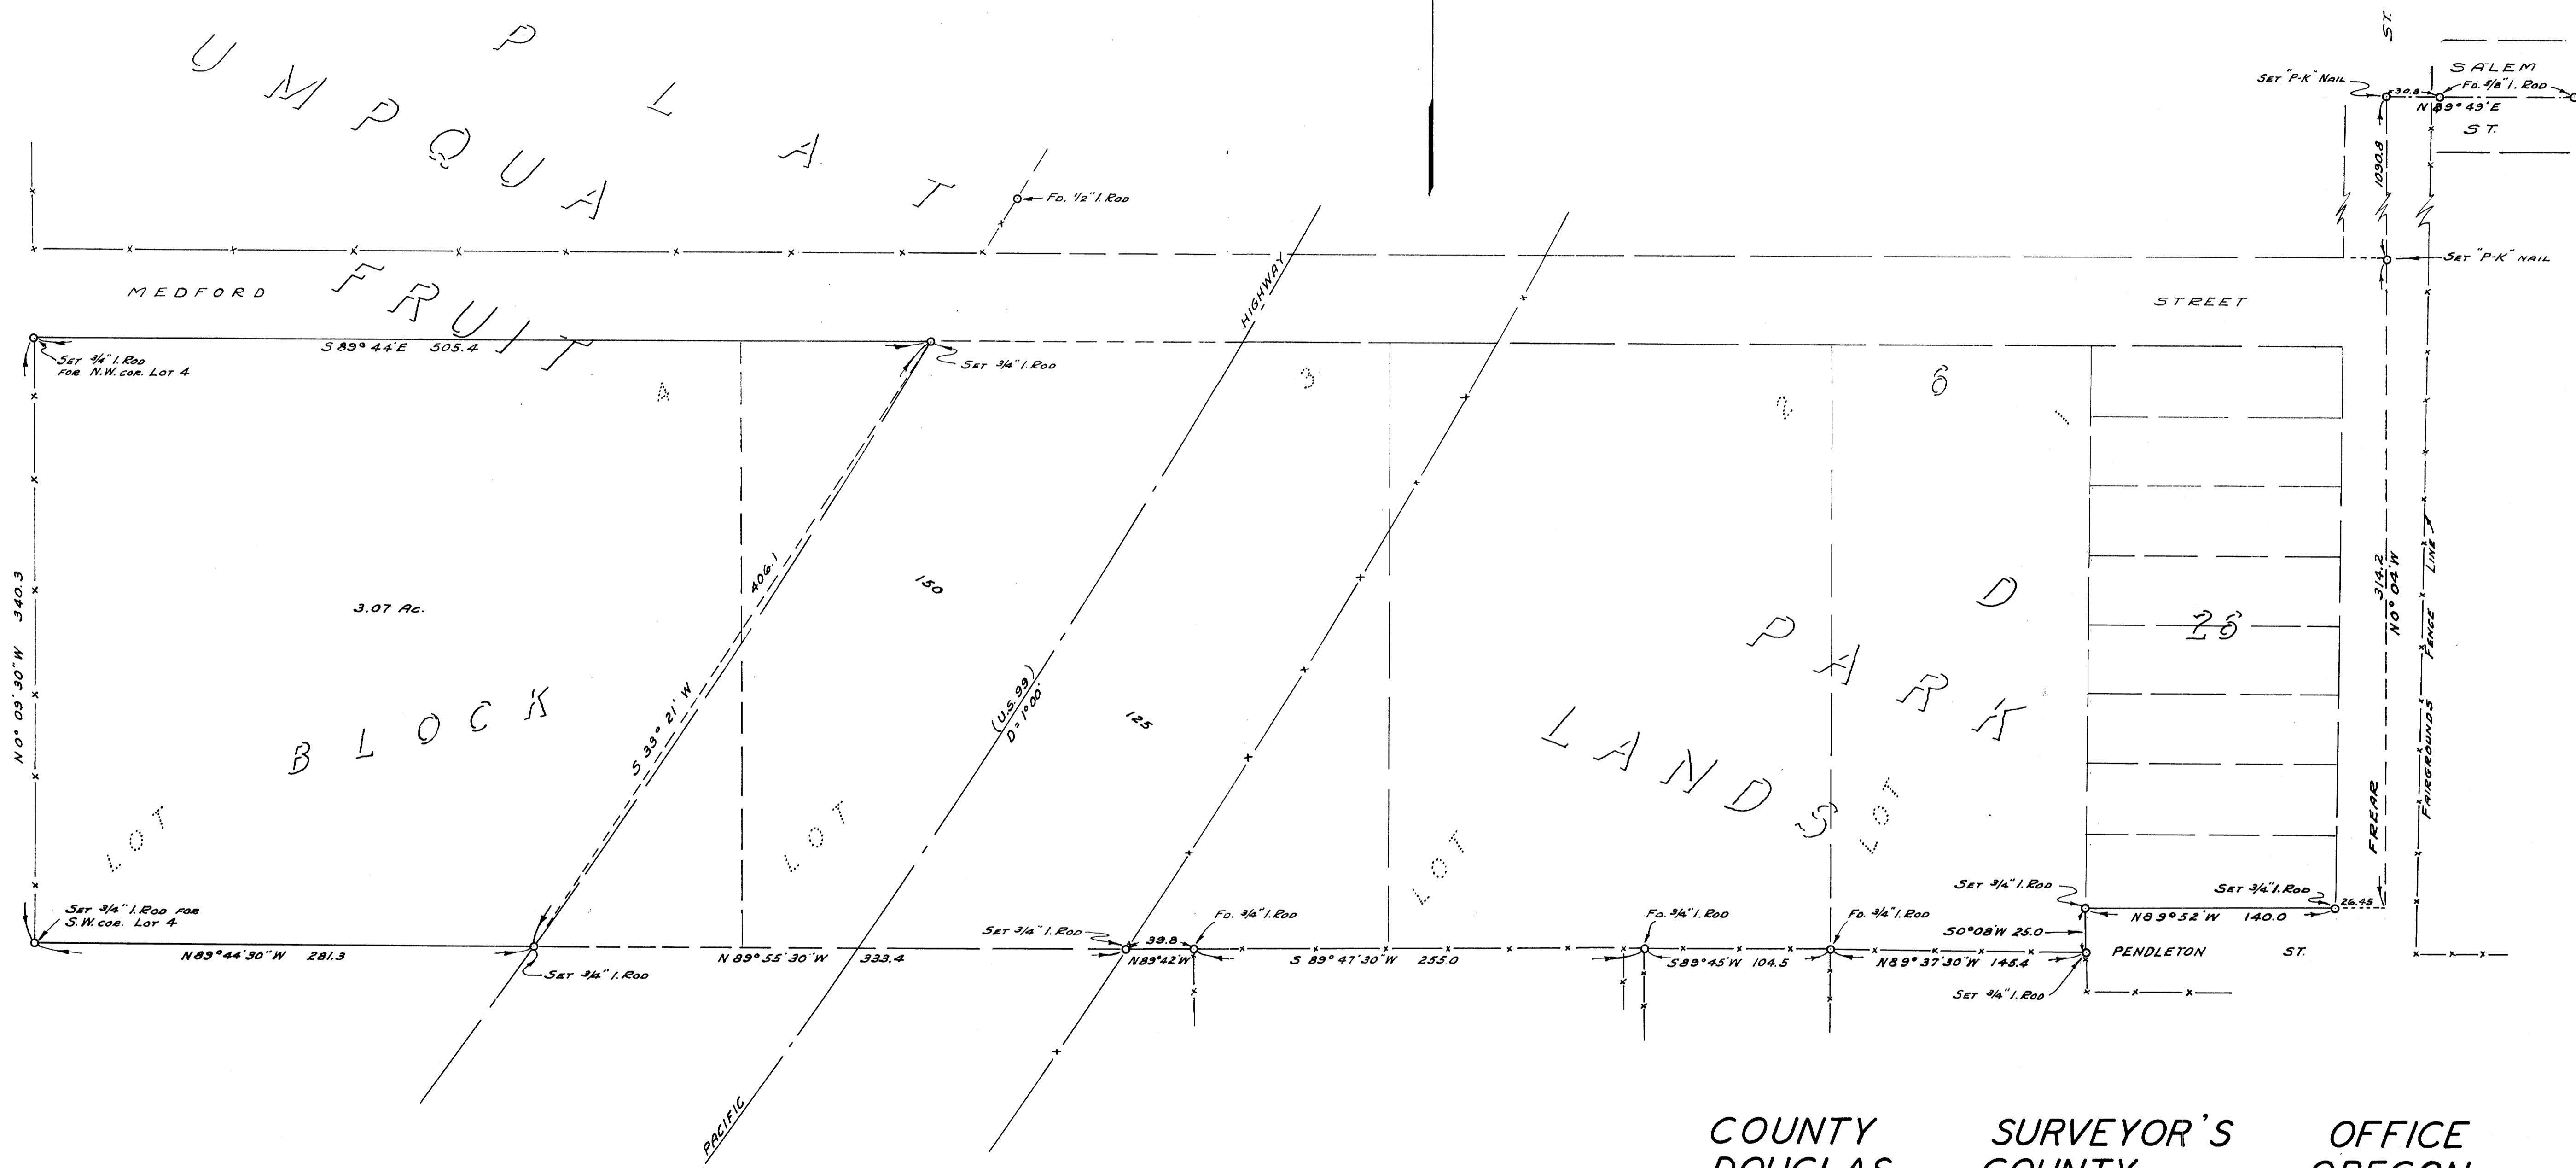


COUNTY SURVEYORS FILE DATA  
DO NOT REMOVE FROM OFFICE

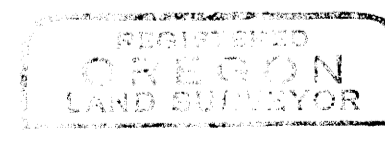

COUNTY SURVEYORS FILE DATA  
DO NOT REMOVE FROM OFFICE

  
 James W. Byron  
 DEPUTY COUNTY SURVEYOR

COUNTY SURVEYOR'S OFFICE  
DOUGLAS COUNTY, OREGON

SURVEY TO ESTABLISH PROPERTY CORNERS.

BEN B. IRVING COUNTY SURVEYOR  
 SURVEYED APRIL, 1955 BY  
 JAMES W. BYRON - DEPUTY SCALE 1" = 50'  
 SURVEYED FOR DOUGLAS COUNTY FAIRBOARD