


COUNTY SURVEYORS FILE NO. 37-164  
DO NOT REMOVE FROM OFFICE

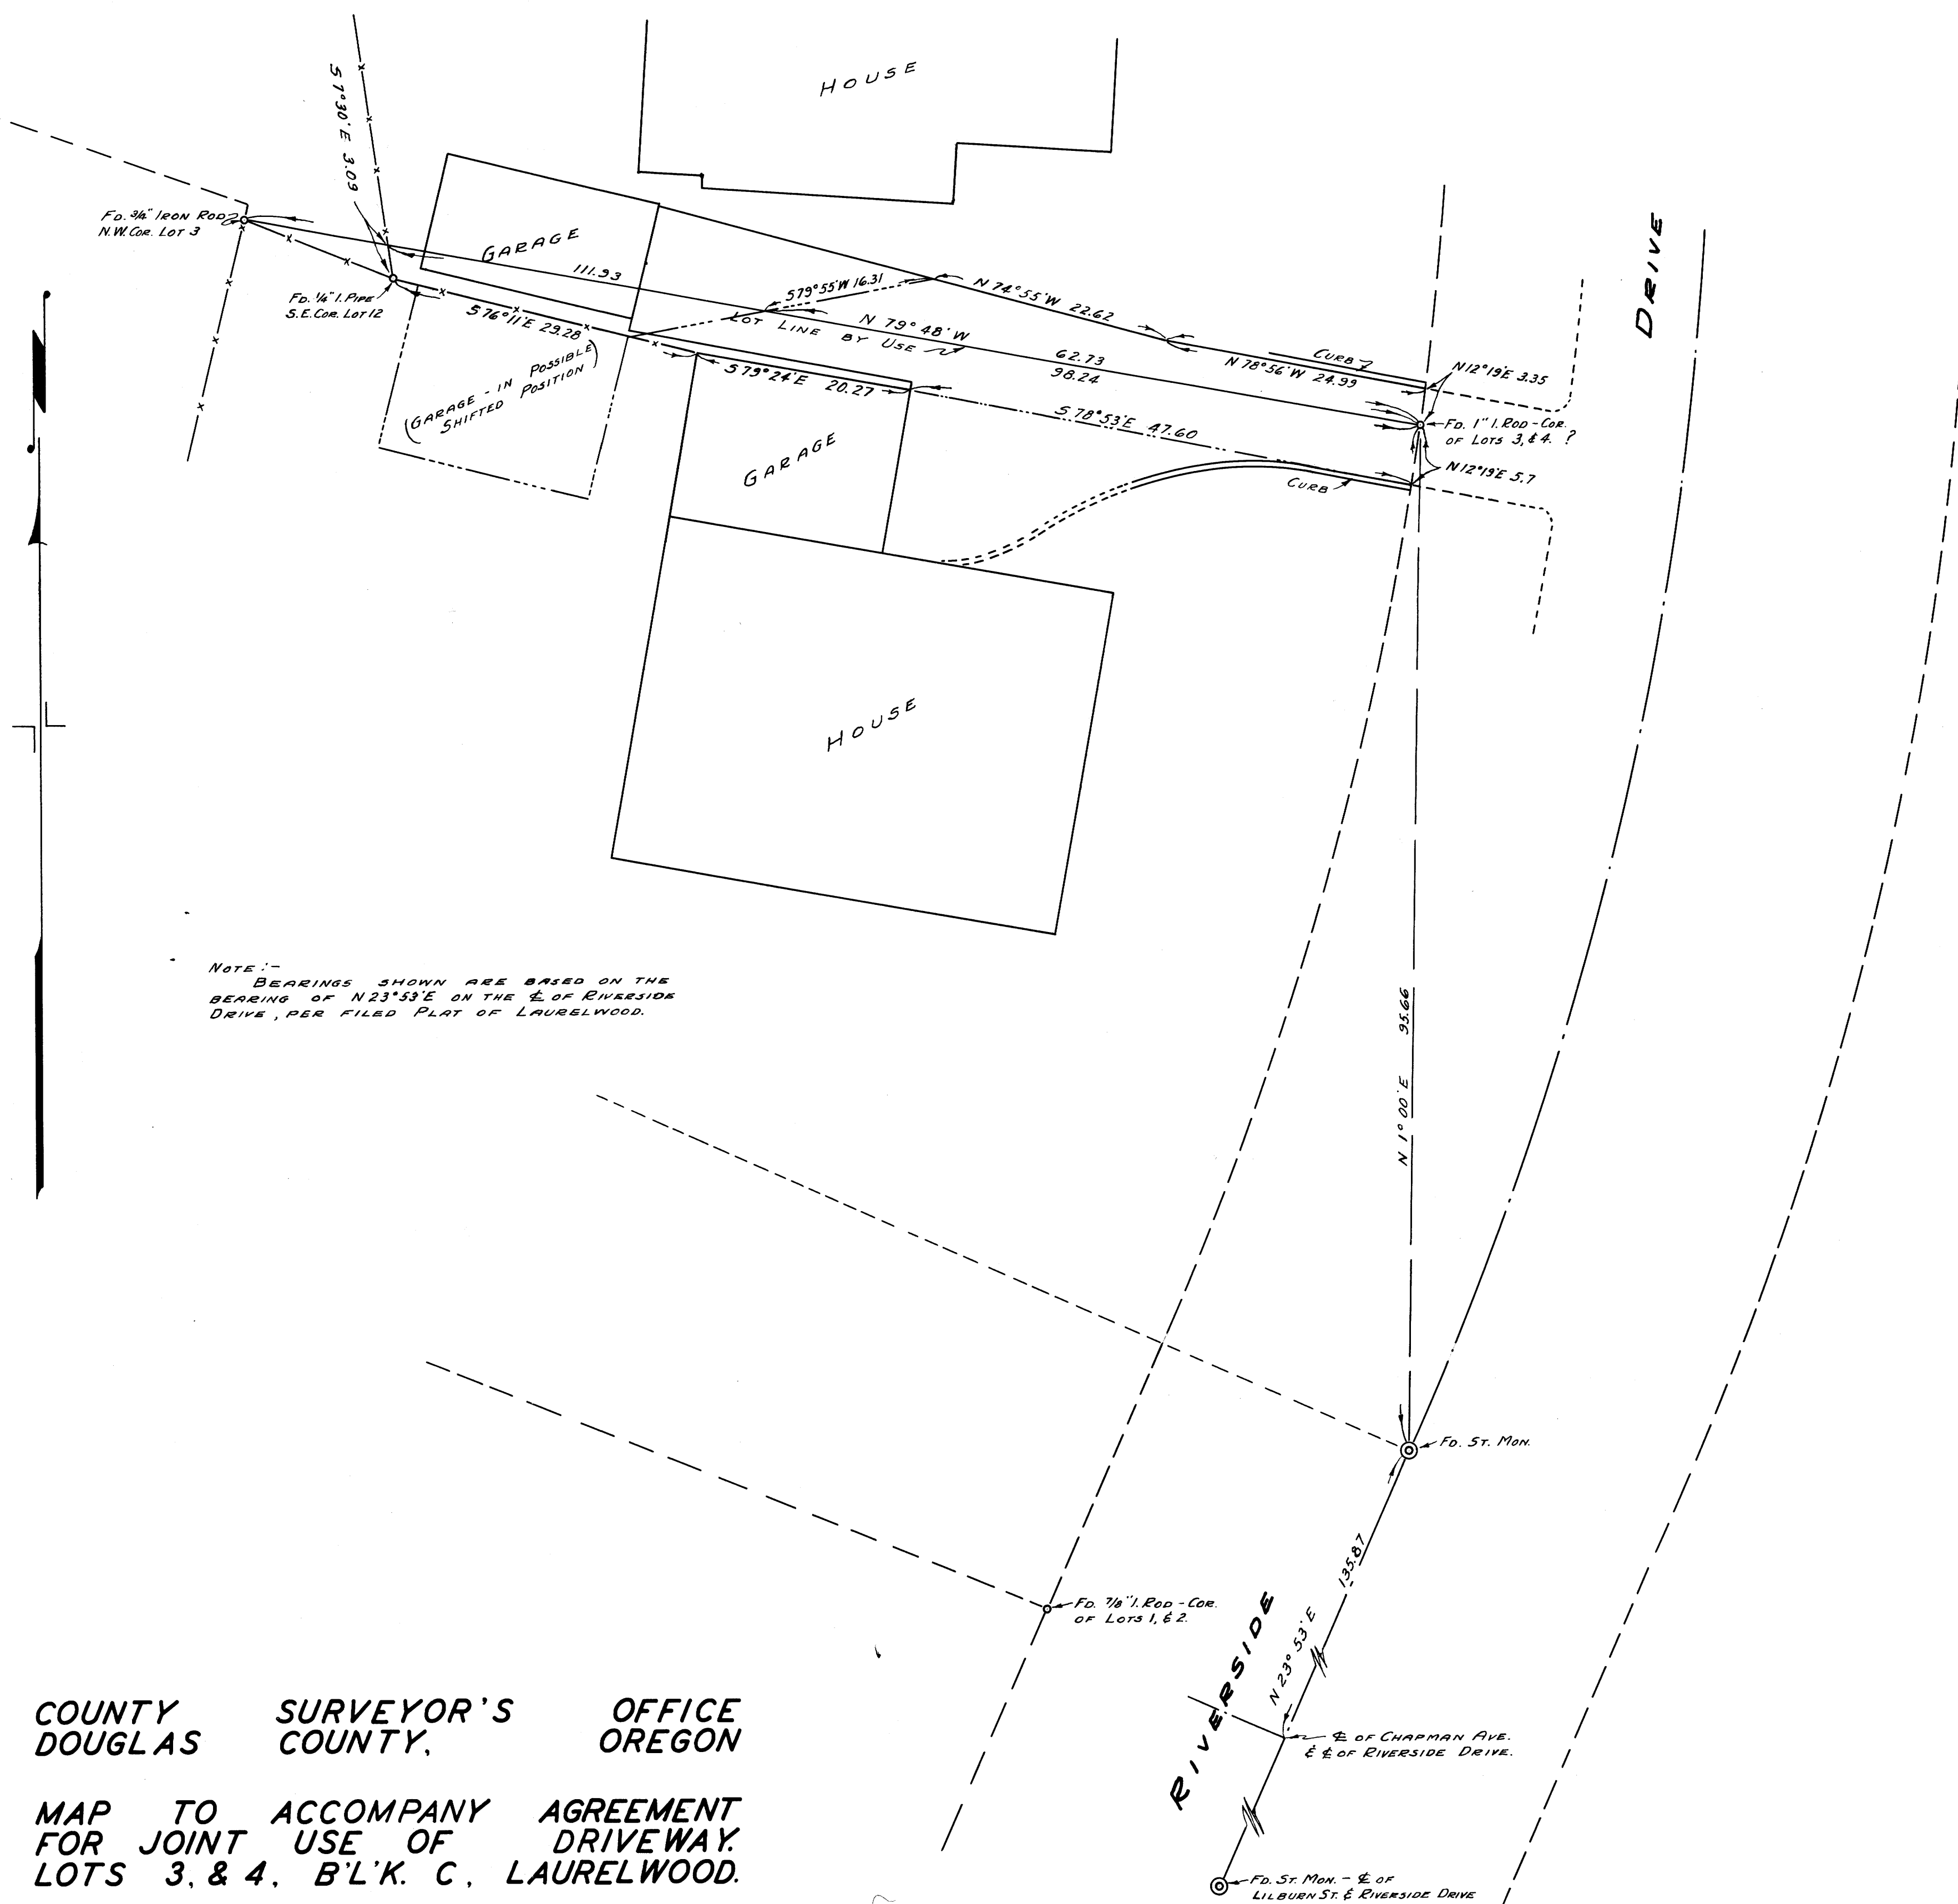

NOTE - BEARINGS SHOWN ARE BASED ON THE BEARING OF  $N 23^{\circ}53'E$  ON THE E. OF RIVERSIDE DRIVE, PER FILED PLAT OF LAURELWOOD.

COUNTY SURVEYOR'S OFFICE  
DOUGLAS COUNTY, OREGON

MAP TO ACCOMPANY AGREEMENT  
FOR JOINT USE OF DRIVEWAY  
LOTS 3, & 4, B'L'K. C, LAURELWOOD.

BEN. B. IRVING COUNTY SURVEYOR  
SURVEYED FEB. 1. 2. 1951 BY  
N. E. RICHARDSON DEPUTY

SCALE 1"=10'

REGISTERED  
OREGON  
LAND SURVEYOR  
N. E. Richardson  
JULY 7 1944  
N. E. RICHARDSON  
S.P.

COUNTY SURVEYORS FILE NO. 37-164  
DO NOT REMOVE FROM OFFICE