
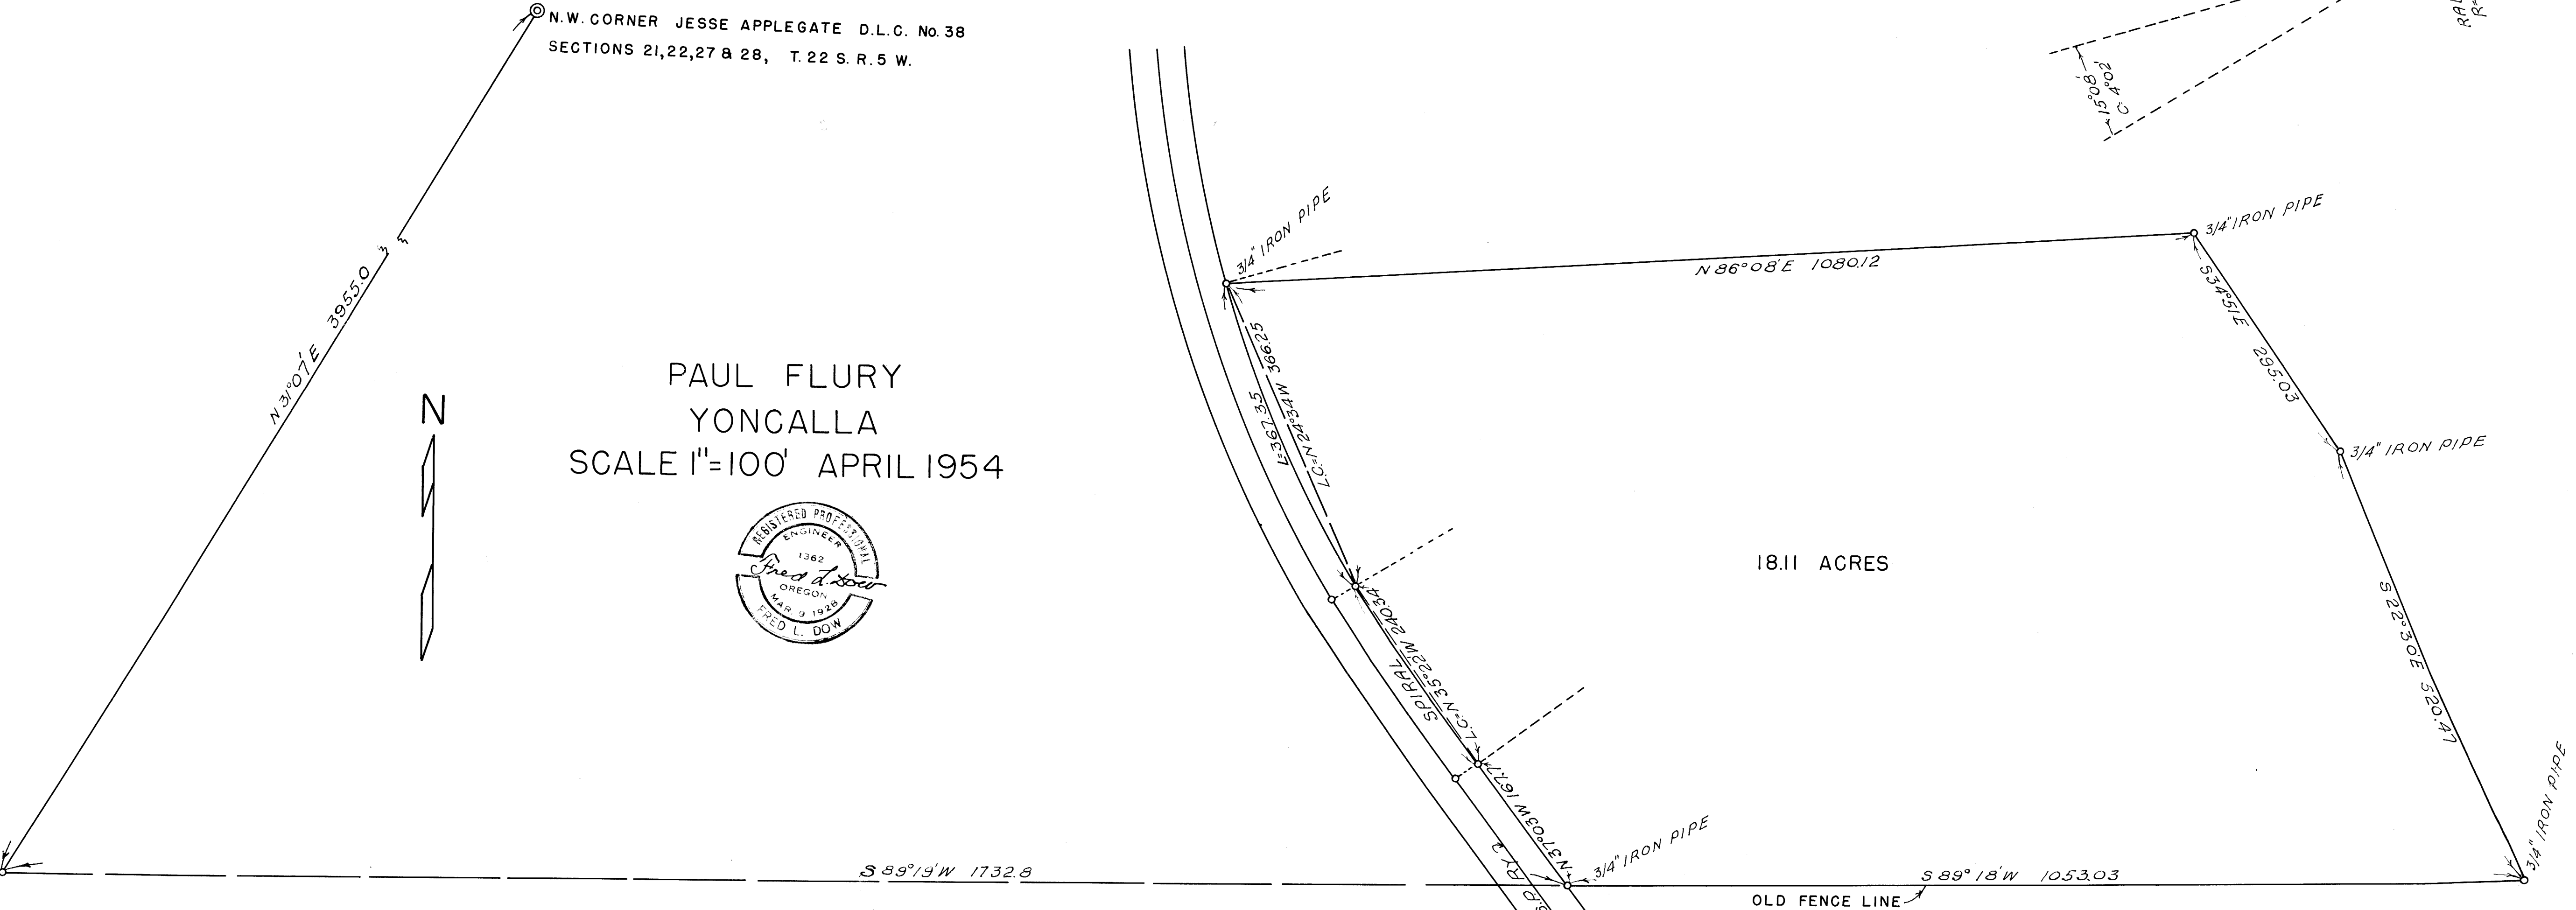


DO NOT REMOVE FROM FILE

N.W. CORNER JESSE APPLGATE D.L.C. No. 38
SECTIONS 21, 22, 27 & 28, T. 22 S. R. 5 W.

PAUL FLURY
YONGALLA
SCALE 1"=100' APRIL 1954

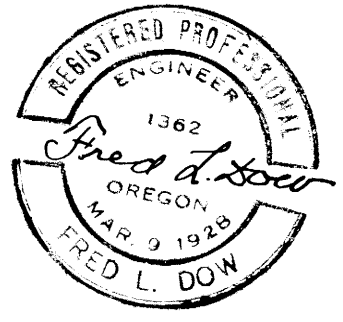

18.11 ACRES

OLD FENCE LINE

FILED
RECEIVED

MAR 21 1958

COUNTY SURVEYOR
DOUGLAS COUNTY, ORE.

COUNTY SURVEYOR
DO NOT REMOVE FROM FILE

MAP FILE M8-68